


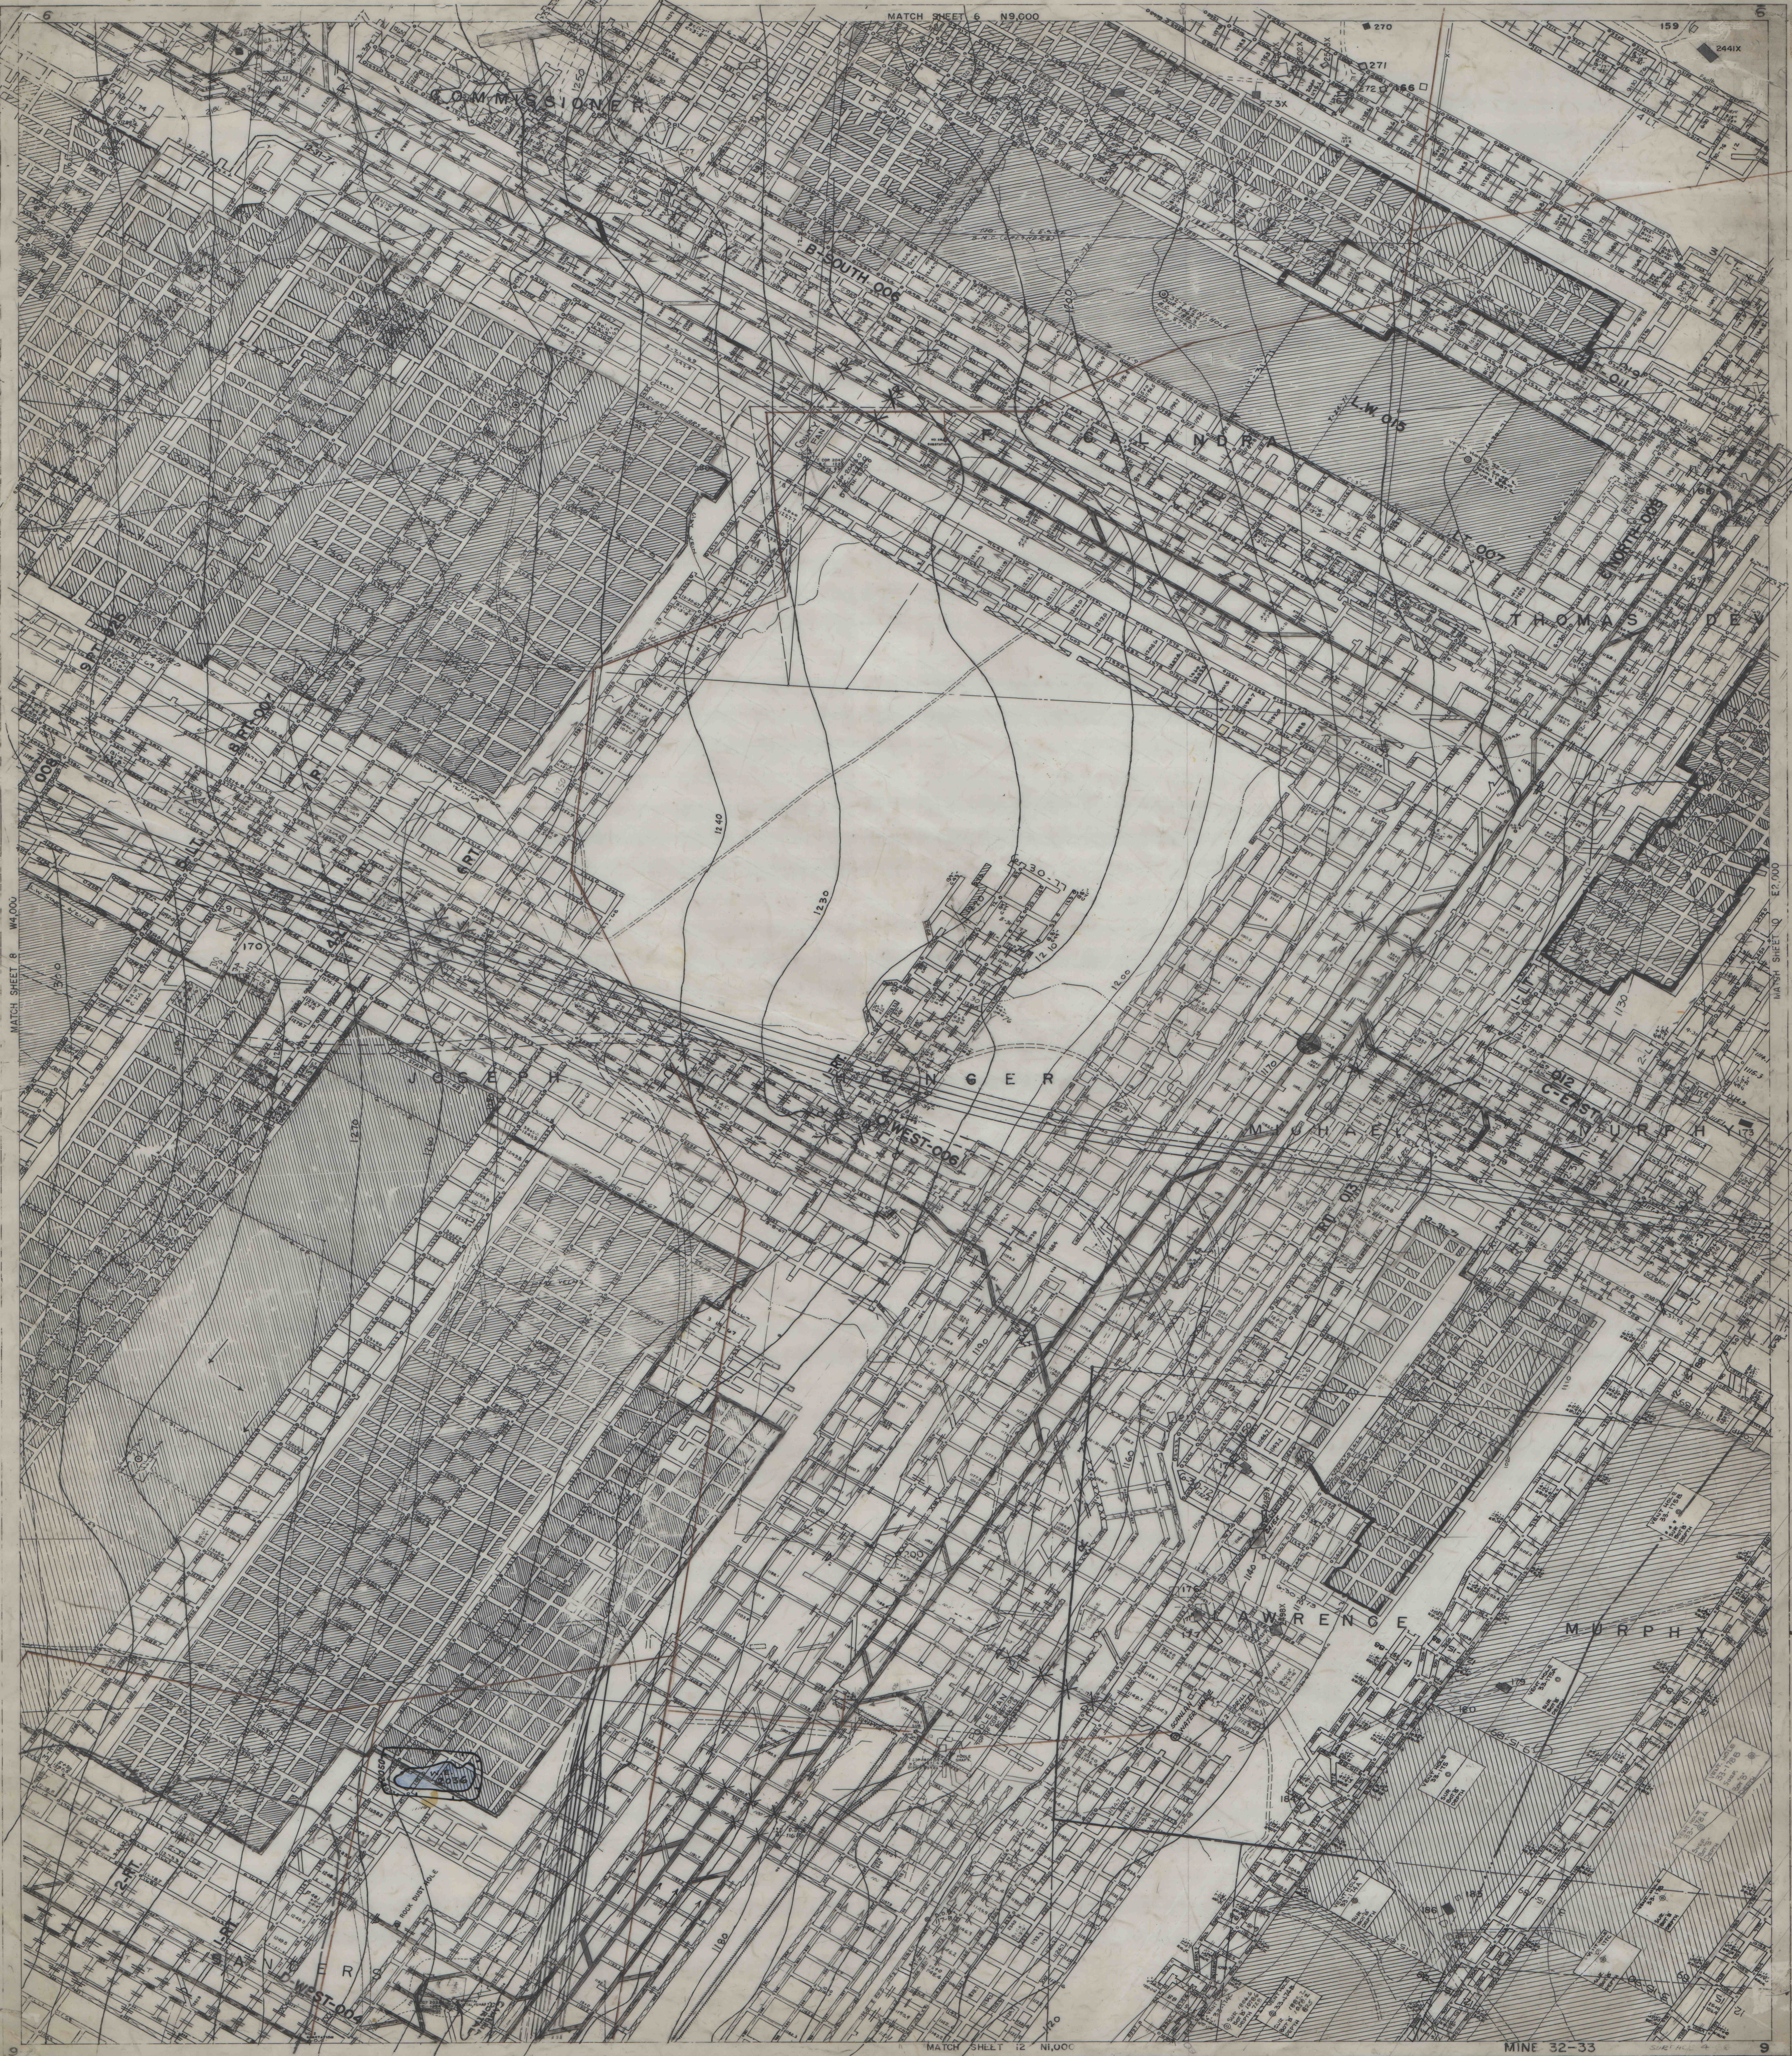

MATCH SHEET 6 N9,000

MATCH SHEET 12 N1,000

MATCH SHEET 12 N1,000

MINE 32-33

REVISED 1-86