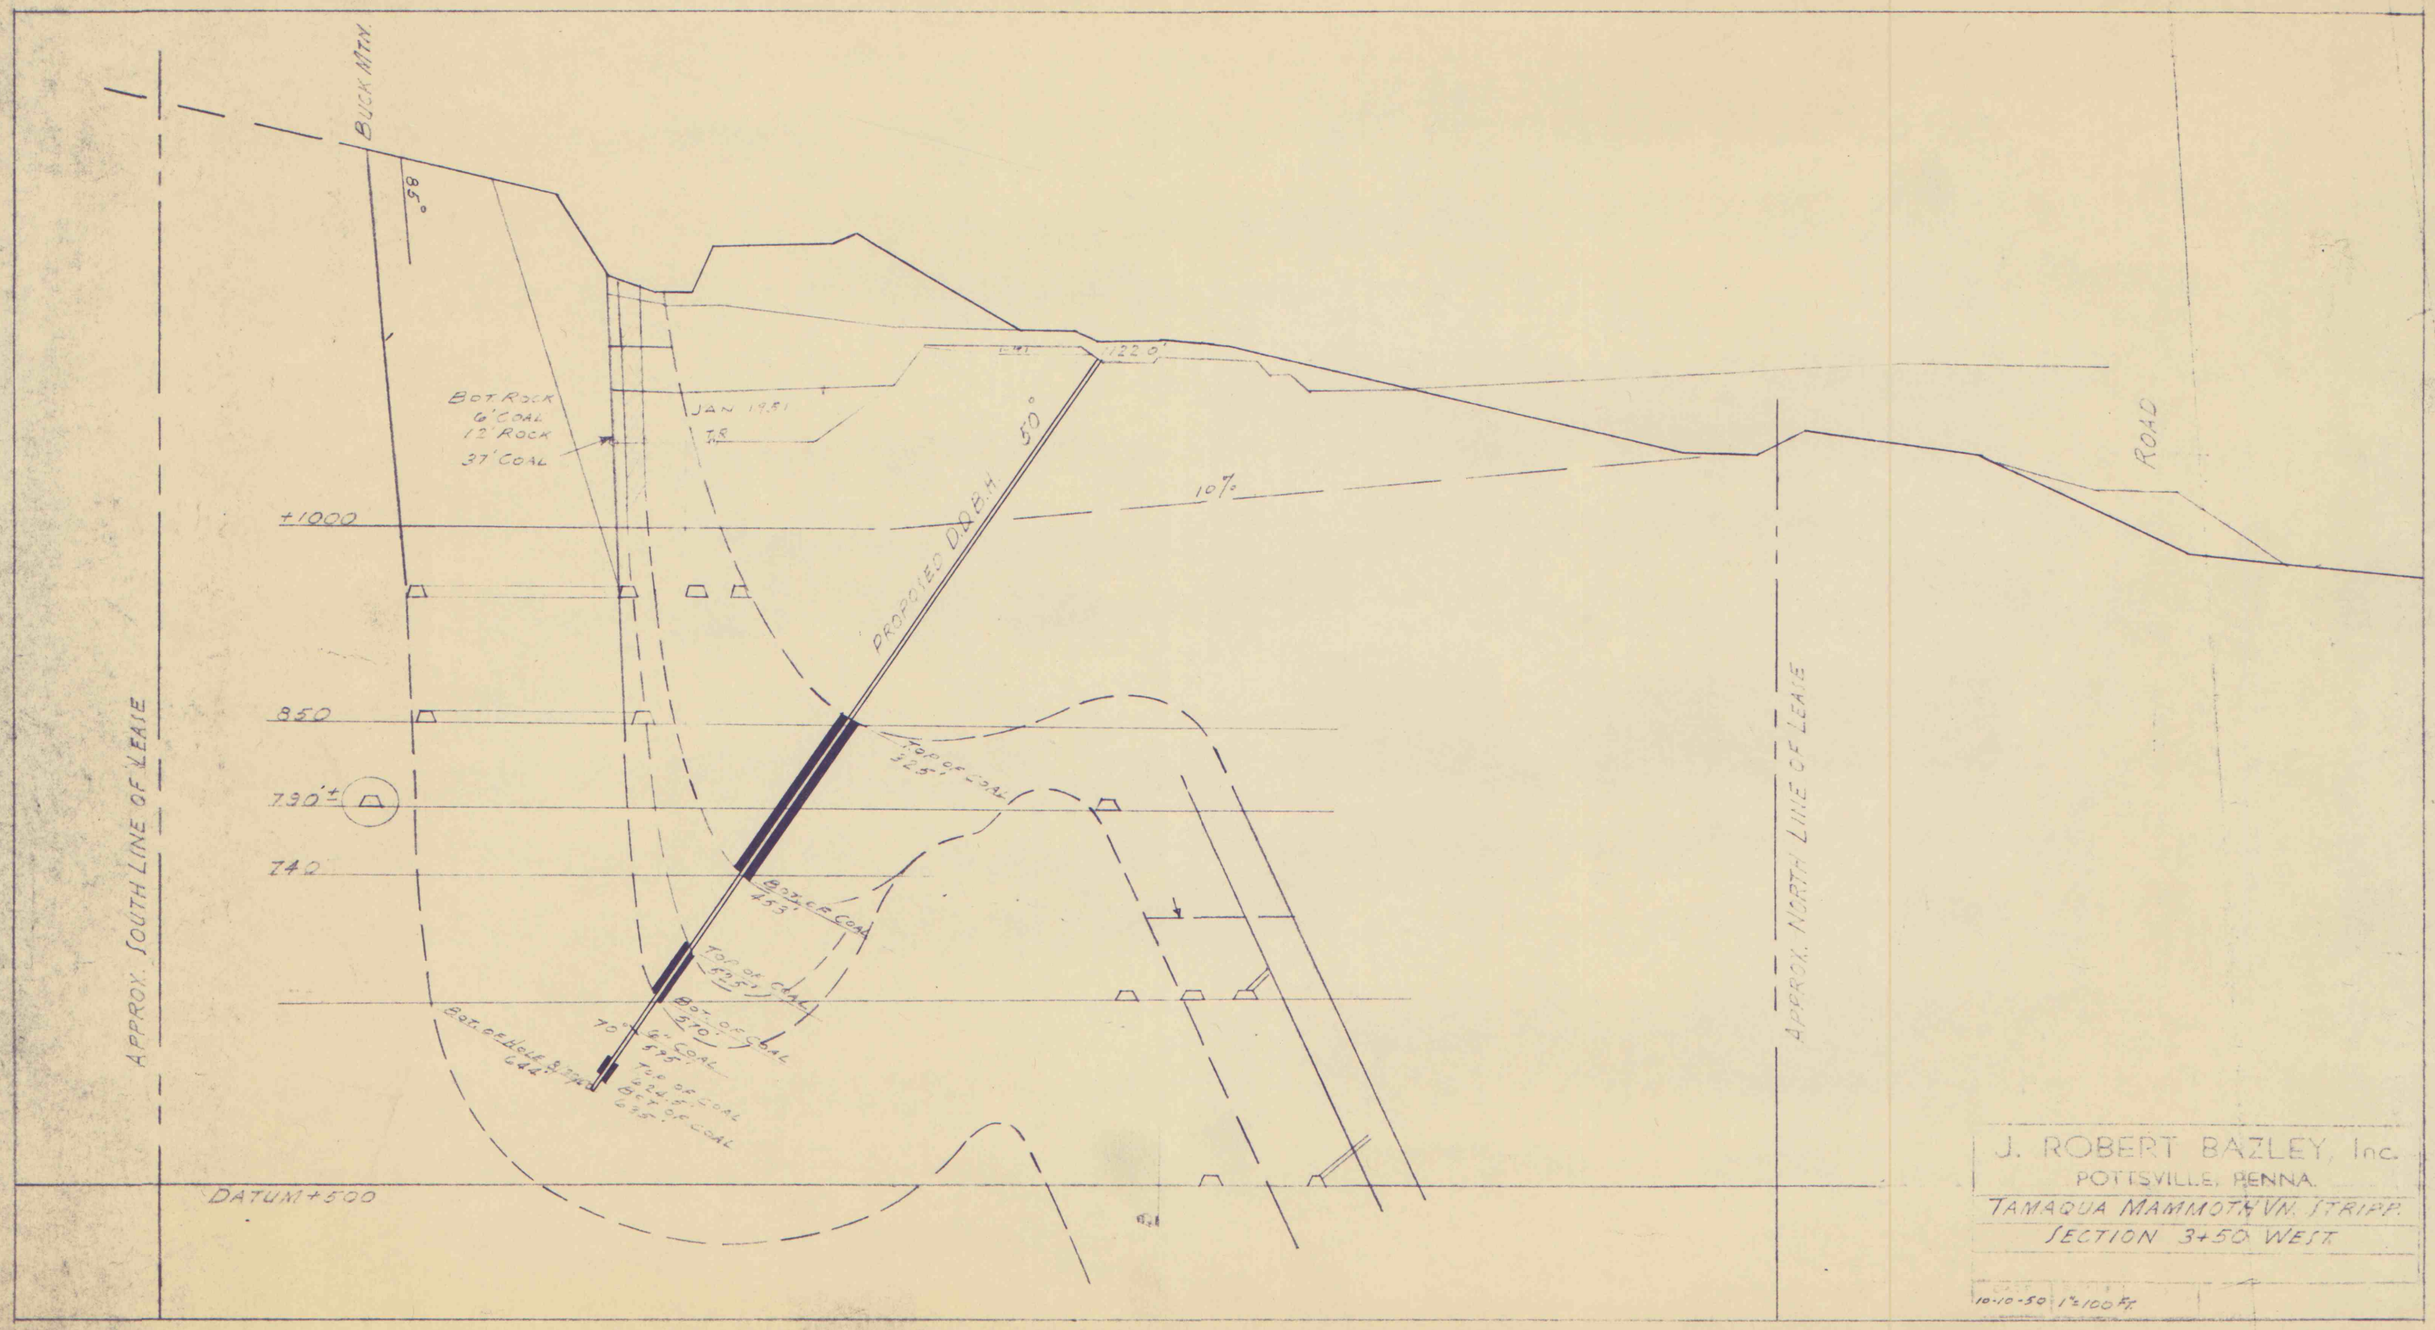
BUCK MTN.
85°
BOT ROCK
6' COAL
12' ROCK
37' COAL
JAN 1951
7.8
1122.0
50°
PROPOSED D.D.B.H.
10%
ROAD
+1000
850
730'±
740
DATUM +500
APPROX. SOUTH LINE OF LEASE
APPROX. NORTH LINE OF LEASE
TOP OF COAL
BOT OF COAL
BOREHOLE
J. ROBERT BAZLEY, Inc.
POTTSVILLE, PENNA.
TAMAQUA MAMMOTH VN. STRIPP.
SECTION 3+50 WEST
10-10-50
1" = 100 FT.