


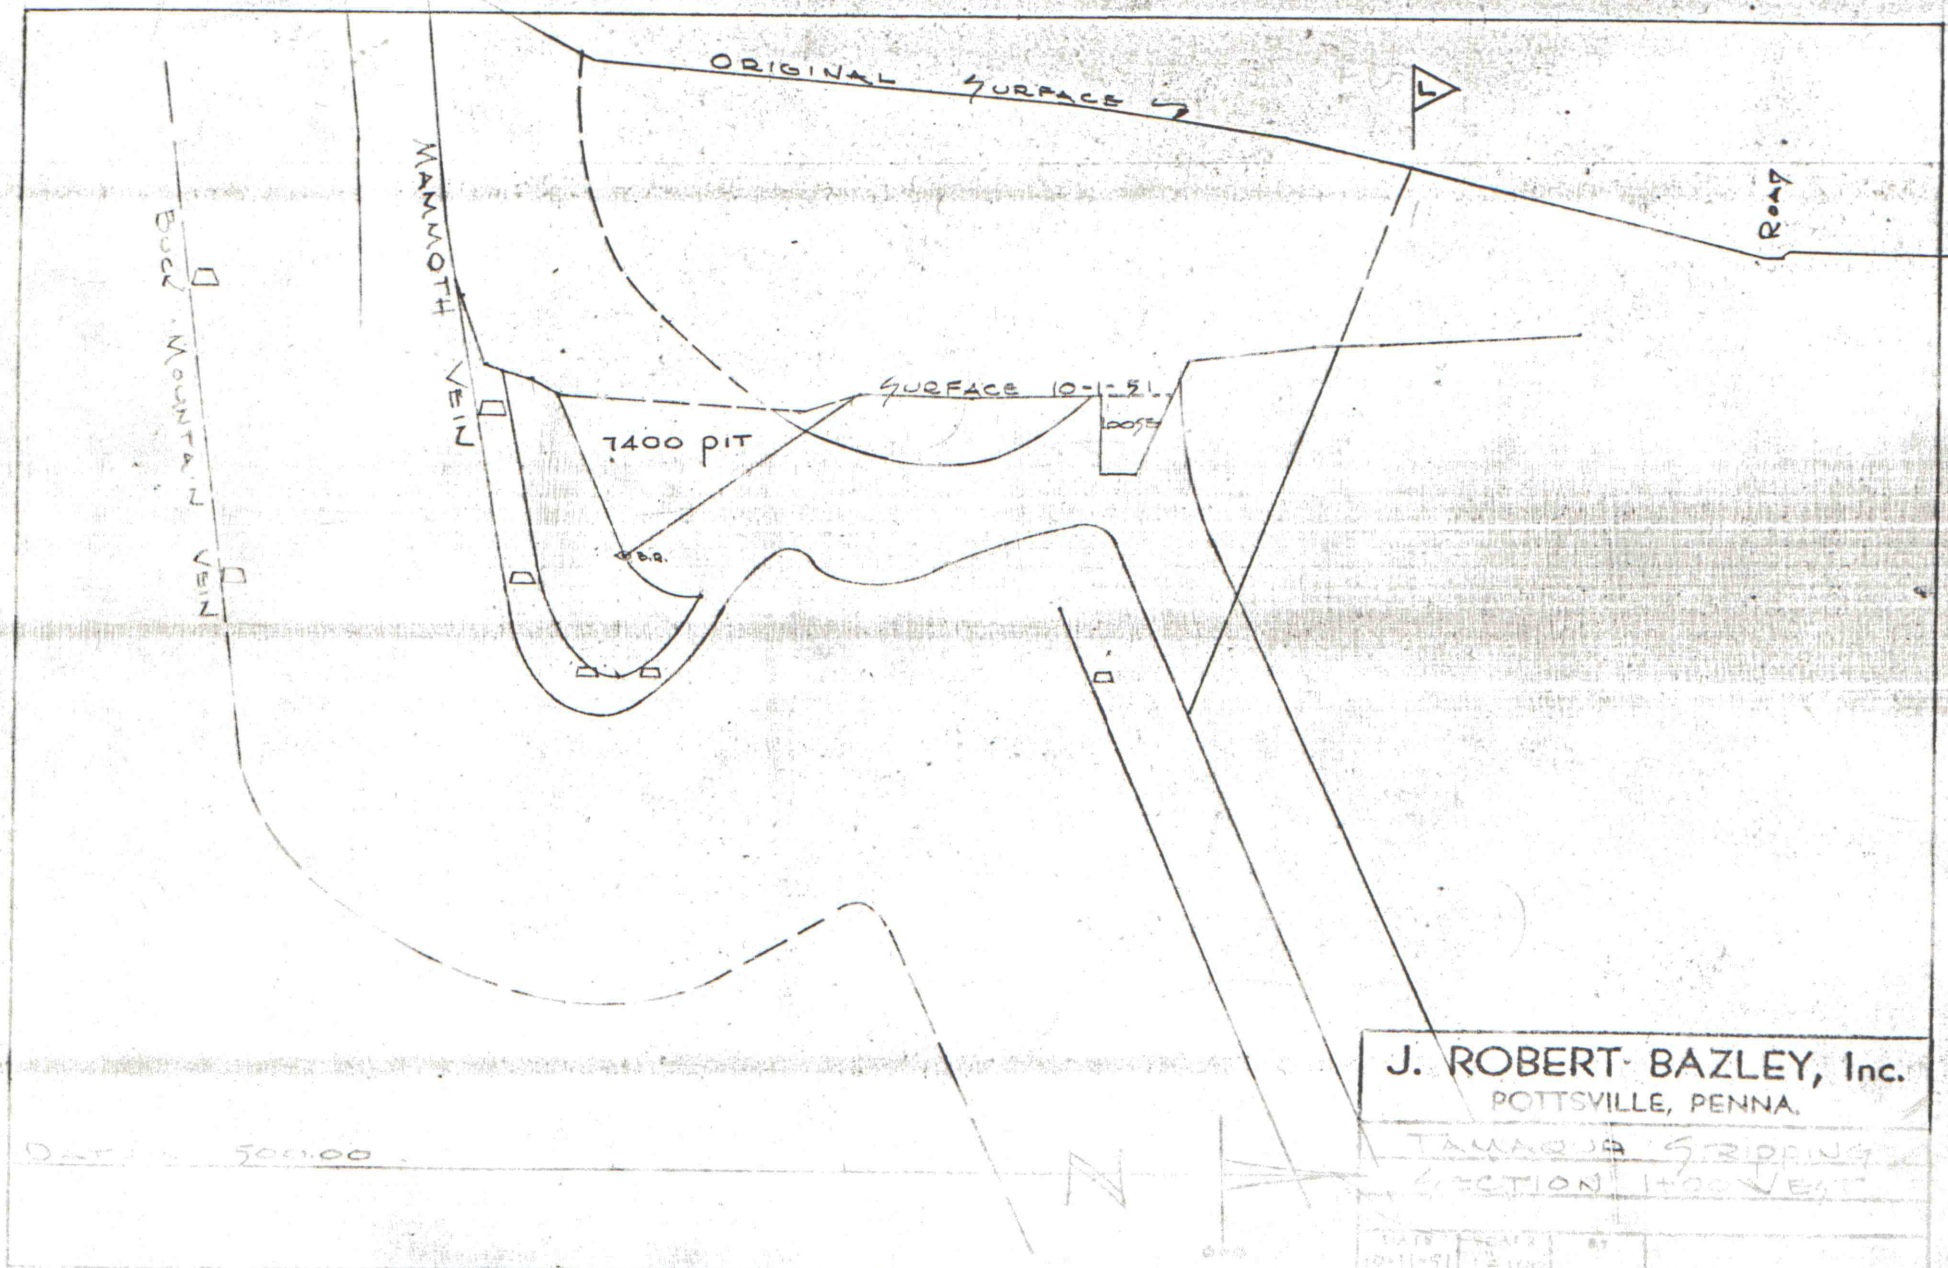

DATE 500.00

J. ROBERT BAZLEY, Inc.		
POTTSVILLE, PENNA.		
SECTION 1+20 WEST		
DATE	SCALE	BY
10-1-51	1:200	