


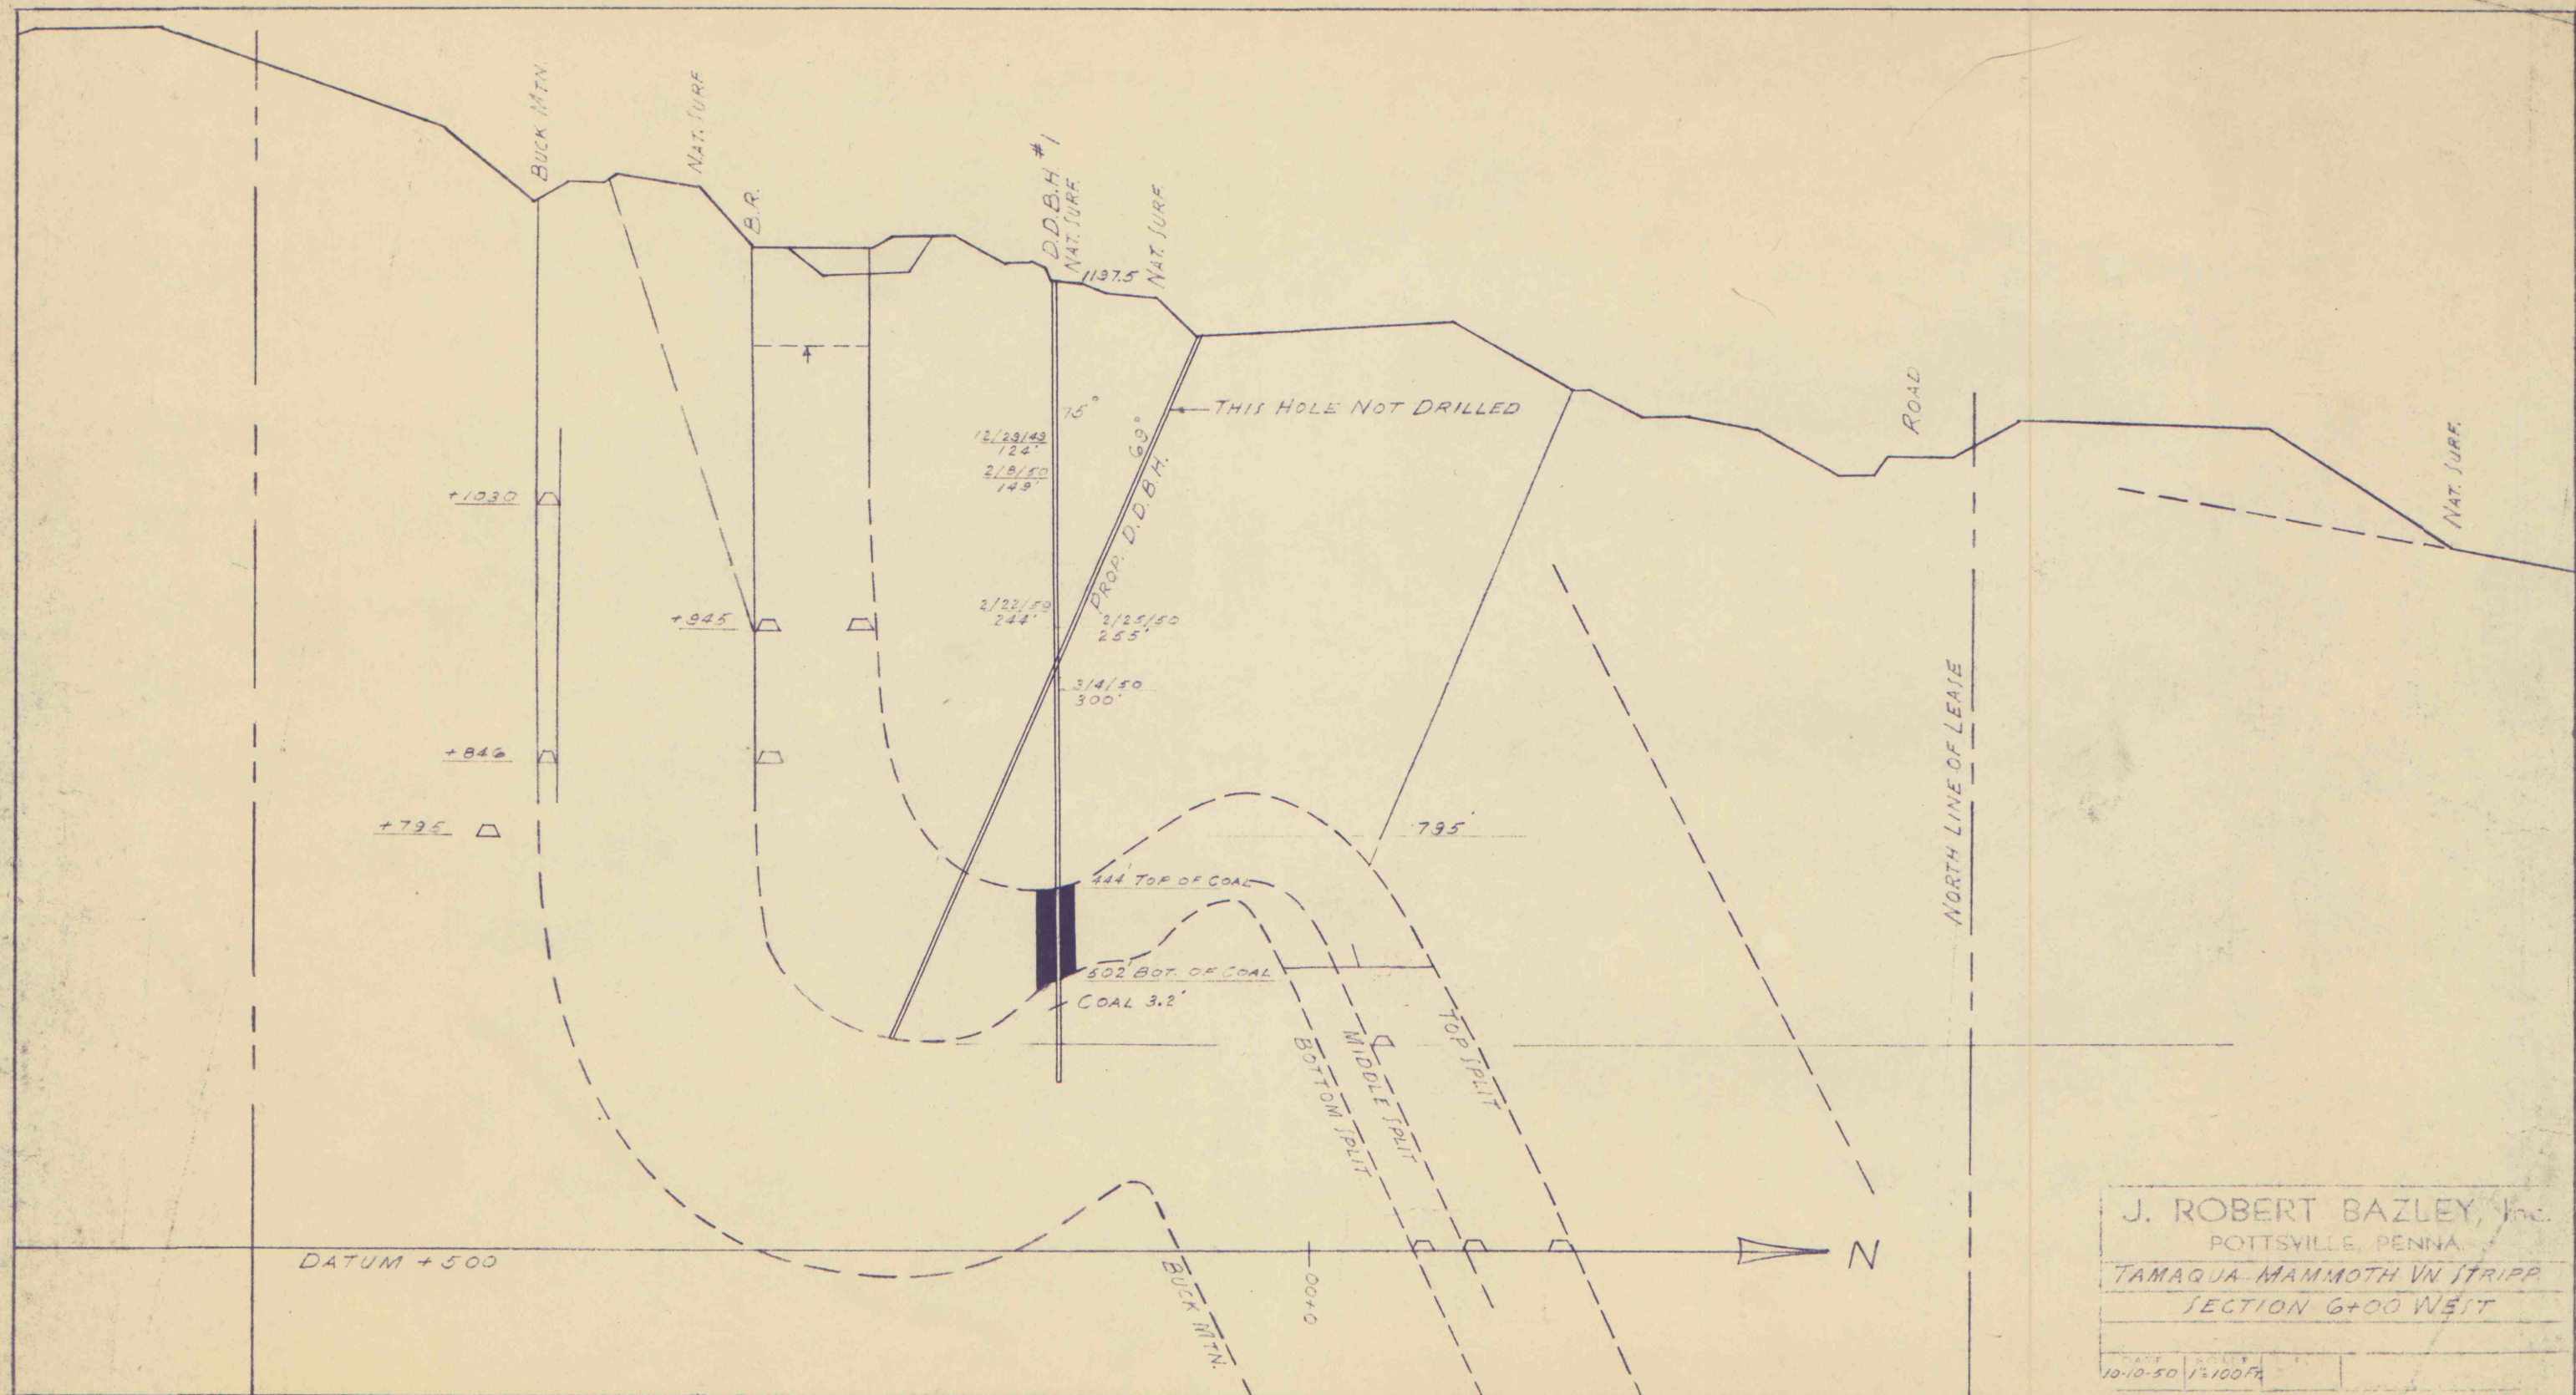

J. ROBERT BAZLEY, Inc.
POTTSVILLE, PENNA.
TAMAQUA-MAMMOTH VN STRIPP
SECTION 6+00 WEST

DATE	SHEET
10-10-50	15/100F