


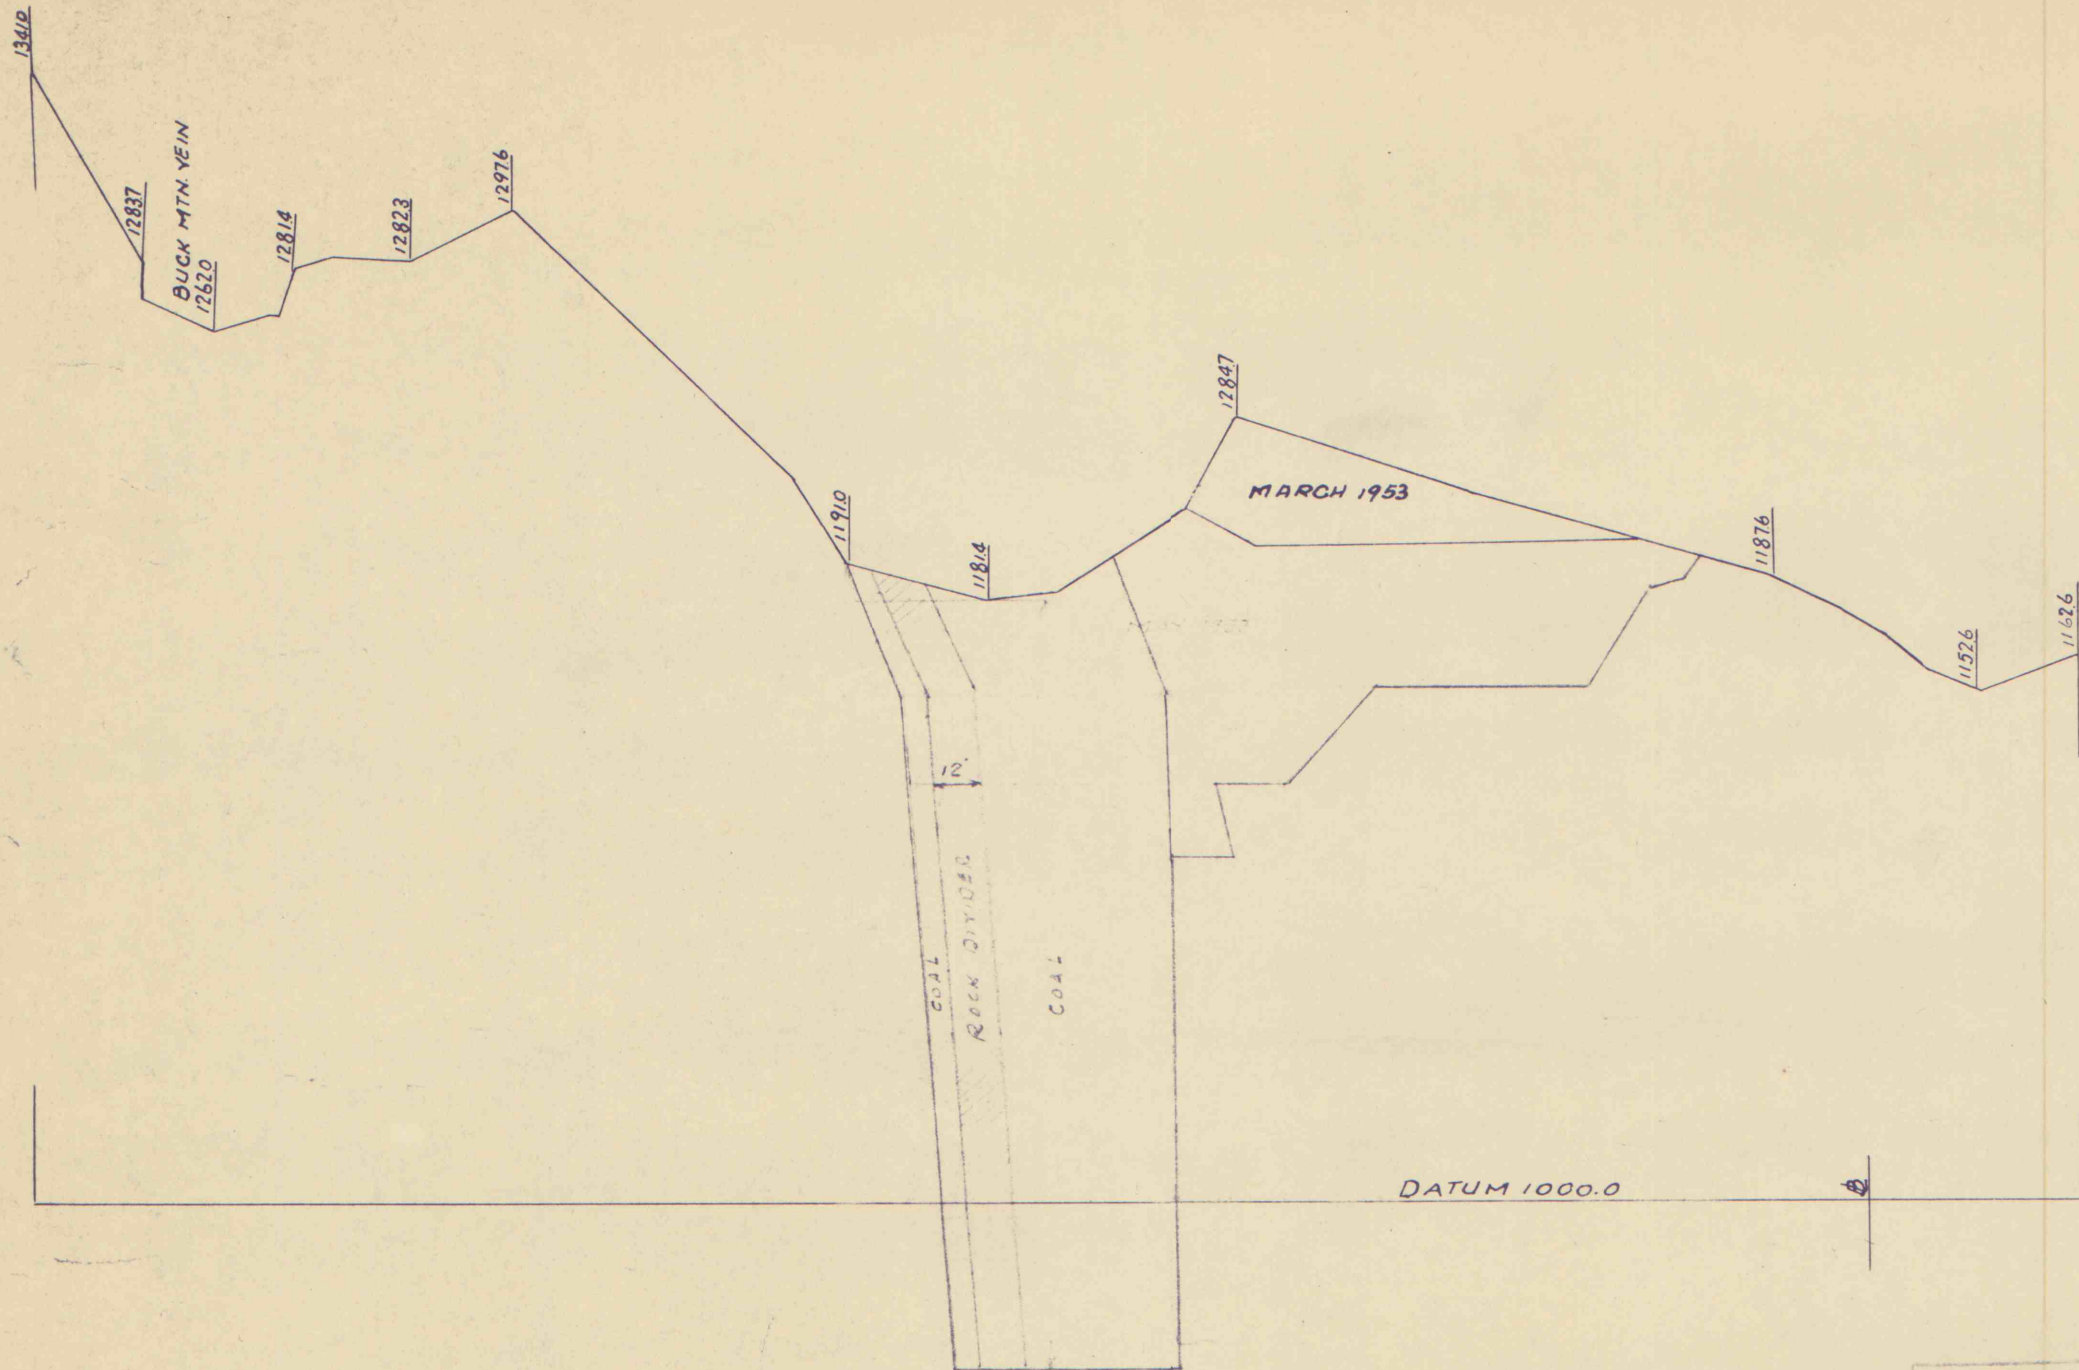

J. ROBERT BAZLEY, Inc.		
POTTSVILLE, PENNA.		
ASHTON SOUTH SIDE		
STRIPPING		
SECTION 13+00 WEST		
DATE	SCALE	BY
4-53	1"=50'	T-3