


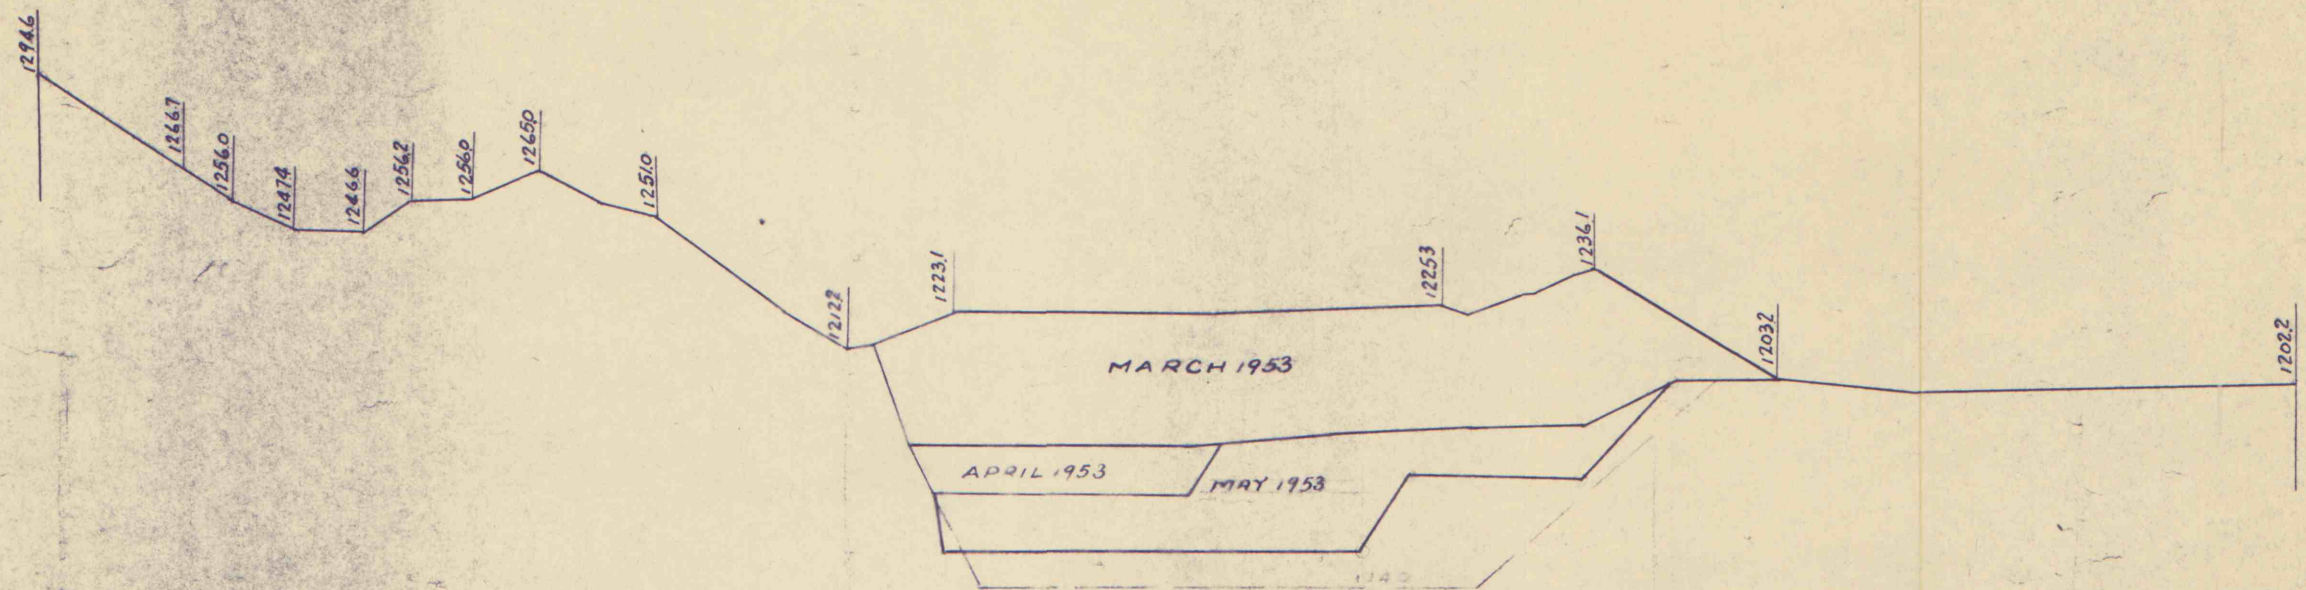

DATUM 1000



J. ROBERT BAZLEY, Inc.			
POTTSVILLE, PENNA.			
ASHTON SOUTH SIDE			
STRIPPING			
SECTION 11+00 WEST			
DATE	SCALE	BY	DRG. NO.
5-26-53	1"=50'		