


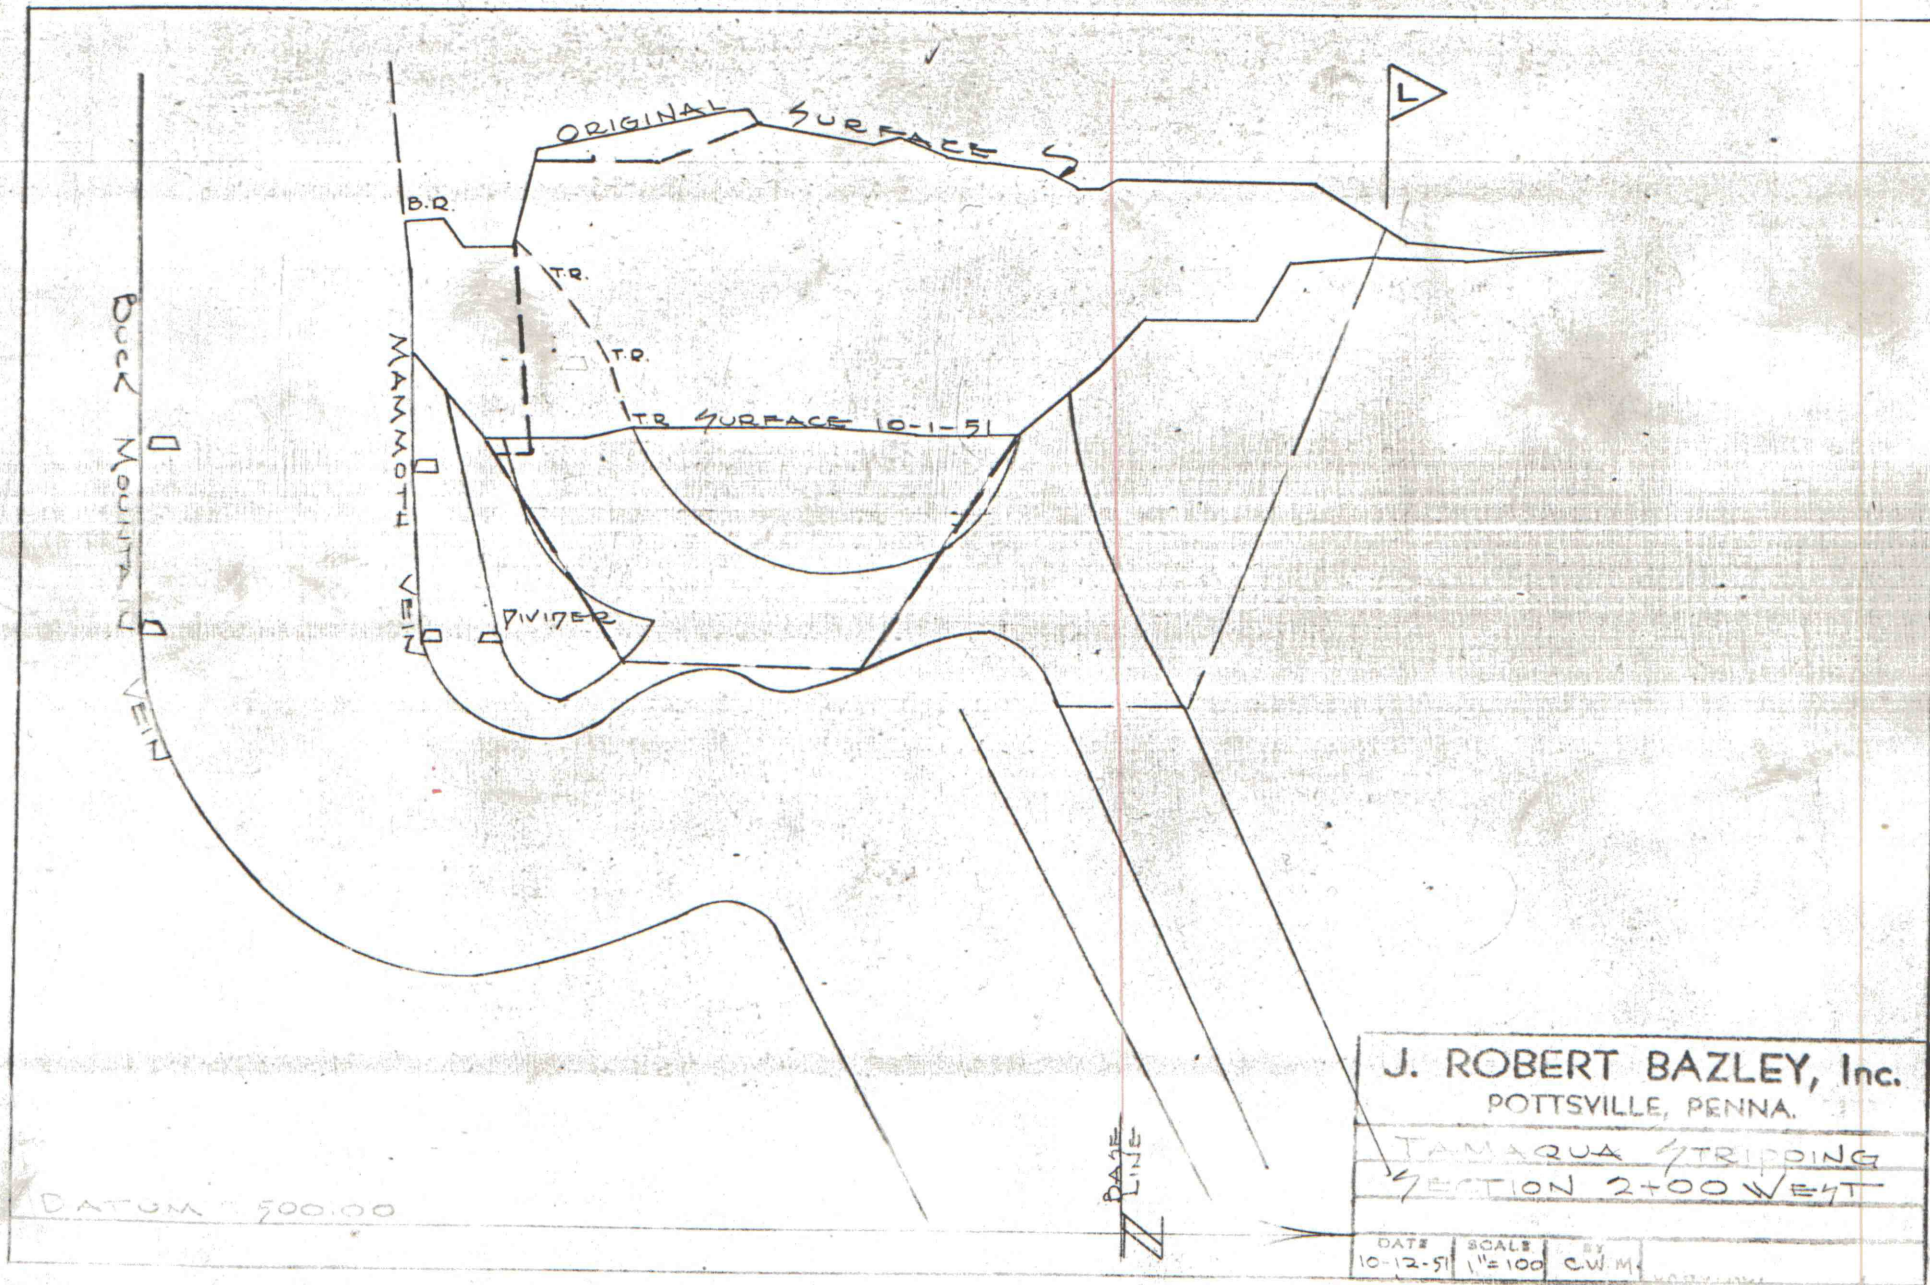

J. ROBERT BAZLEY, Inc.
POTTSVILLE, PENNA.

TAMAQUA STRIPPING
SECTION 2+00 WEST

DATE	SCALE	BY
10-12-51	1"=100'	C.W.M.