


COAL CORPORATION

Scale 1" = 400' - MAKE 1" = 100'
1" = 200' TRACINGS

EASTERN ASSOCIATED COAL CORPORATION

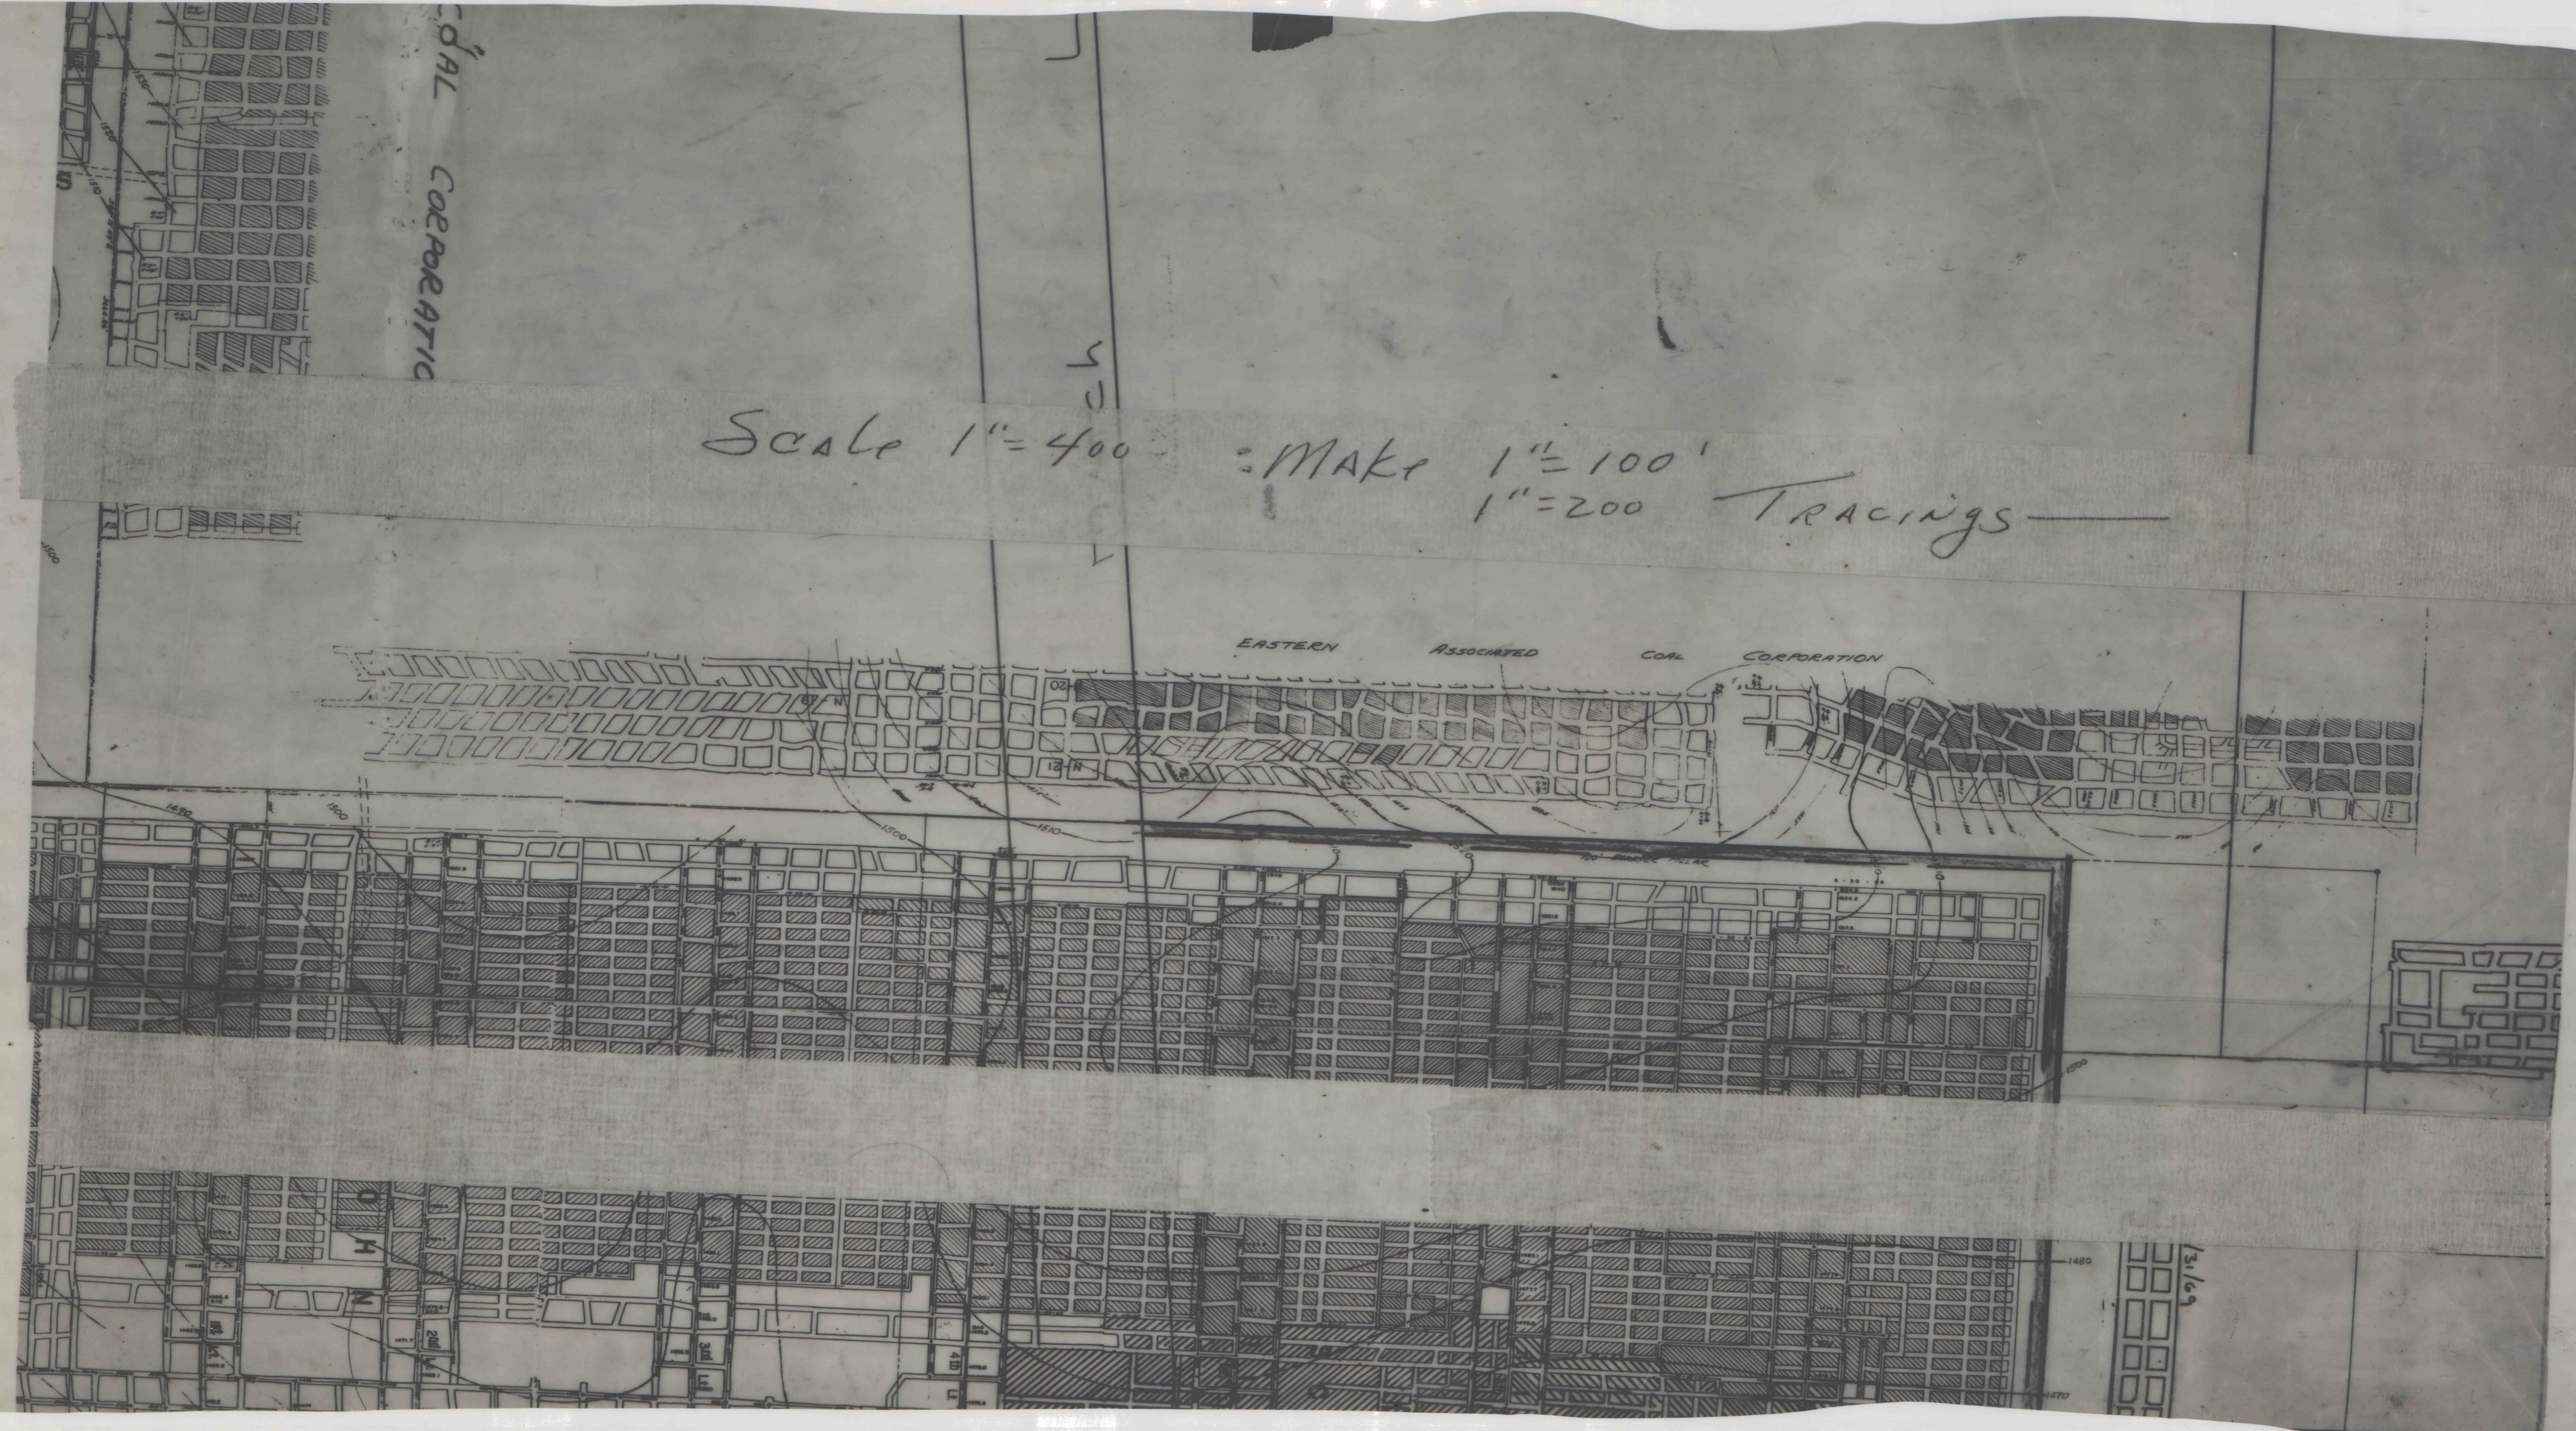

SCALE: 1" = 200'