


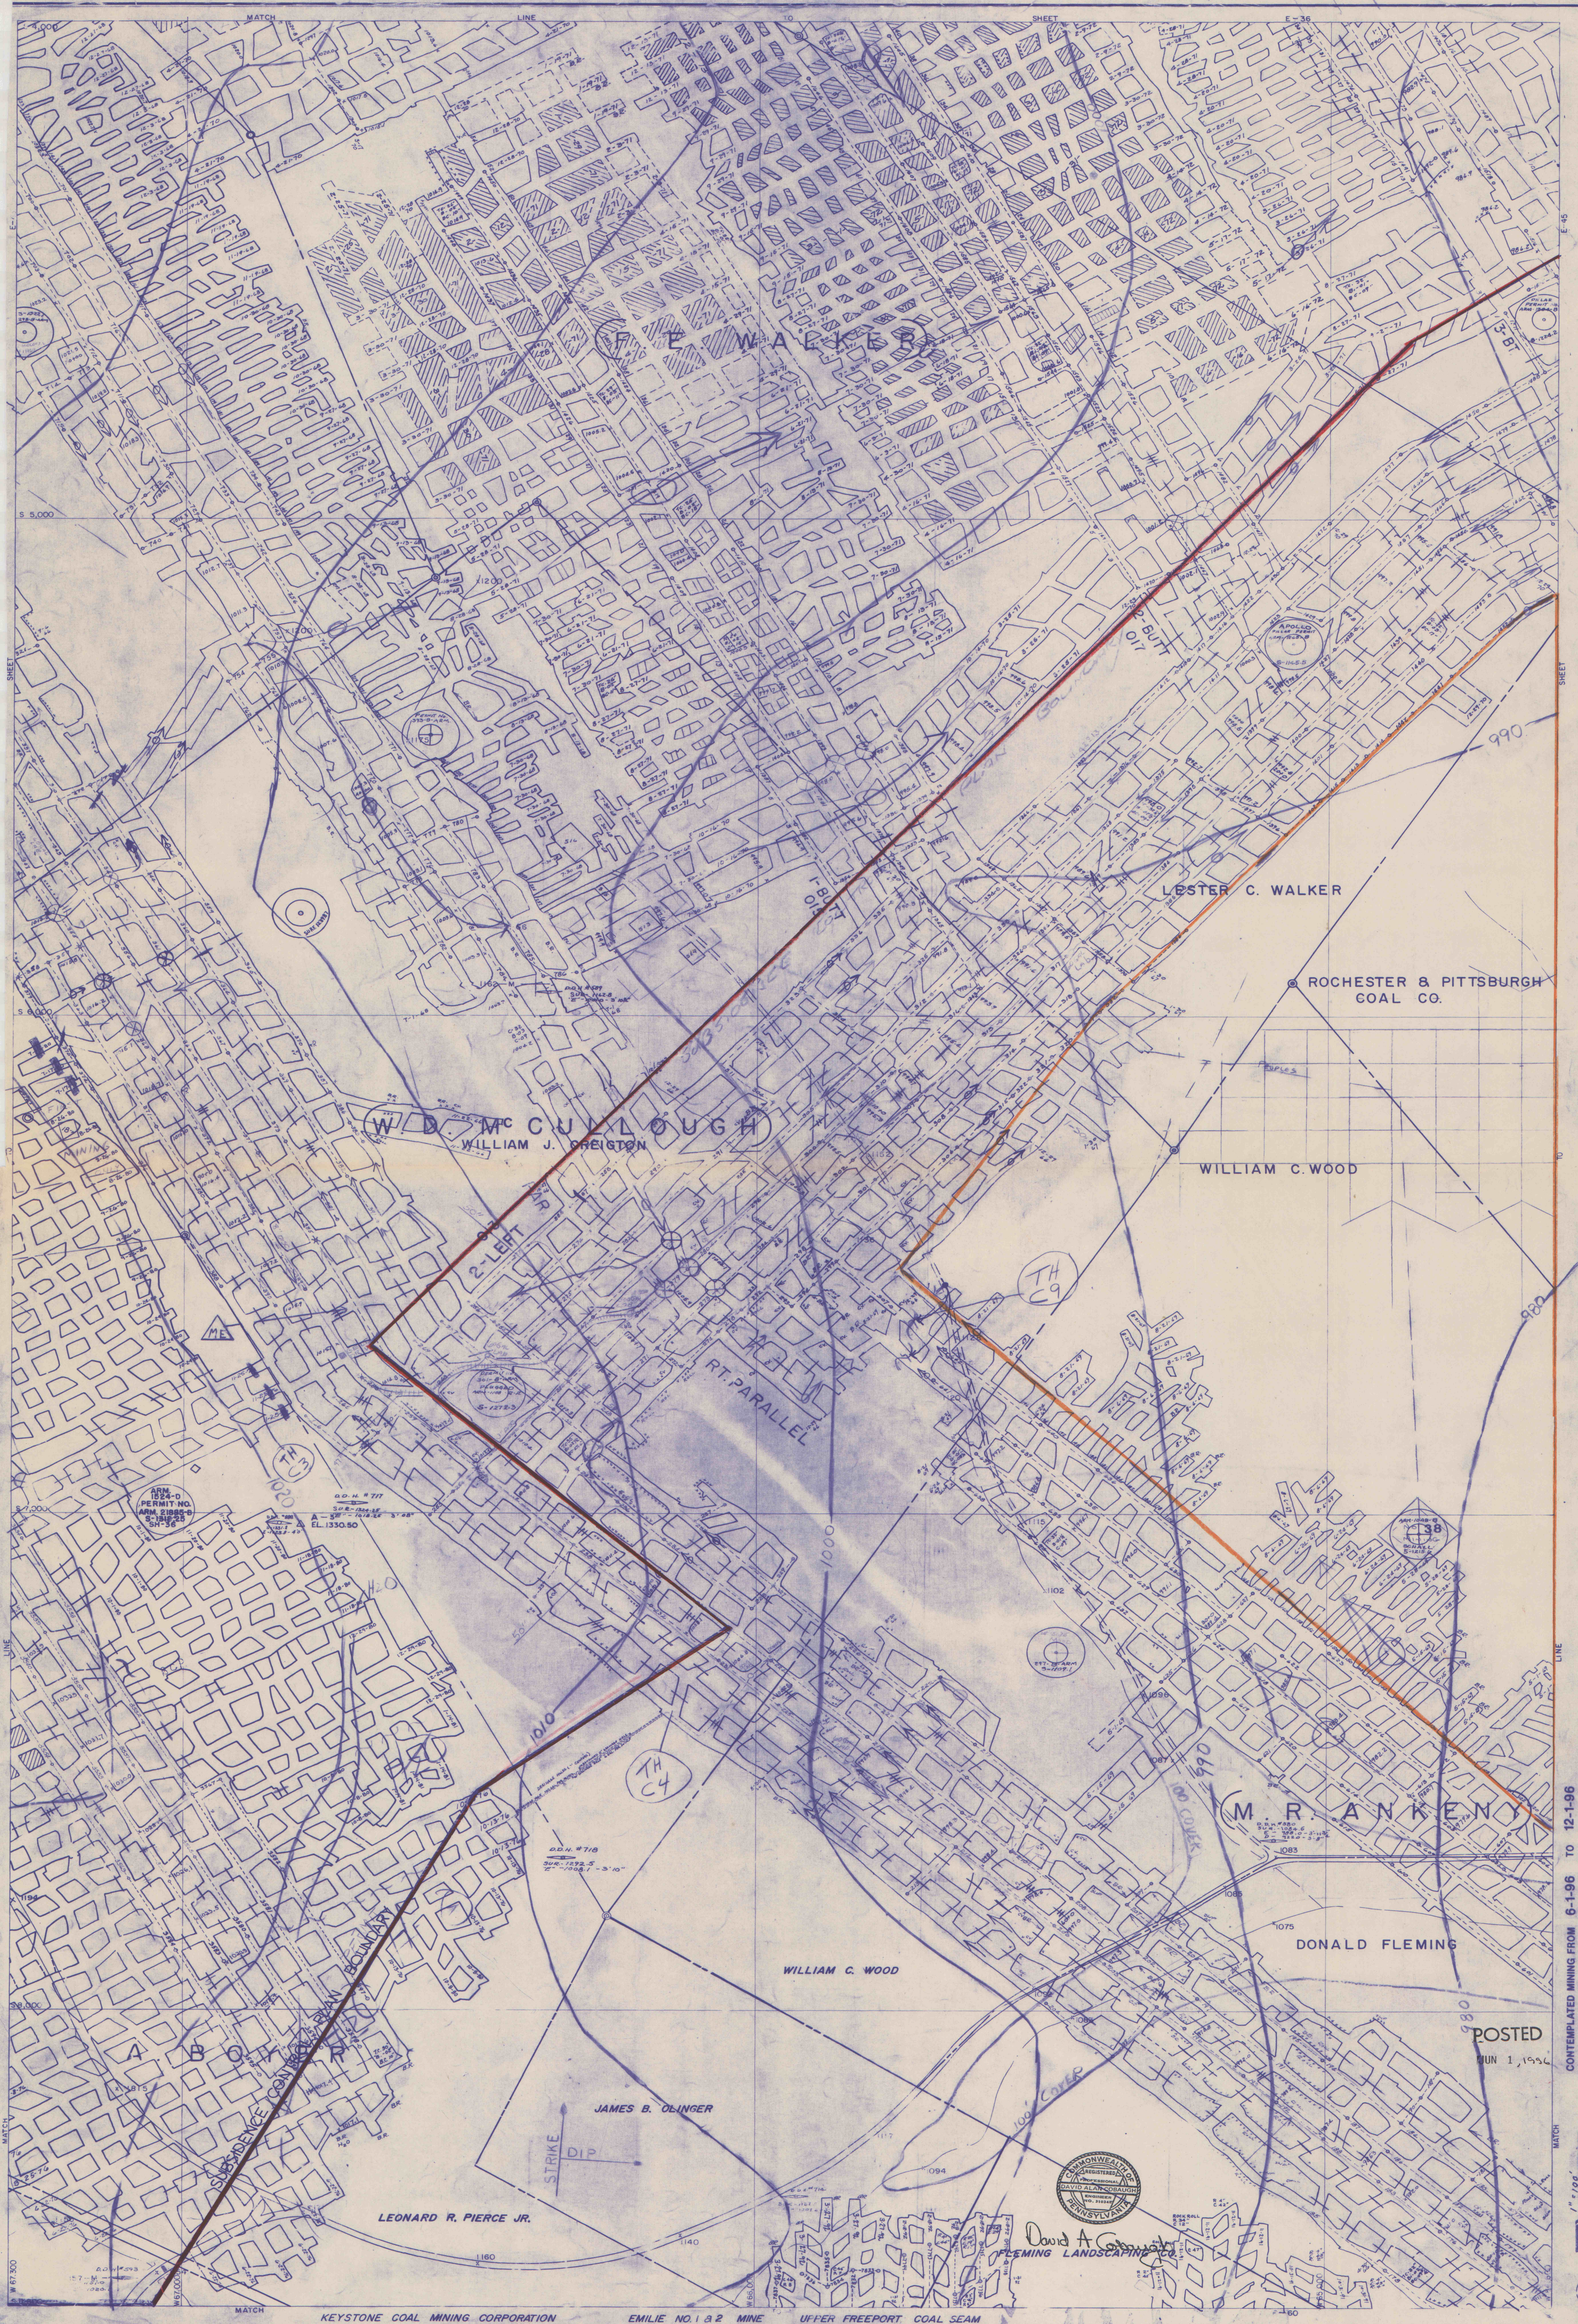

KEYSTONE COAL MINING CORPORATION  
PLUMCREEK & SOUTH BEND TOWNSHIPS  
EMILIE NO. 1 & 2 MINE  
ARMSTRONG COUNTY  
UPPER FREEPORT COAL SEAM



David A. G...  
FLEMING LANDSCAPING

