


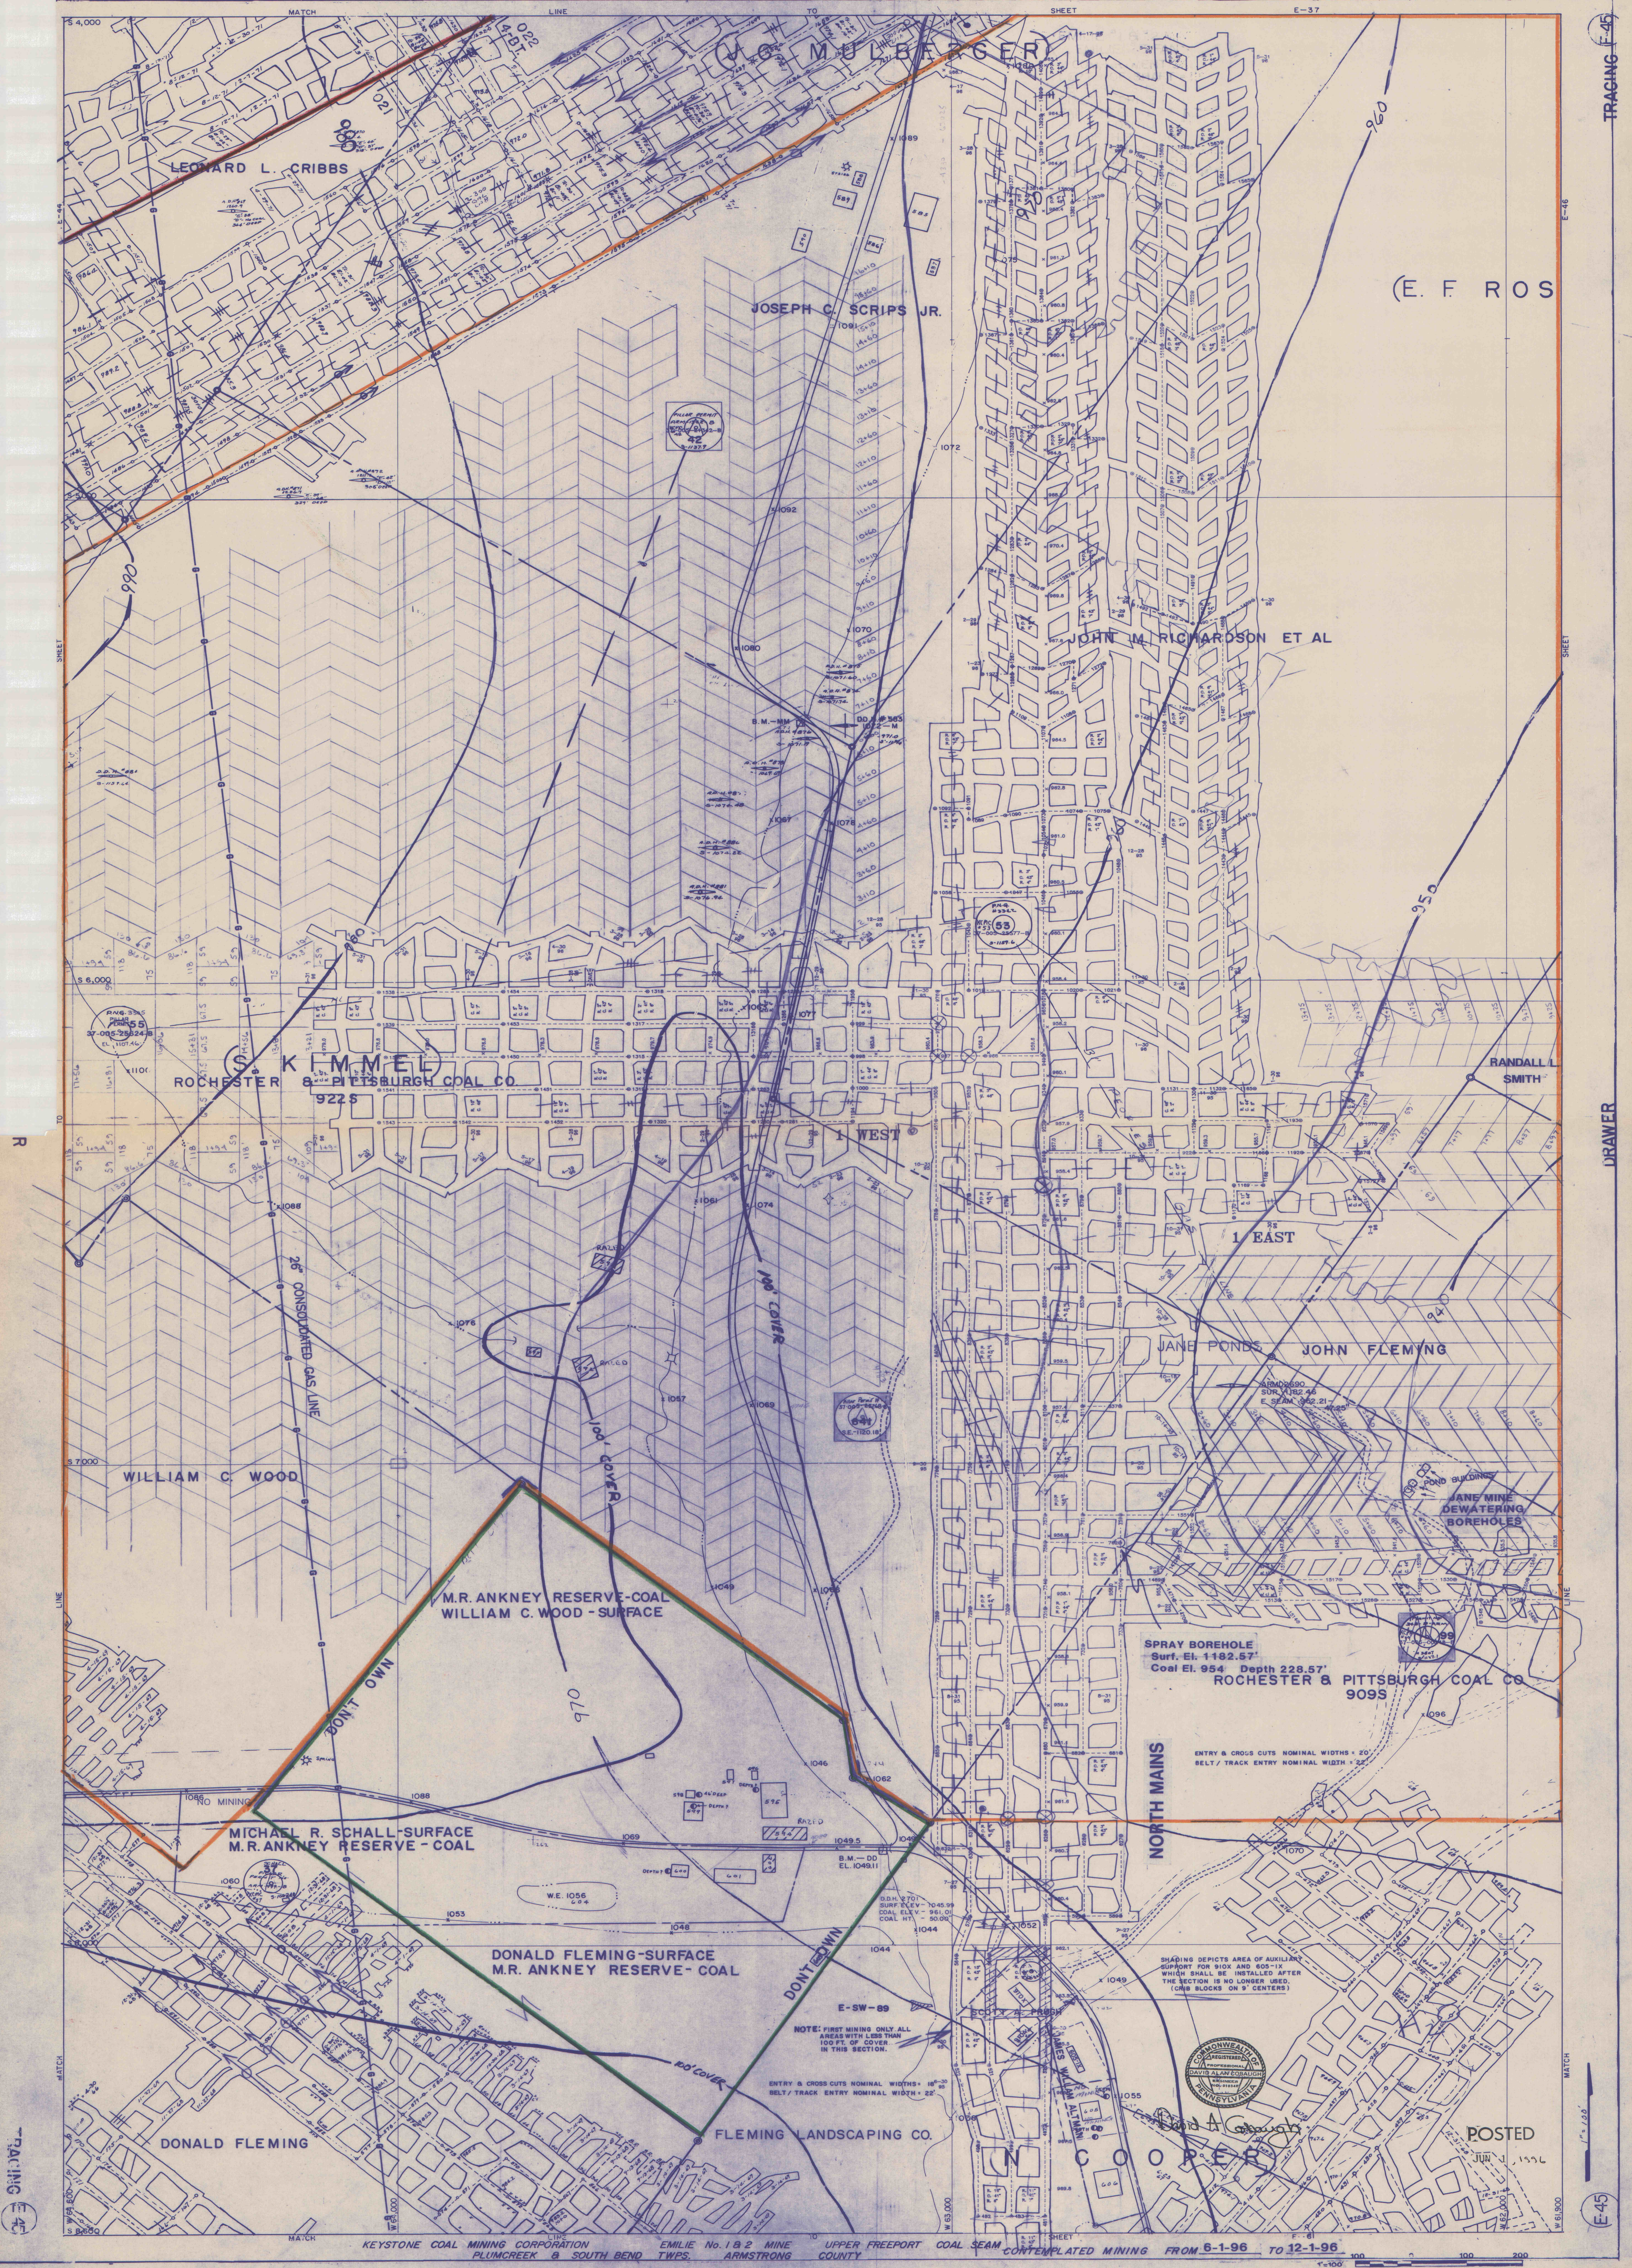


Tracing E-45

Tracing E-45

Drawer

E-45

KEYSTONE COAL MINING CORPORATION EMILIE No. 182 MINE UPPER FREEPORT COAL SEAM CONTEMPLATED MINING FROM 6-1-96 TO 12-1-96

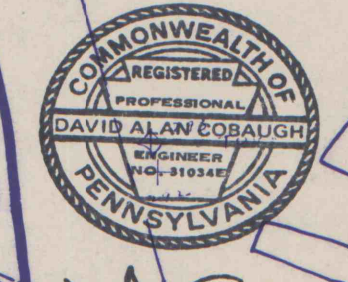

POSTED JUN 1 1996

Scale 1"=100'