


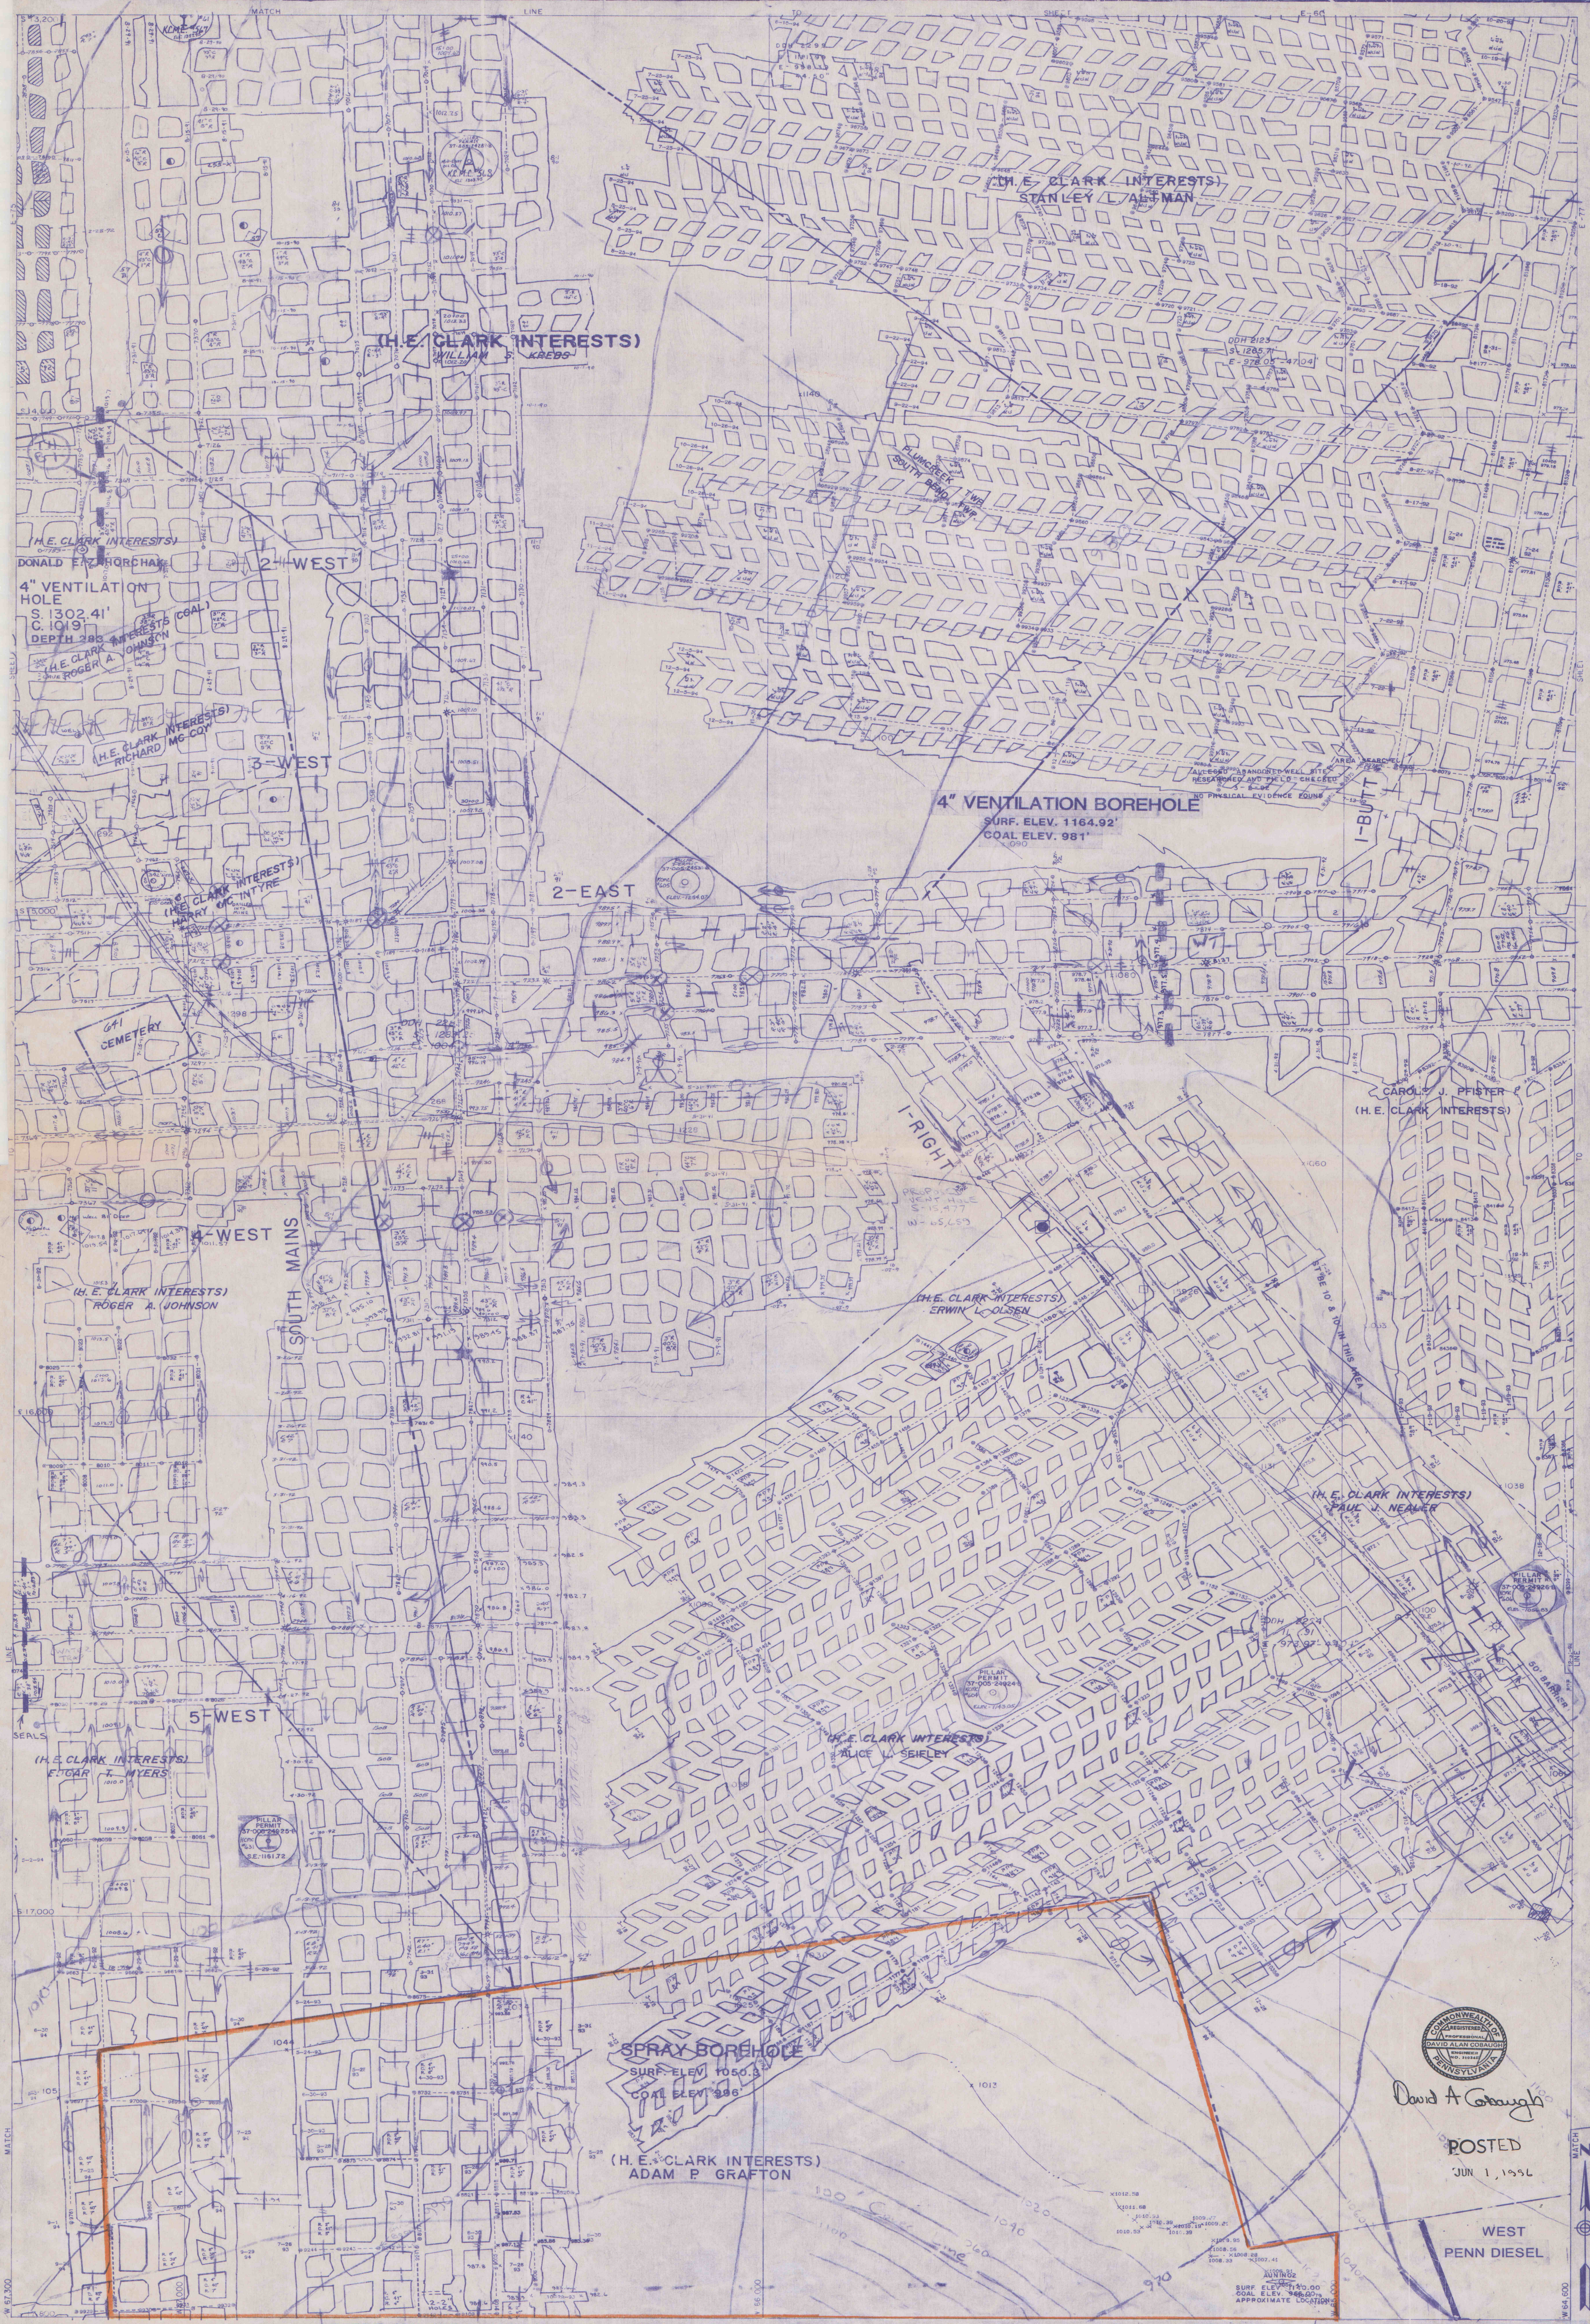

David A. Gough

POSTED
JUN 1, 1996

WEST
PENN DIESEL