




TRACING F 17

TRACING E 37

DRAWER

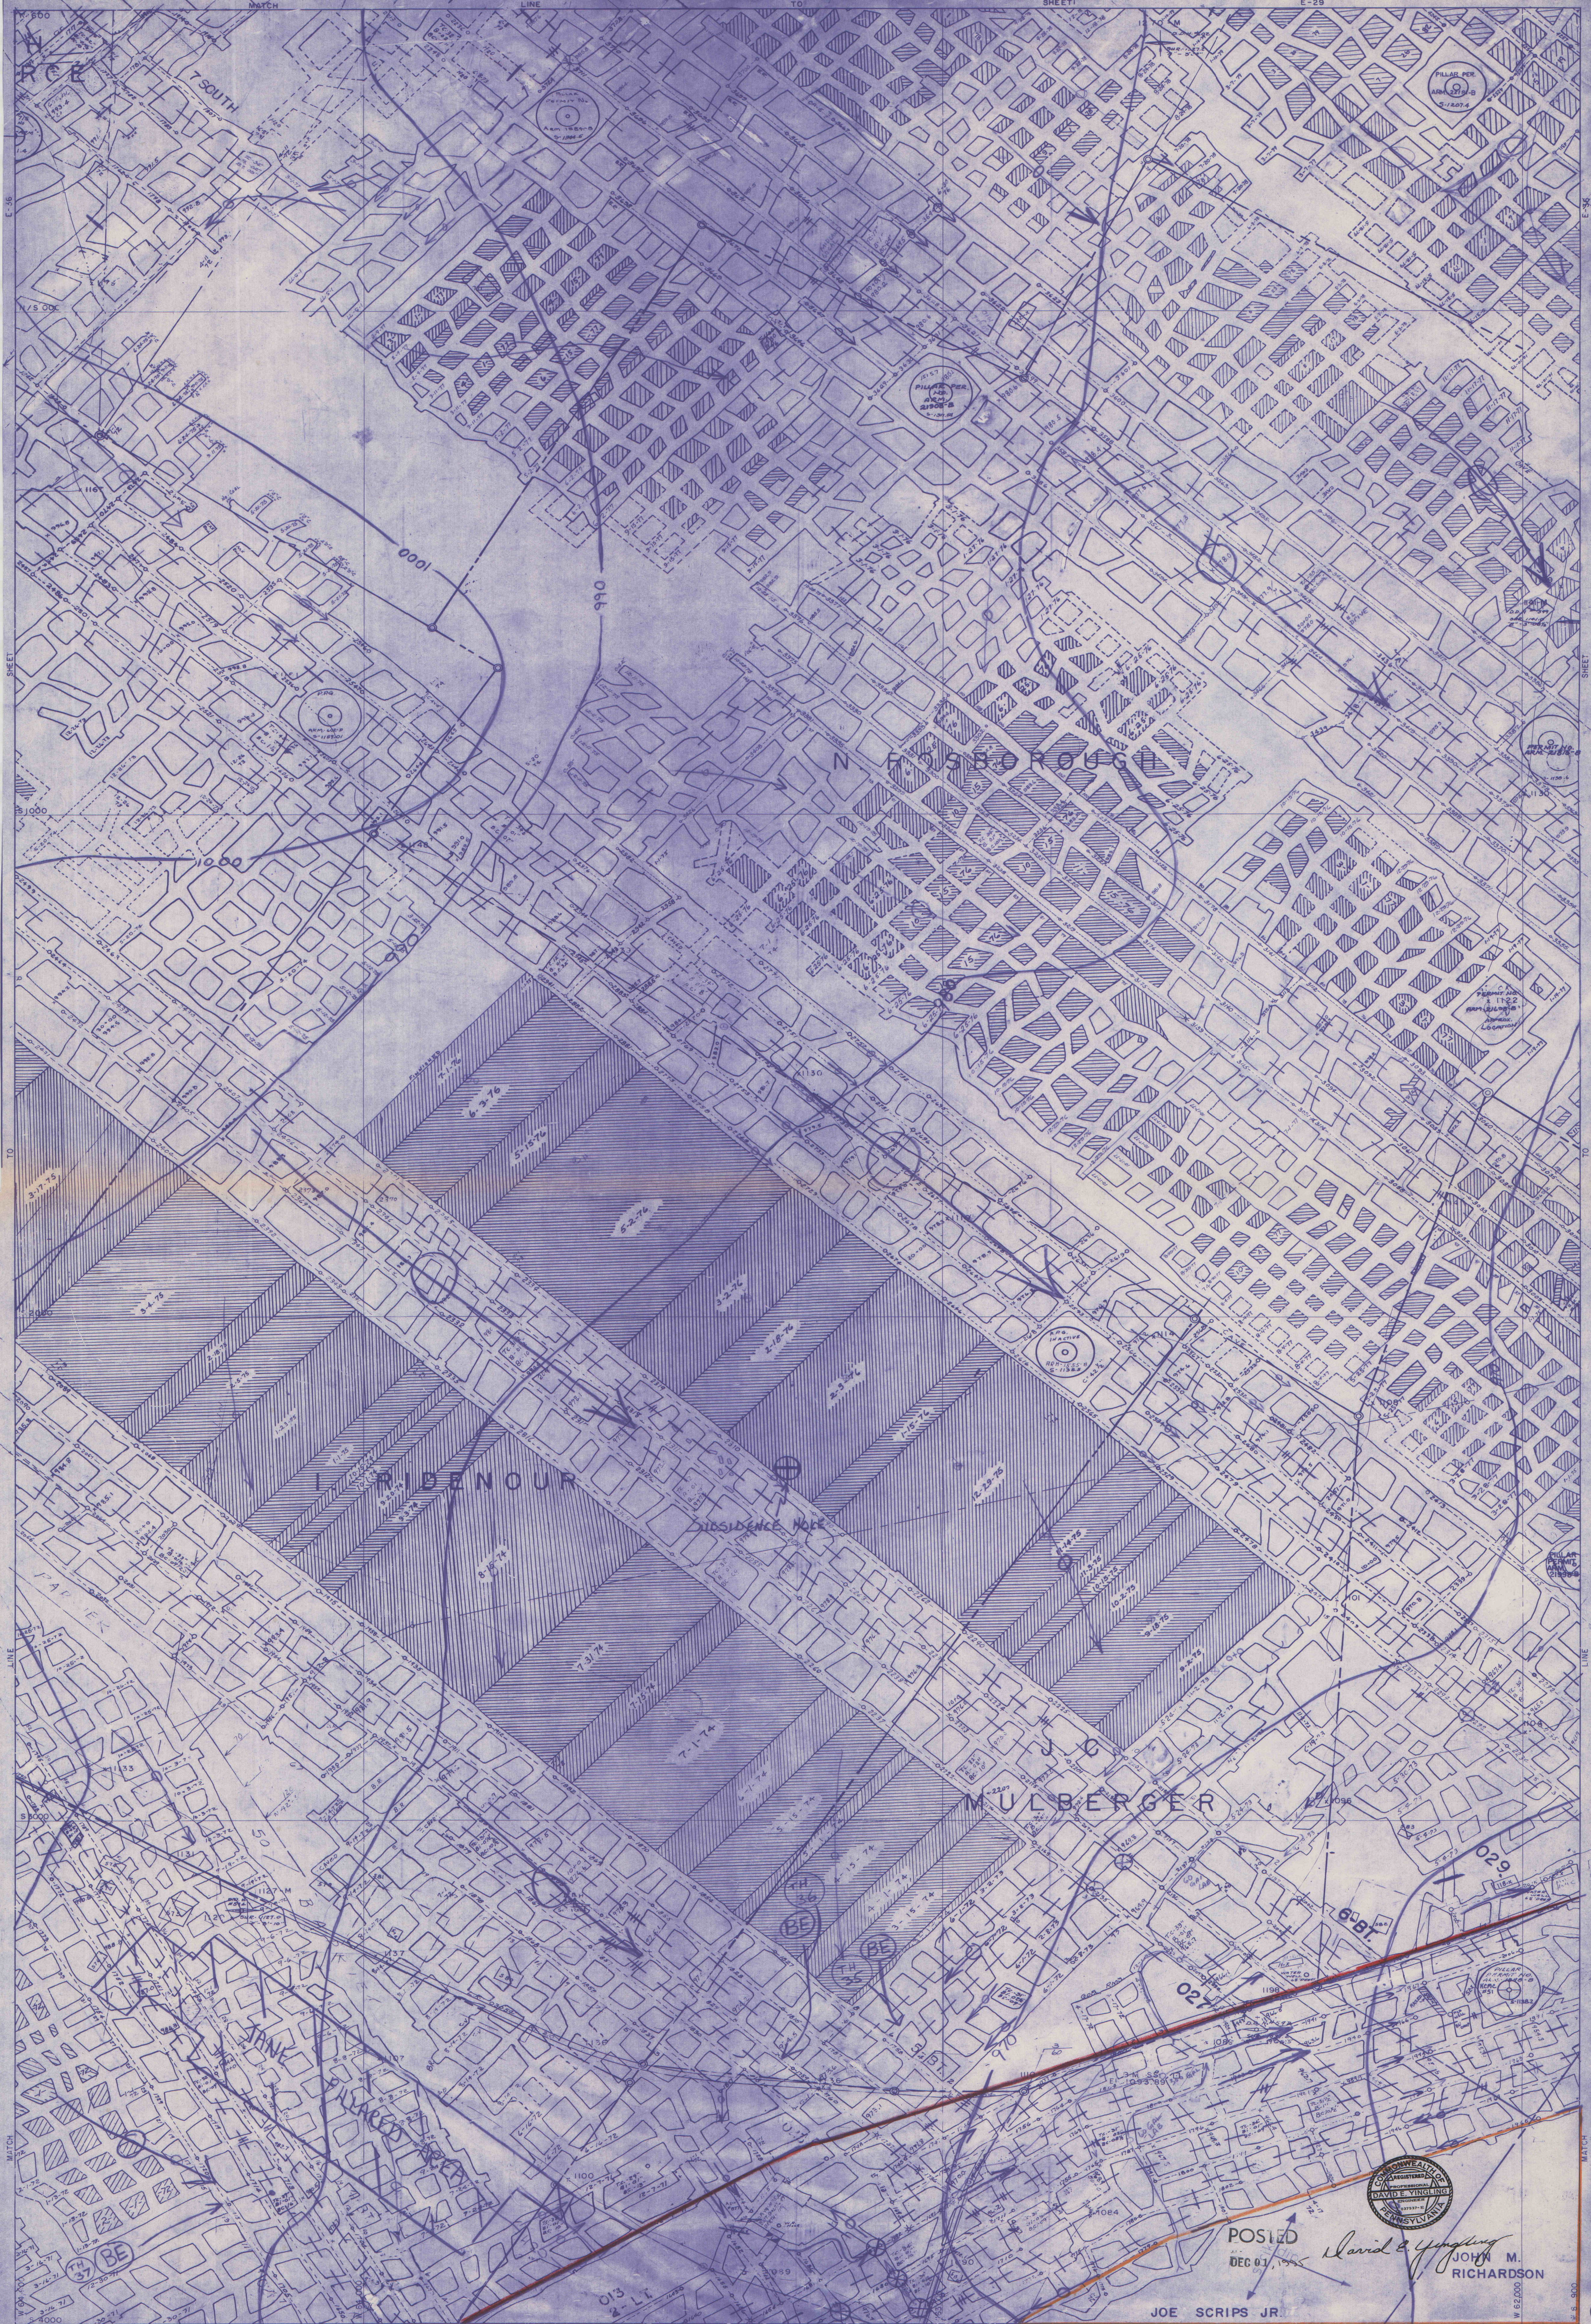

POSTED
DEC 01 1955

David E. Yingling
JOHN M. RICHARDSON

JOE SCRIPS JR.
CONTEMPLATED MINING DATE 12-1-95 TO 6-1-96

KEYSTONE COAL MINING CORPORATION
PLUMCREEK & SOUTH BEND
EMILIE No. 182 MINE
TOWNSHIPS, ARMSTRONG
UPPER FREEPORT COAL SEAM
COUNTY

Scale: 1"=100' feet