


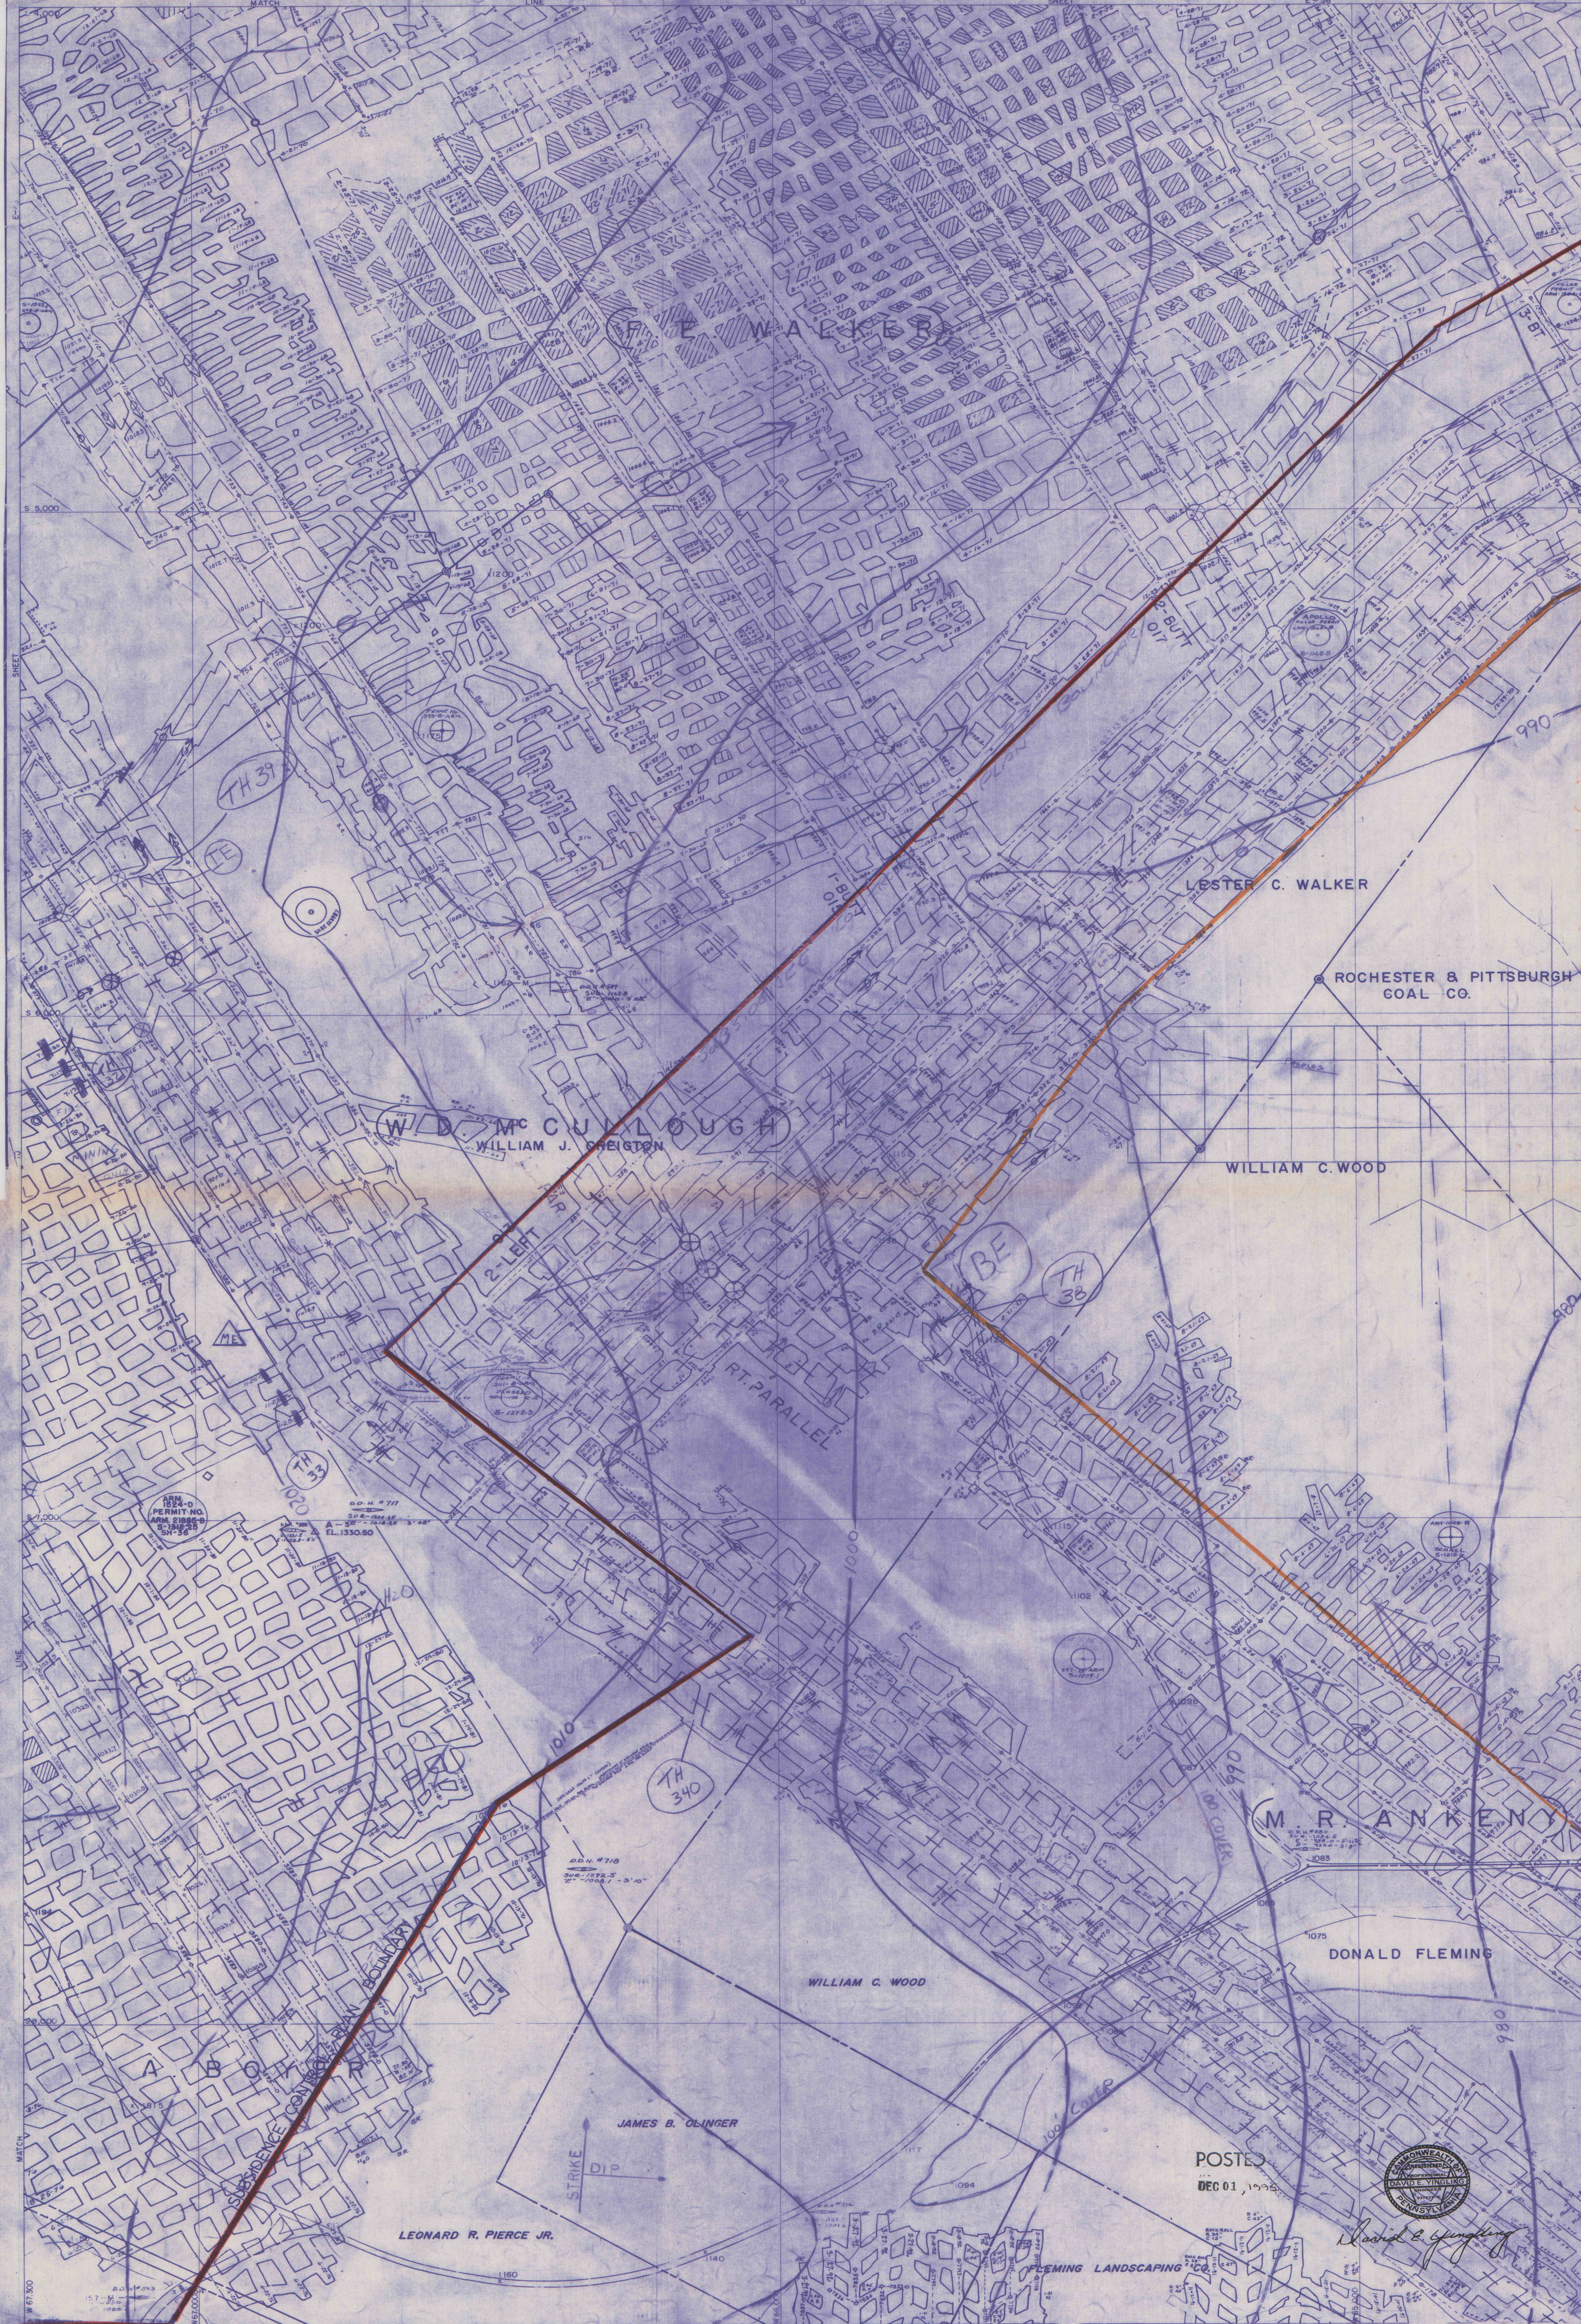

KEYSTONE COAL MINING CORPORATION
EMILIE NO. 1 & 2 MINE
UPPER FREEPORT COAL SEAM
PLUMCREEK & SOUTH BEND TOWNSHIPS
ARMSTRONG COUNTY, PENNSYLVANIA

POSTED
DEC 01, 1995




CONTEMPLATED MINING FROM 12-1-95 TO 6-1-96

1"=100' 0 50 100 feet