


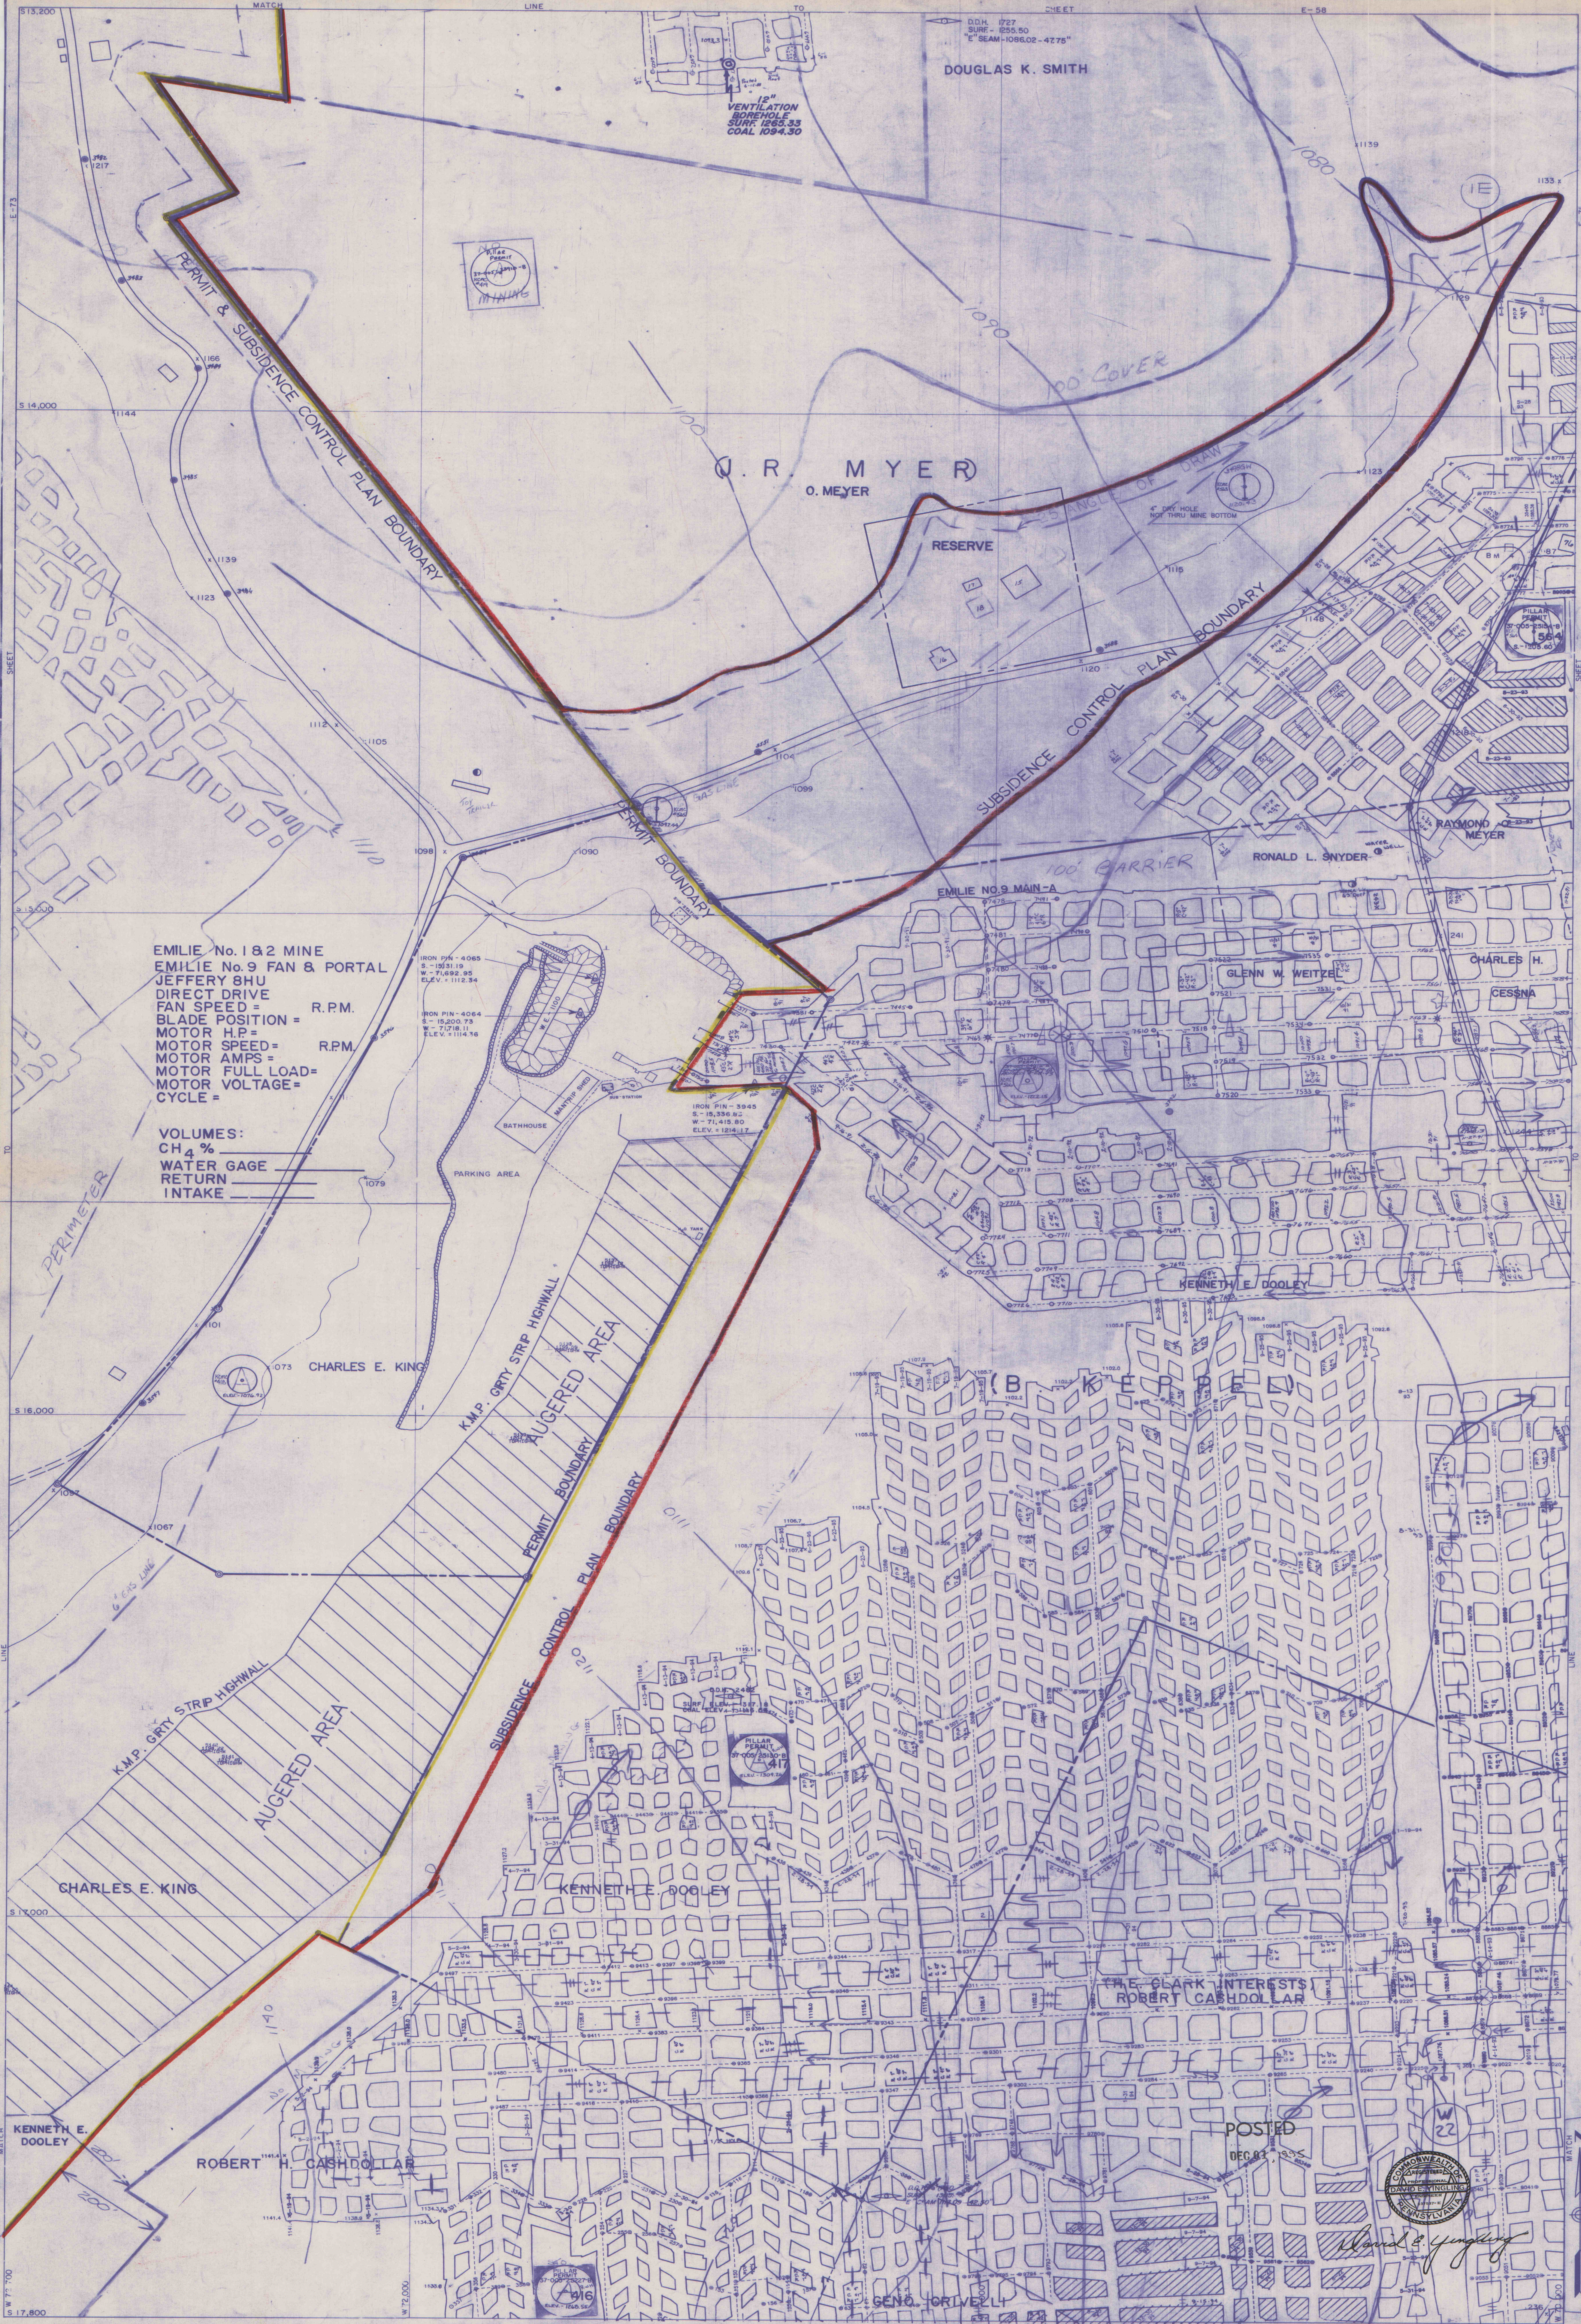

EMILIE No. 1 & 2 MINE
EMILIE No. 9 FAN & PORTAL
JEFFERY 8HU
DIRECT DRIVE
FAN SPEED = R.P.M.
BLADE POSITION =
MOTOR H.P. = R.P.M.
MOTOR SPEED =
MOTOR AMPS =
MOTOR FULL LOAD =
CYCLE =

VOLUMES:
CH₄ %
WATER GAGE
RETURN
INTAKE



David S. Jungling