


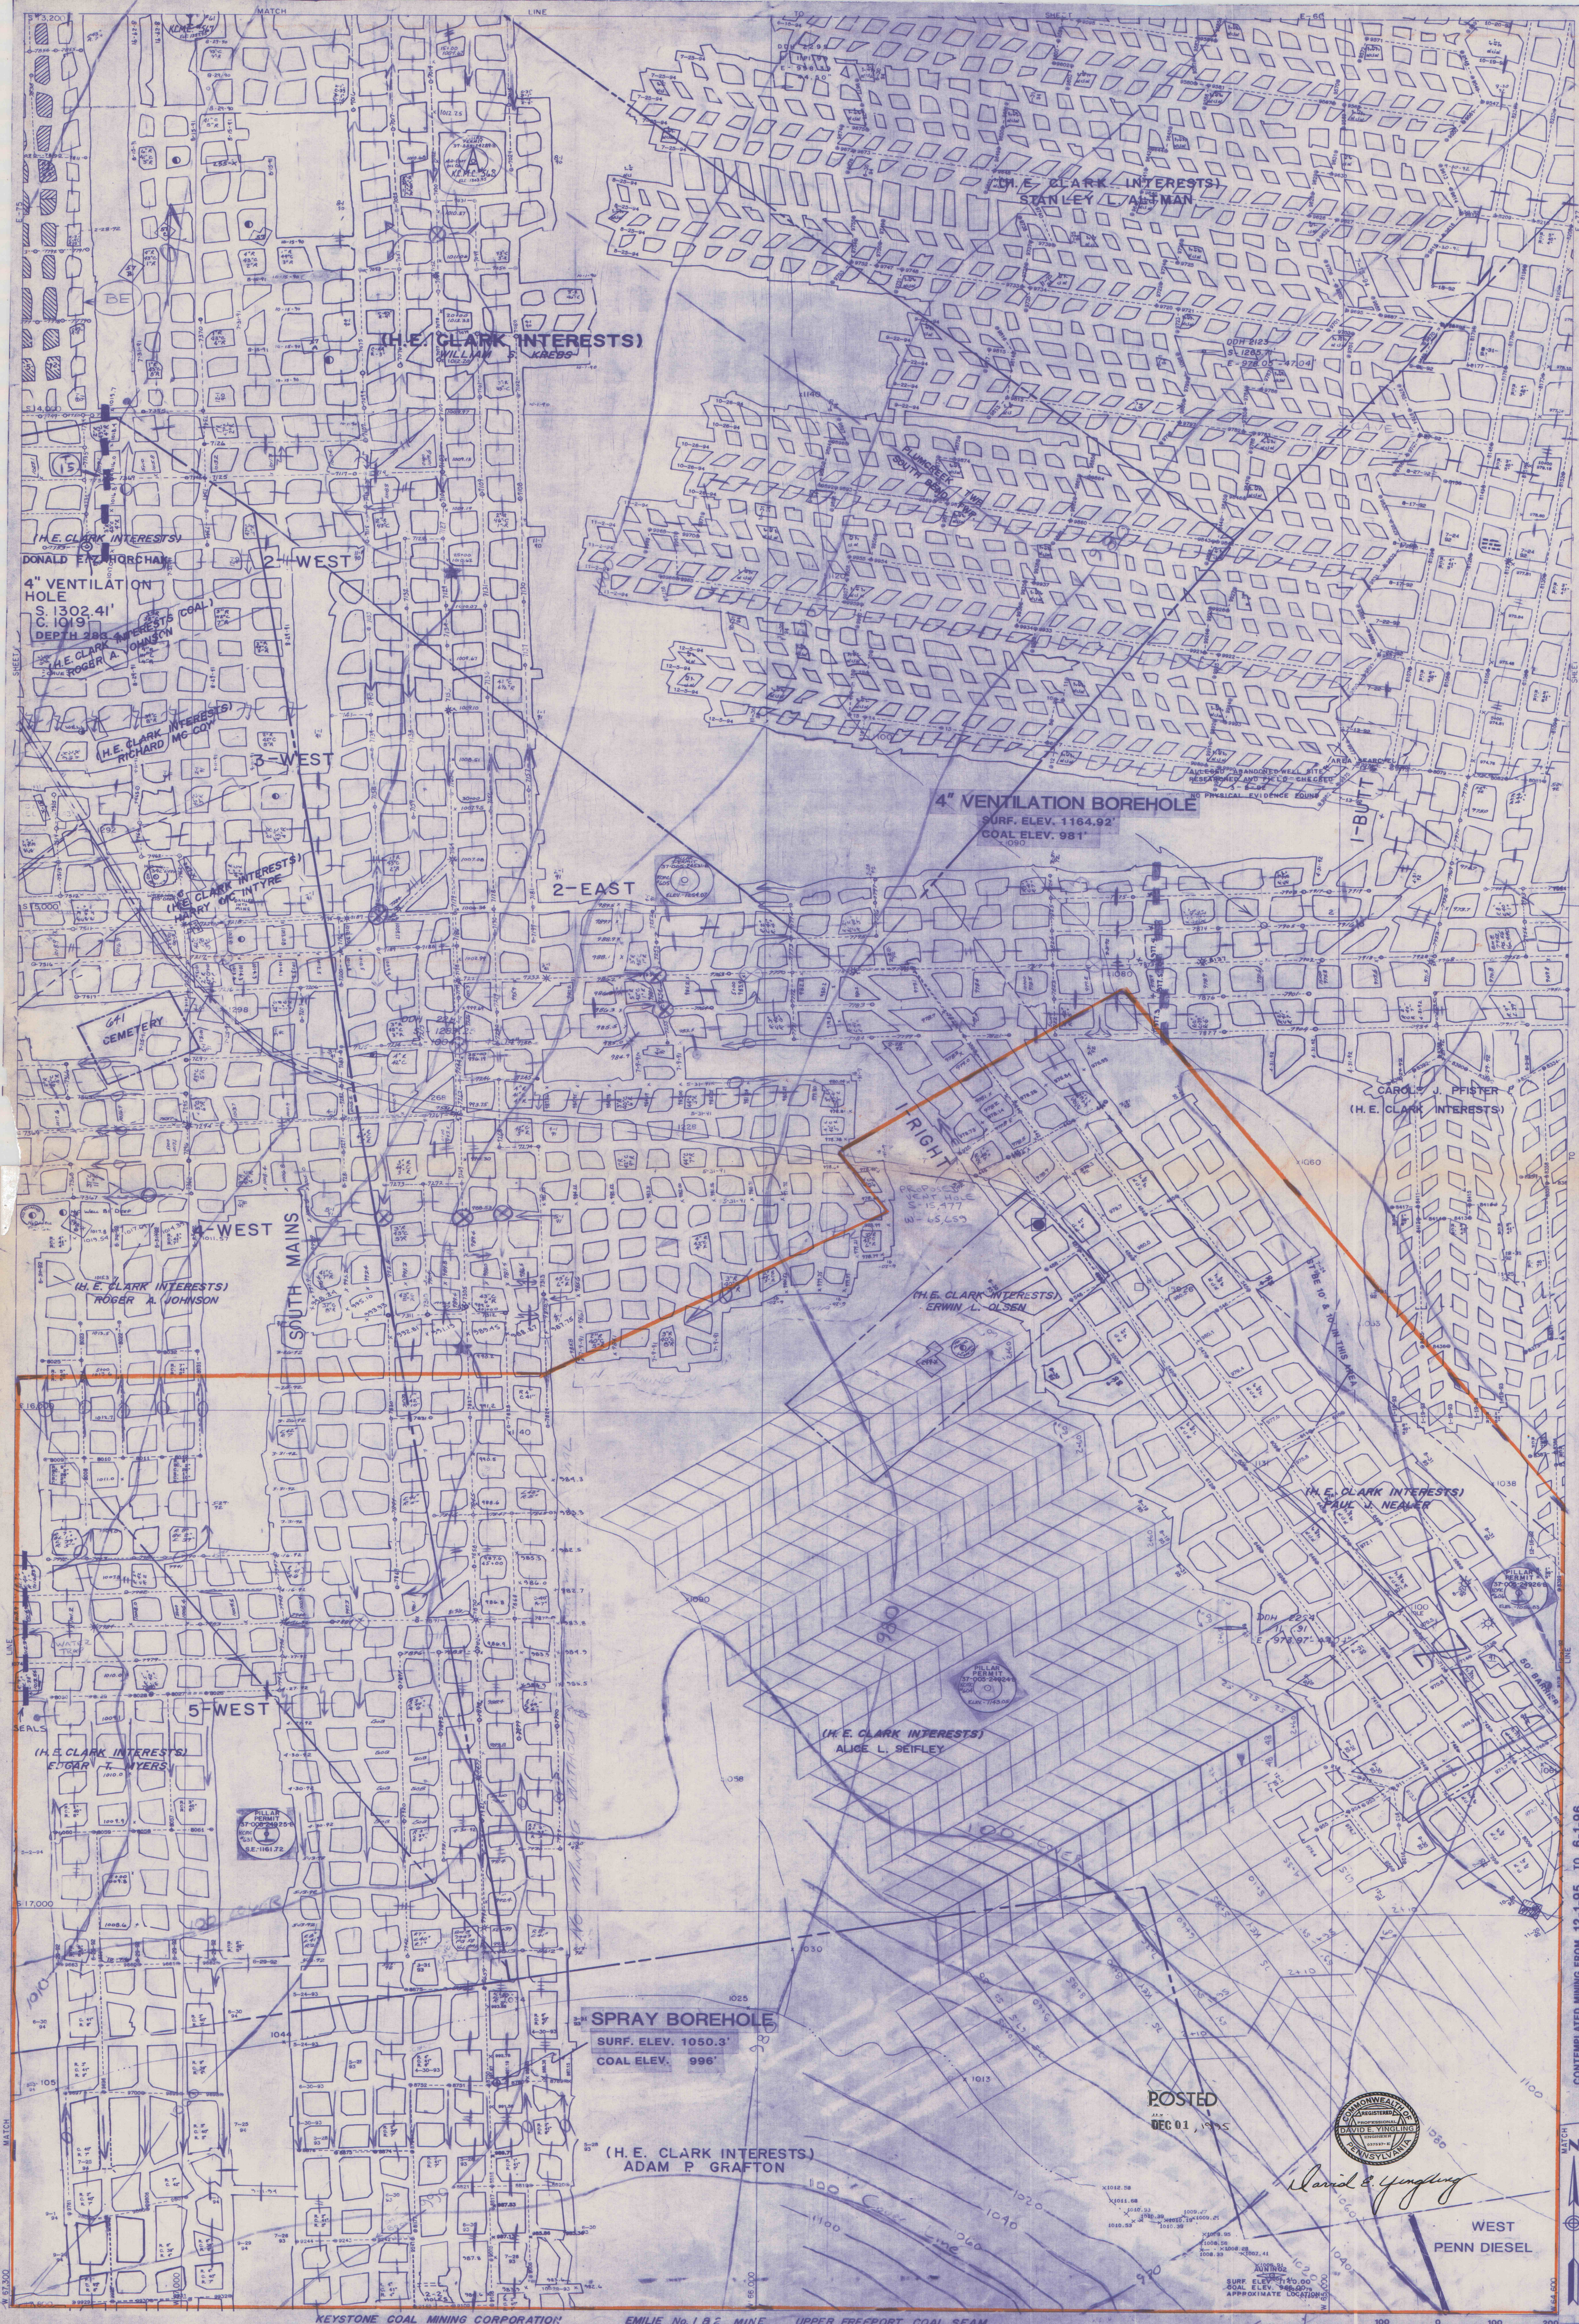

David E. Yungling

POSTED
DEC 01, 1995

WEST
PENN DIESEL

SURF. ELEV. 1100.00
GOAL ELEV. 986.00
APPROXIMATE LOCATION

