


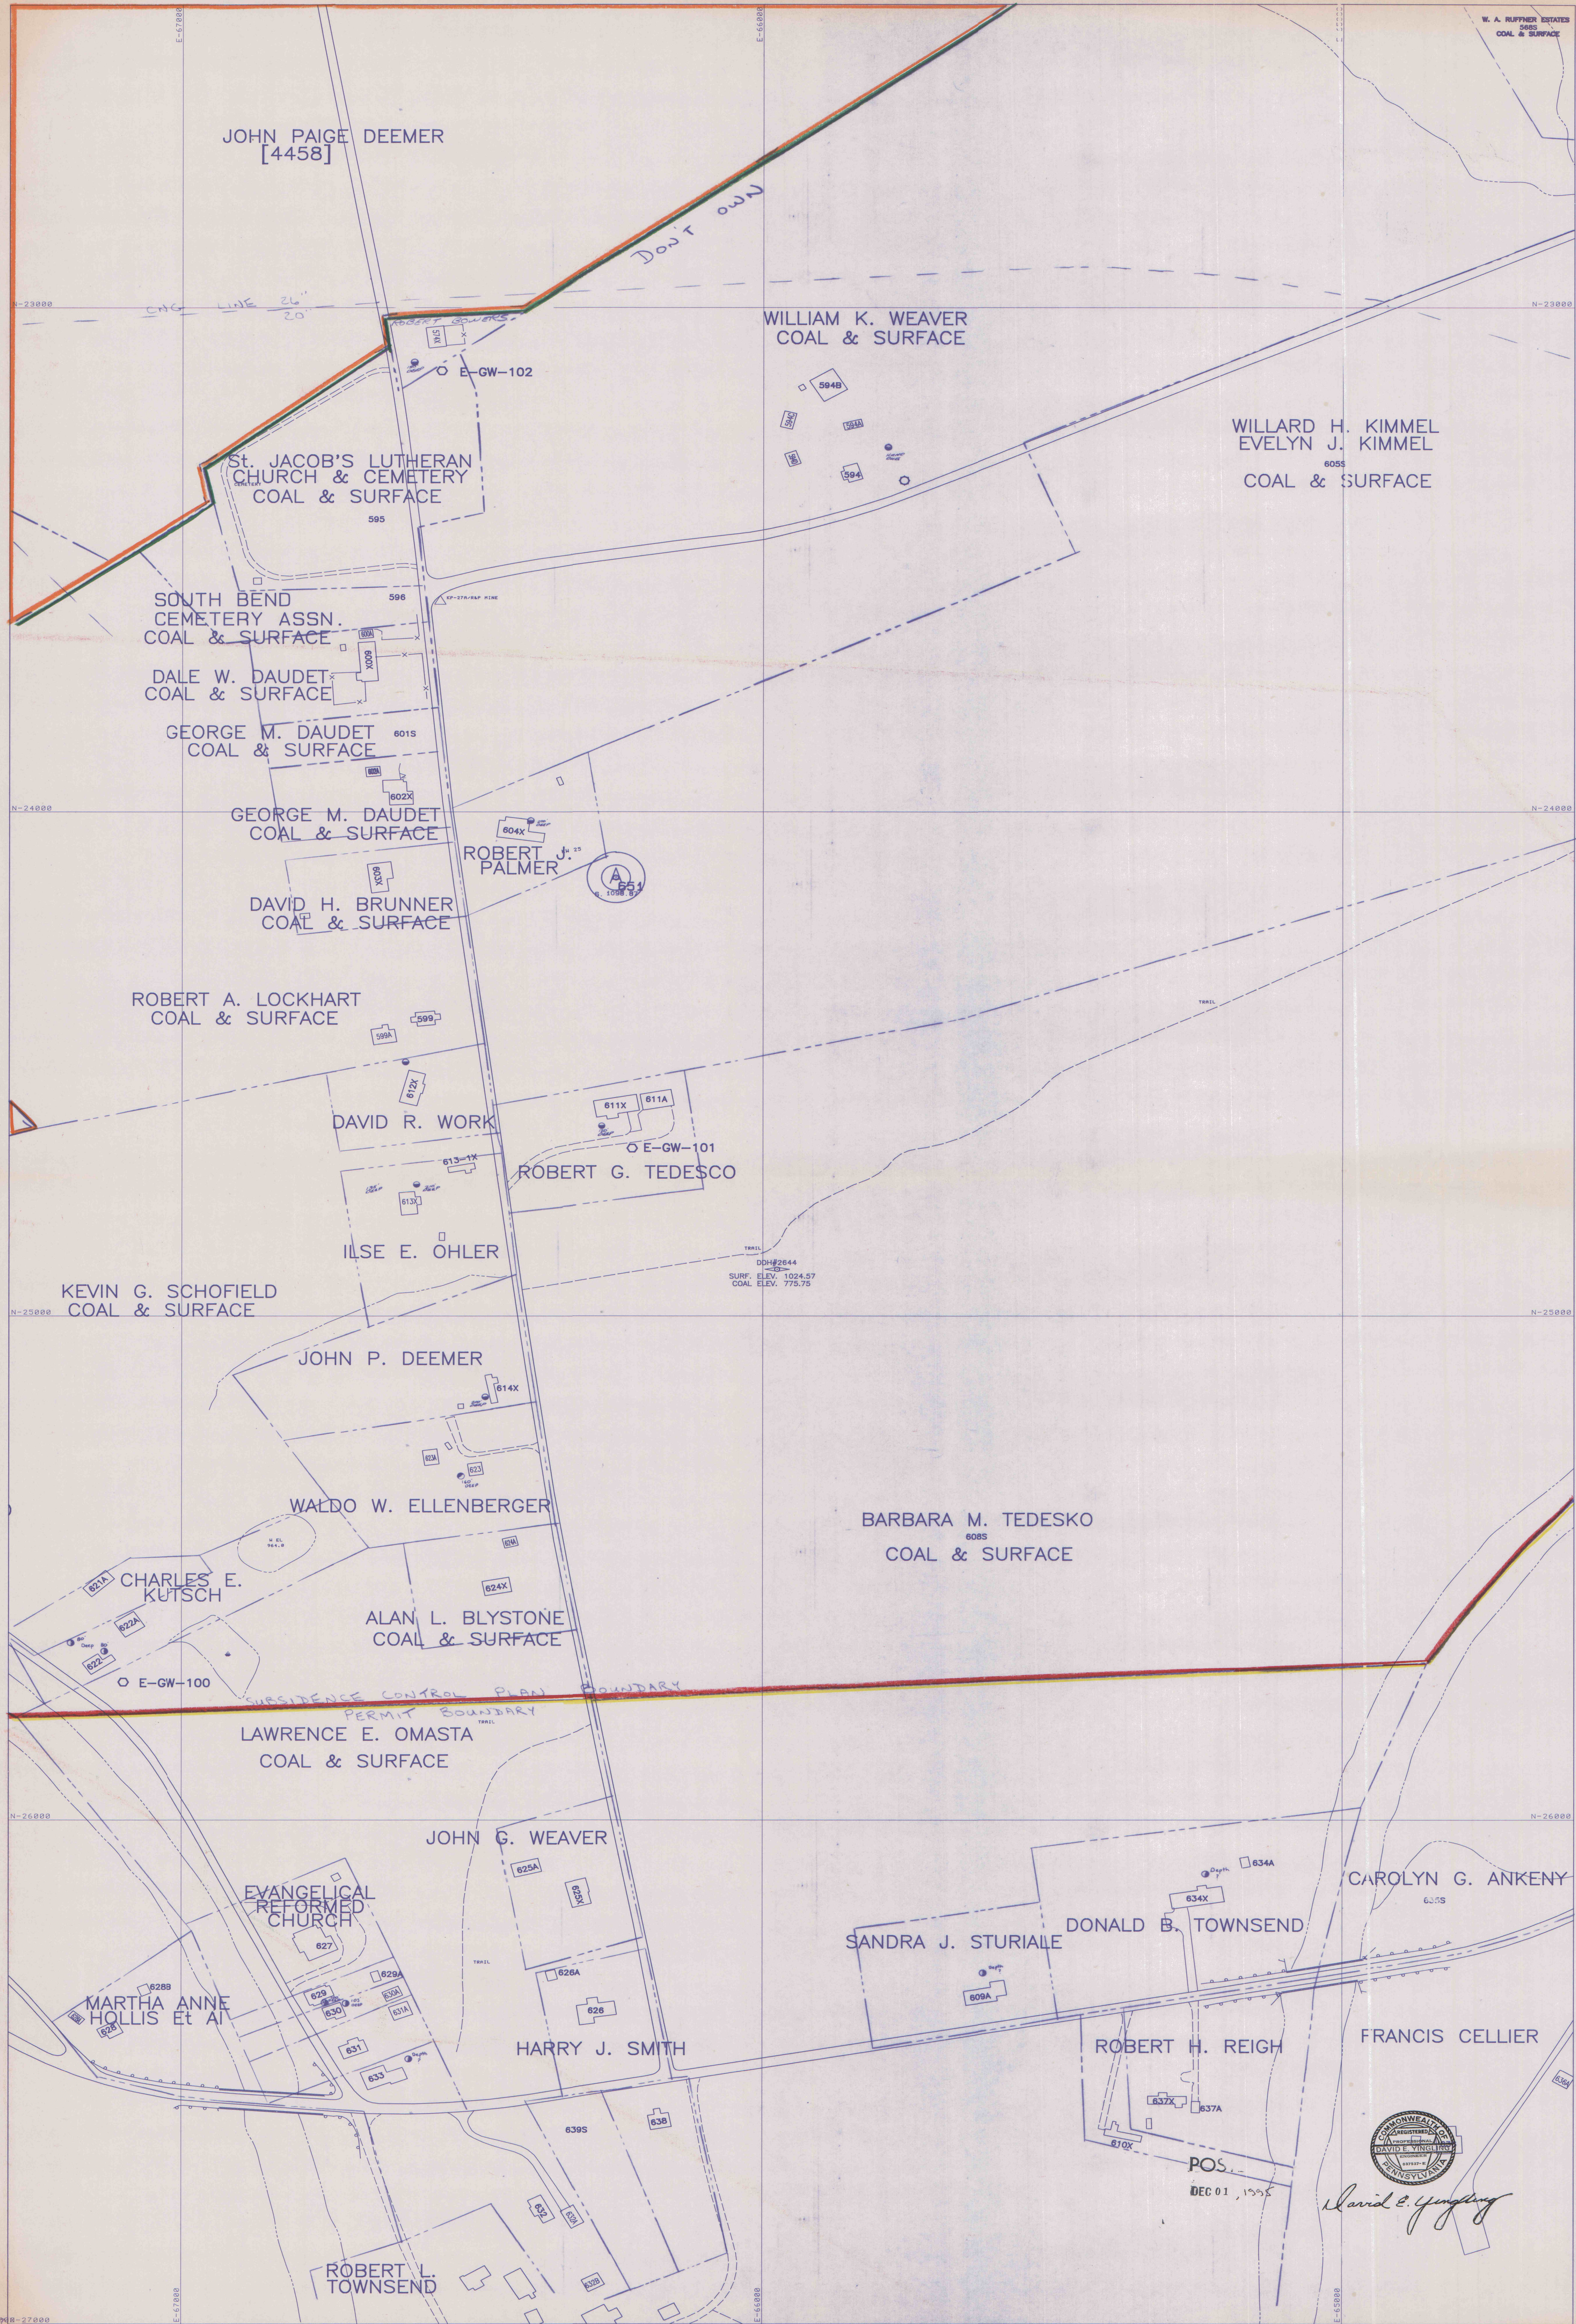

David E. Youngling
DEC 01, 1995