


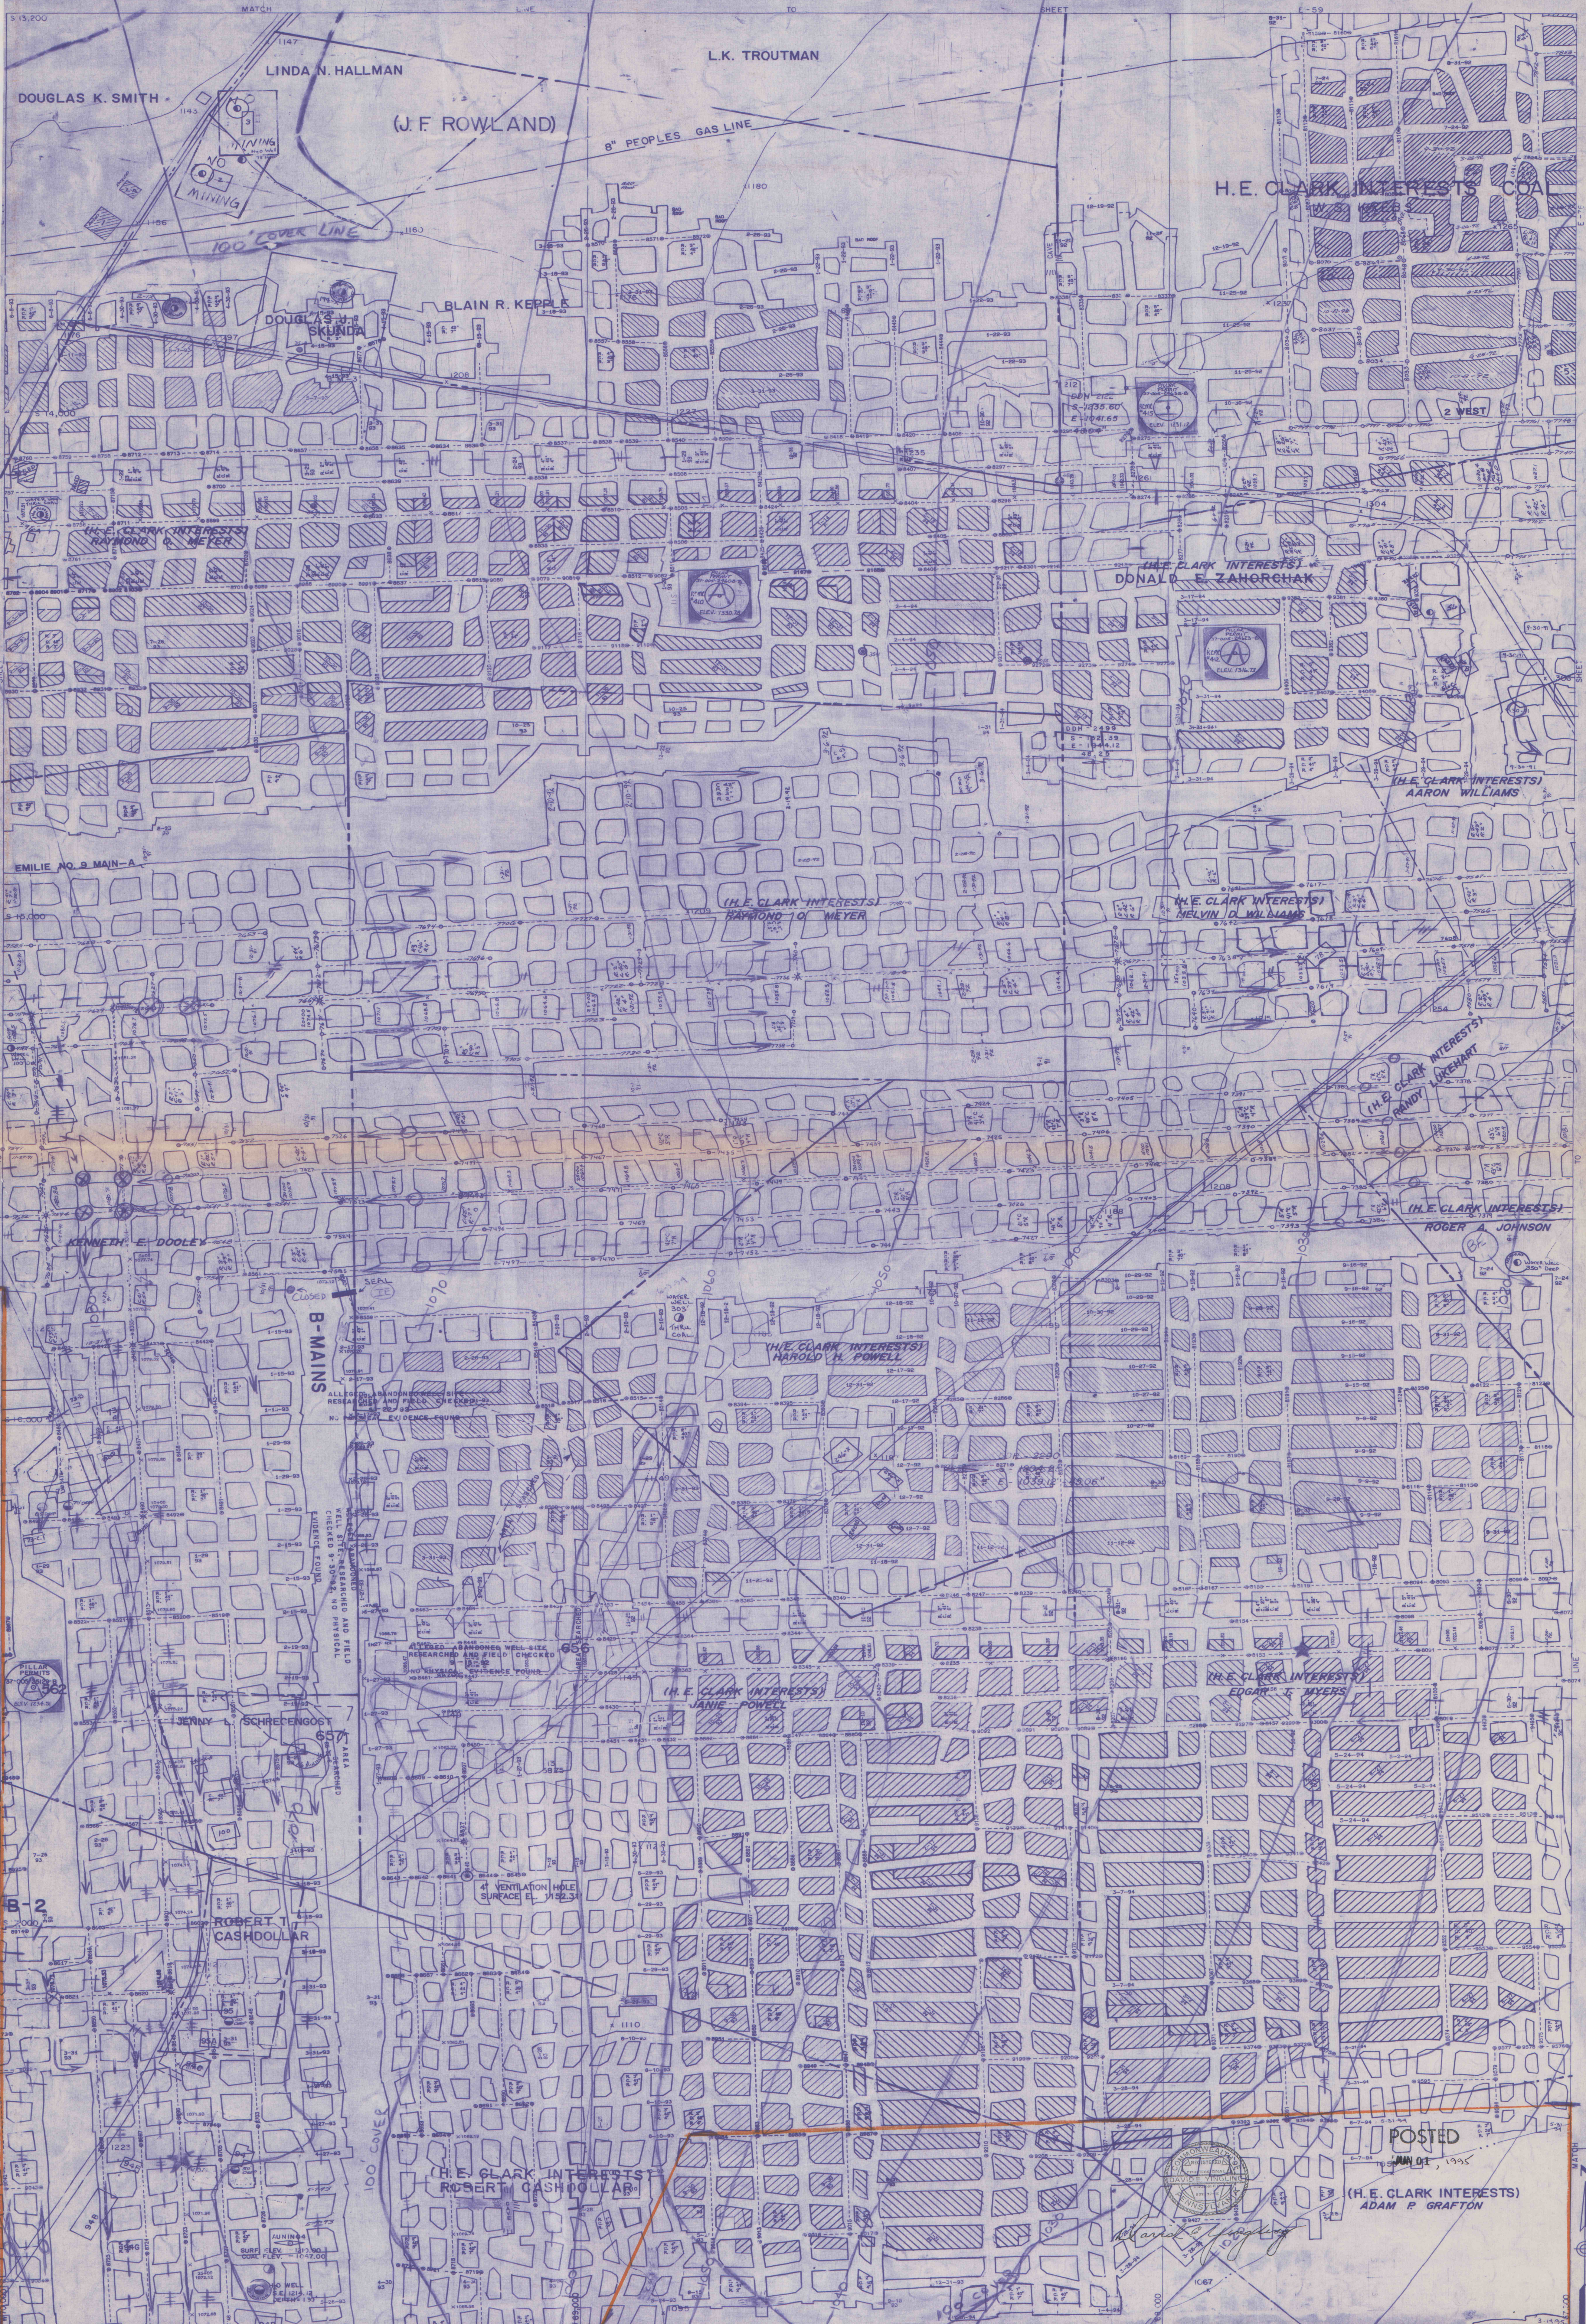

TRACING E-75

DRAWER

E-75