


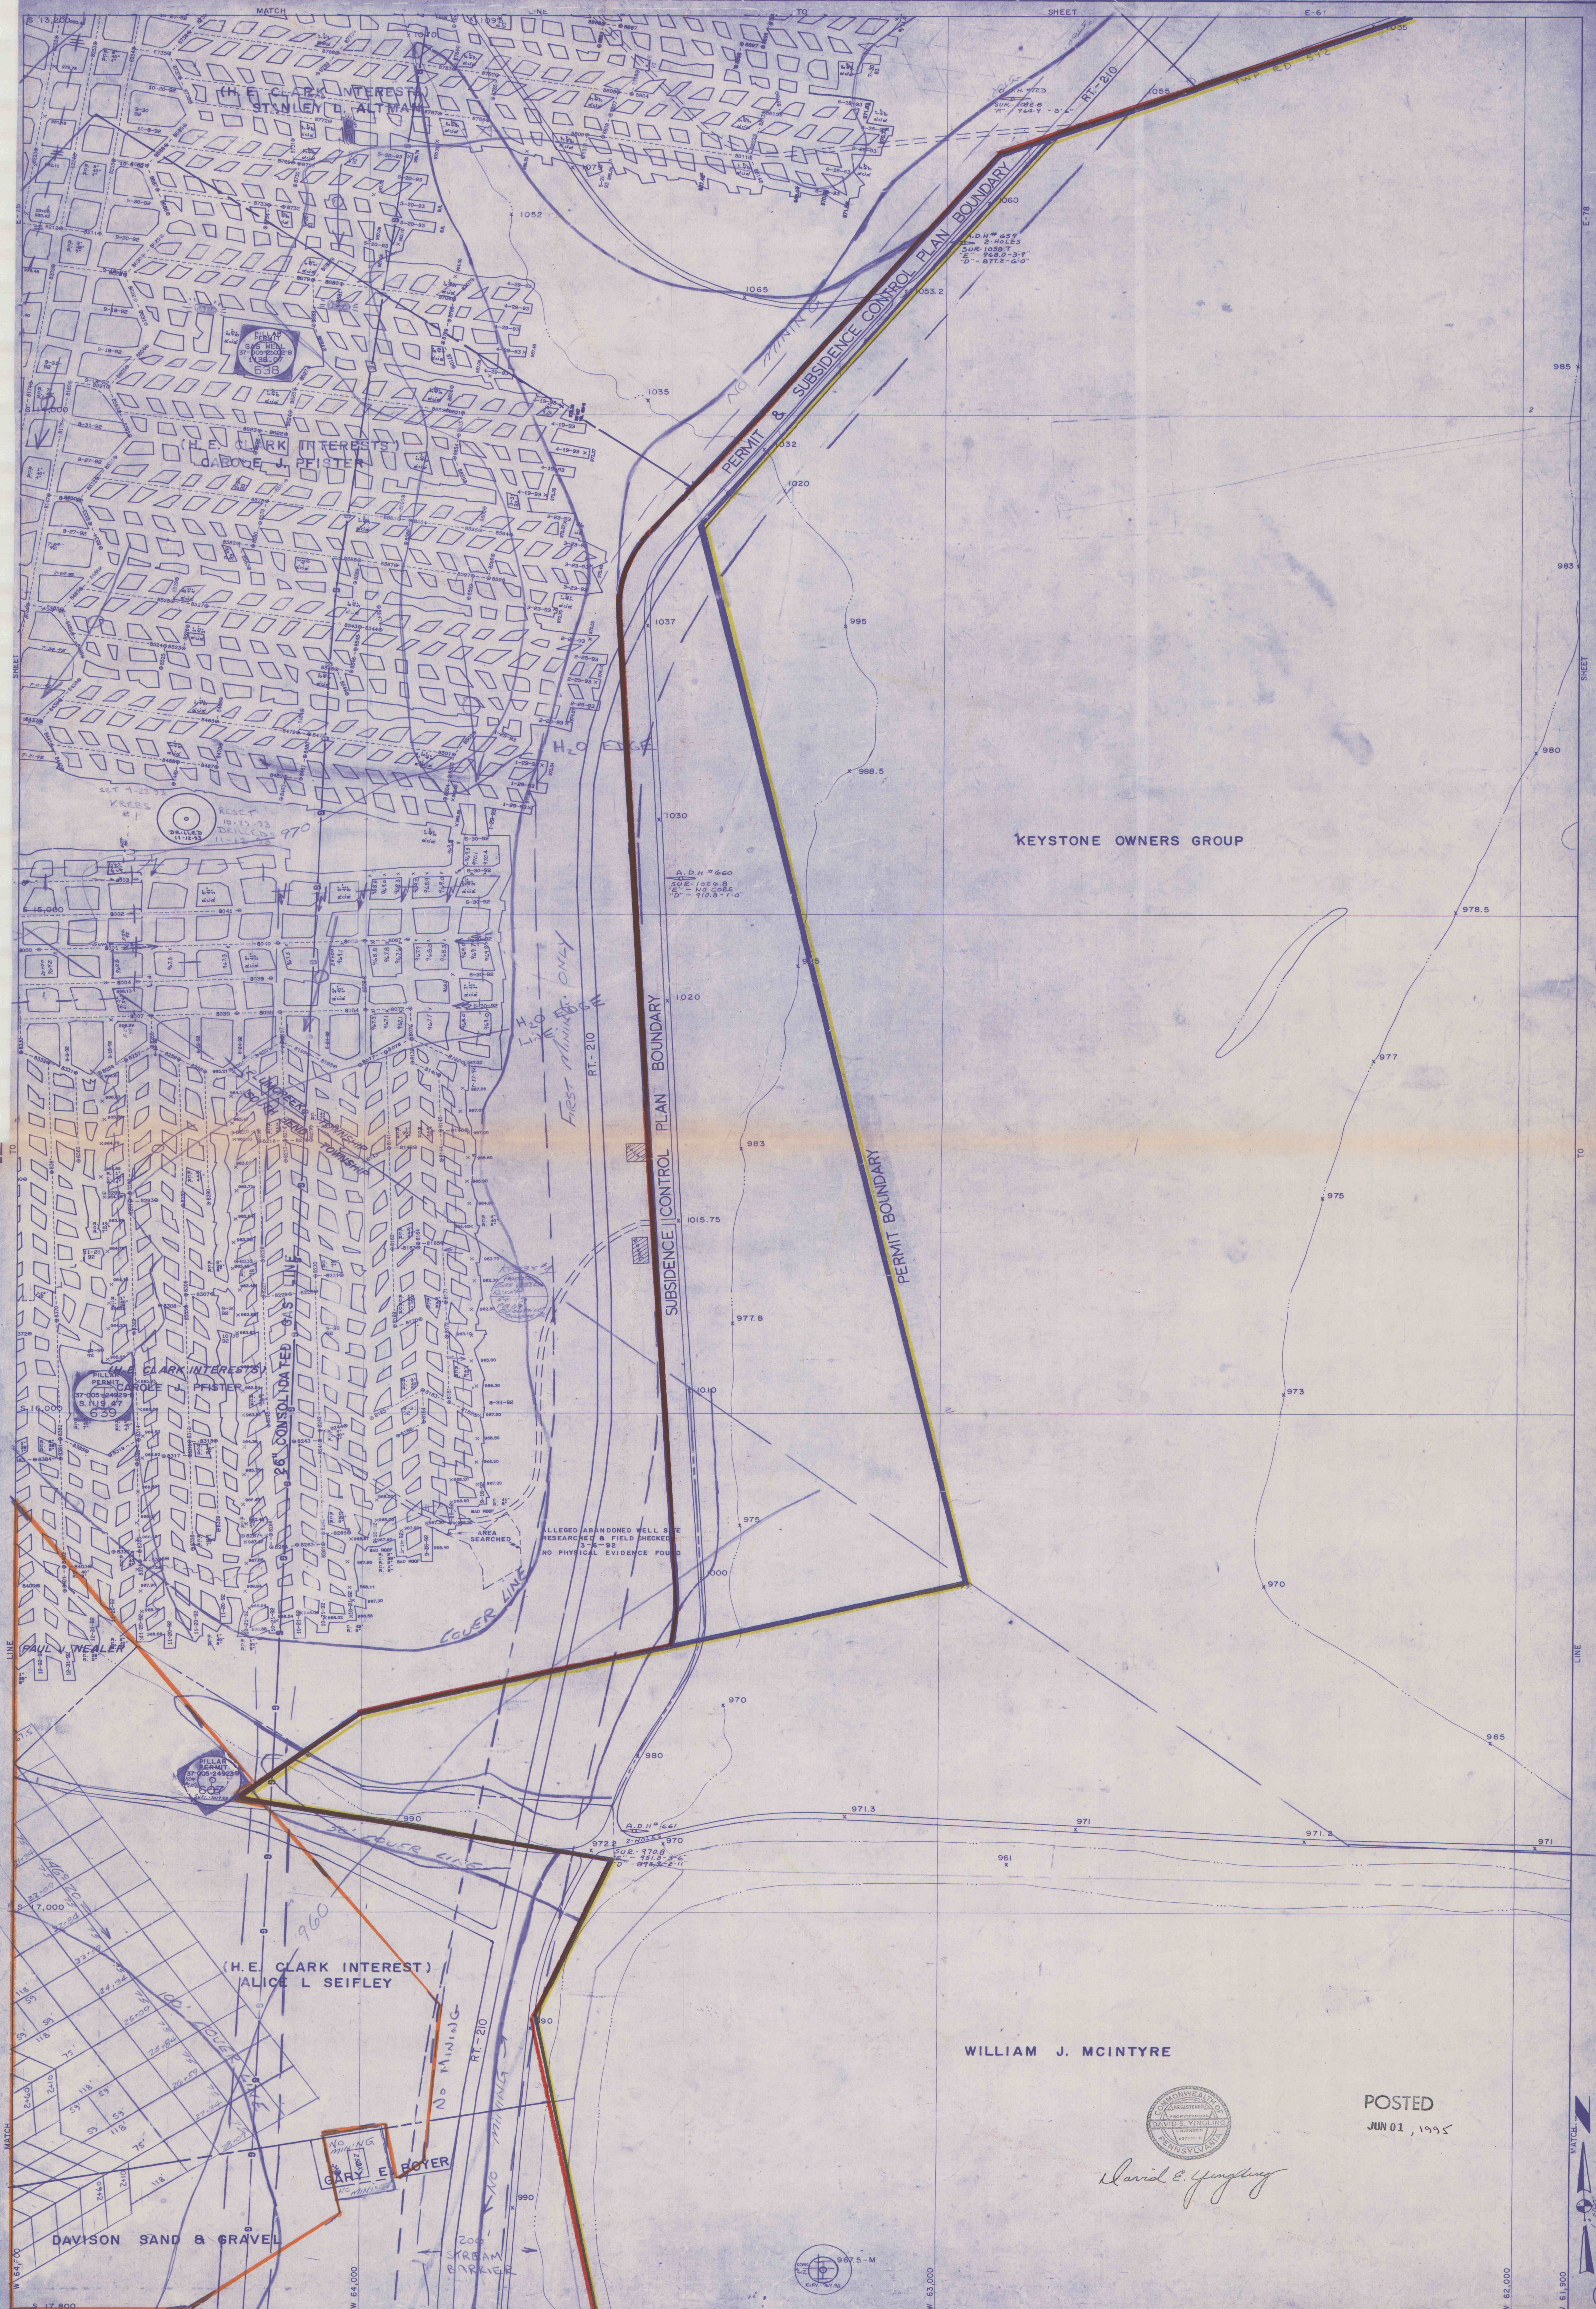

WILLIAM J. MCINTYRE



POSTED
JUN 01, 1995

David E. Jungling

GARY E. BOYER

NO MINING
200' STREAM
BARRIER

KEYSTONE COAL MINING CORPORATION EMILIE NO. 1 & 2 MINE UPPER FREEPORT COAL SEAM
PLUMCREEK & SOUTHBEND TOWNSHIPS ARMSTRONG COUNTY
CONTEMPLATED MINING FROM 6-1-95 TO 12-1-95

