


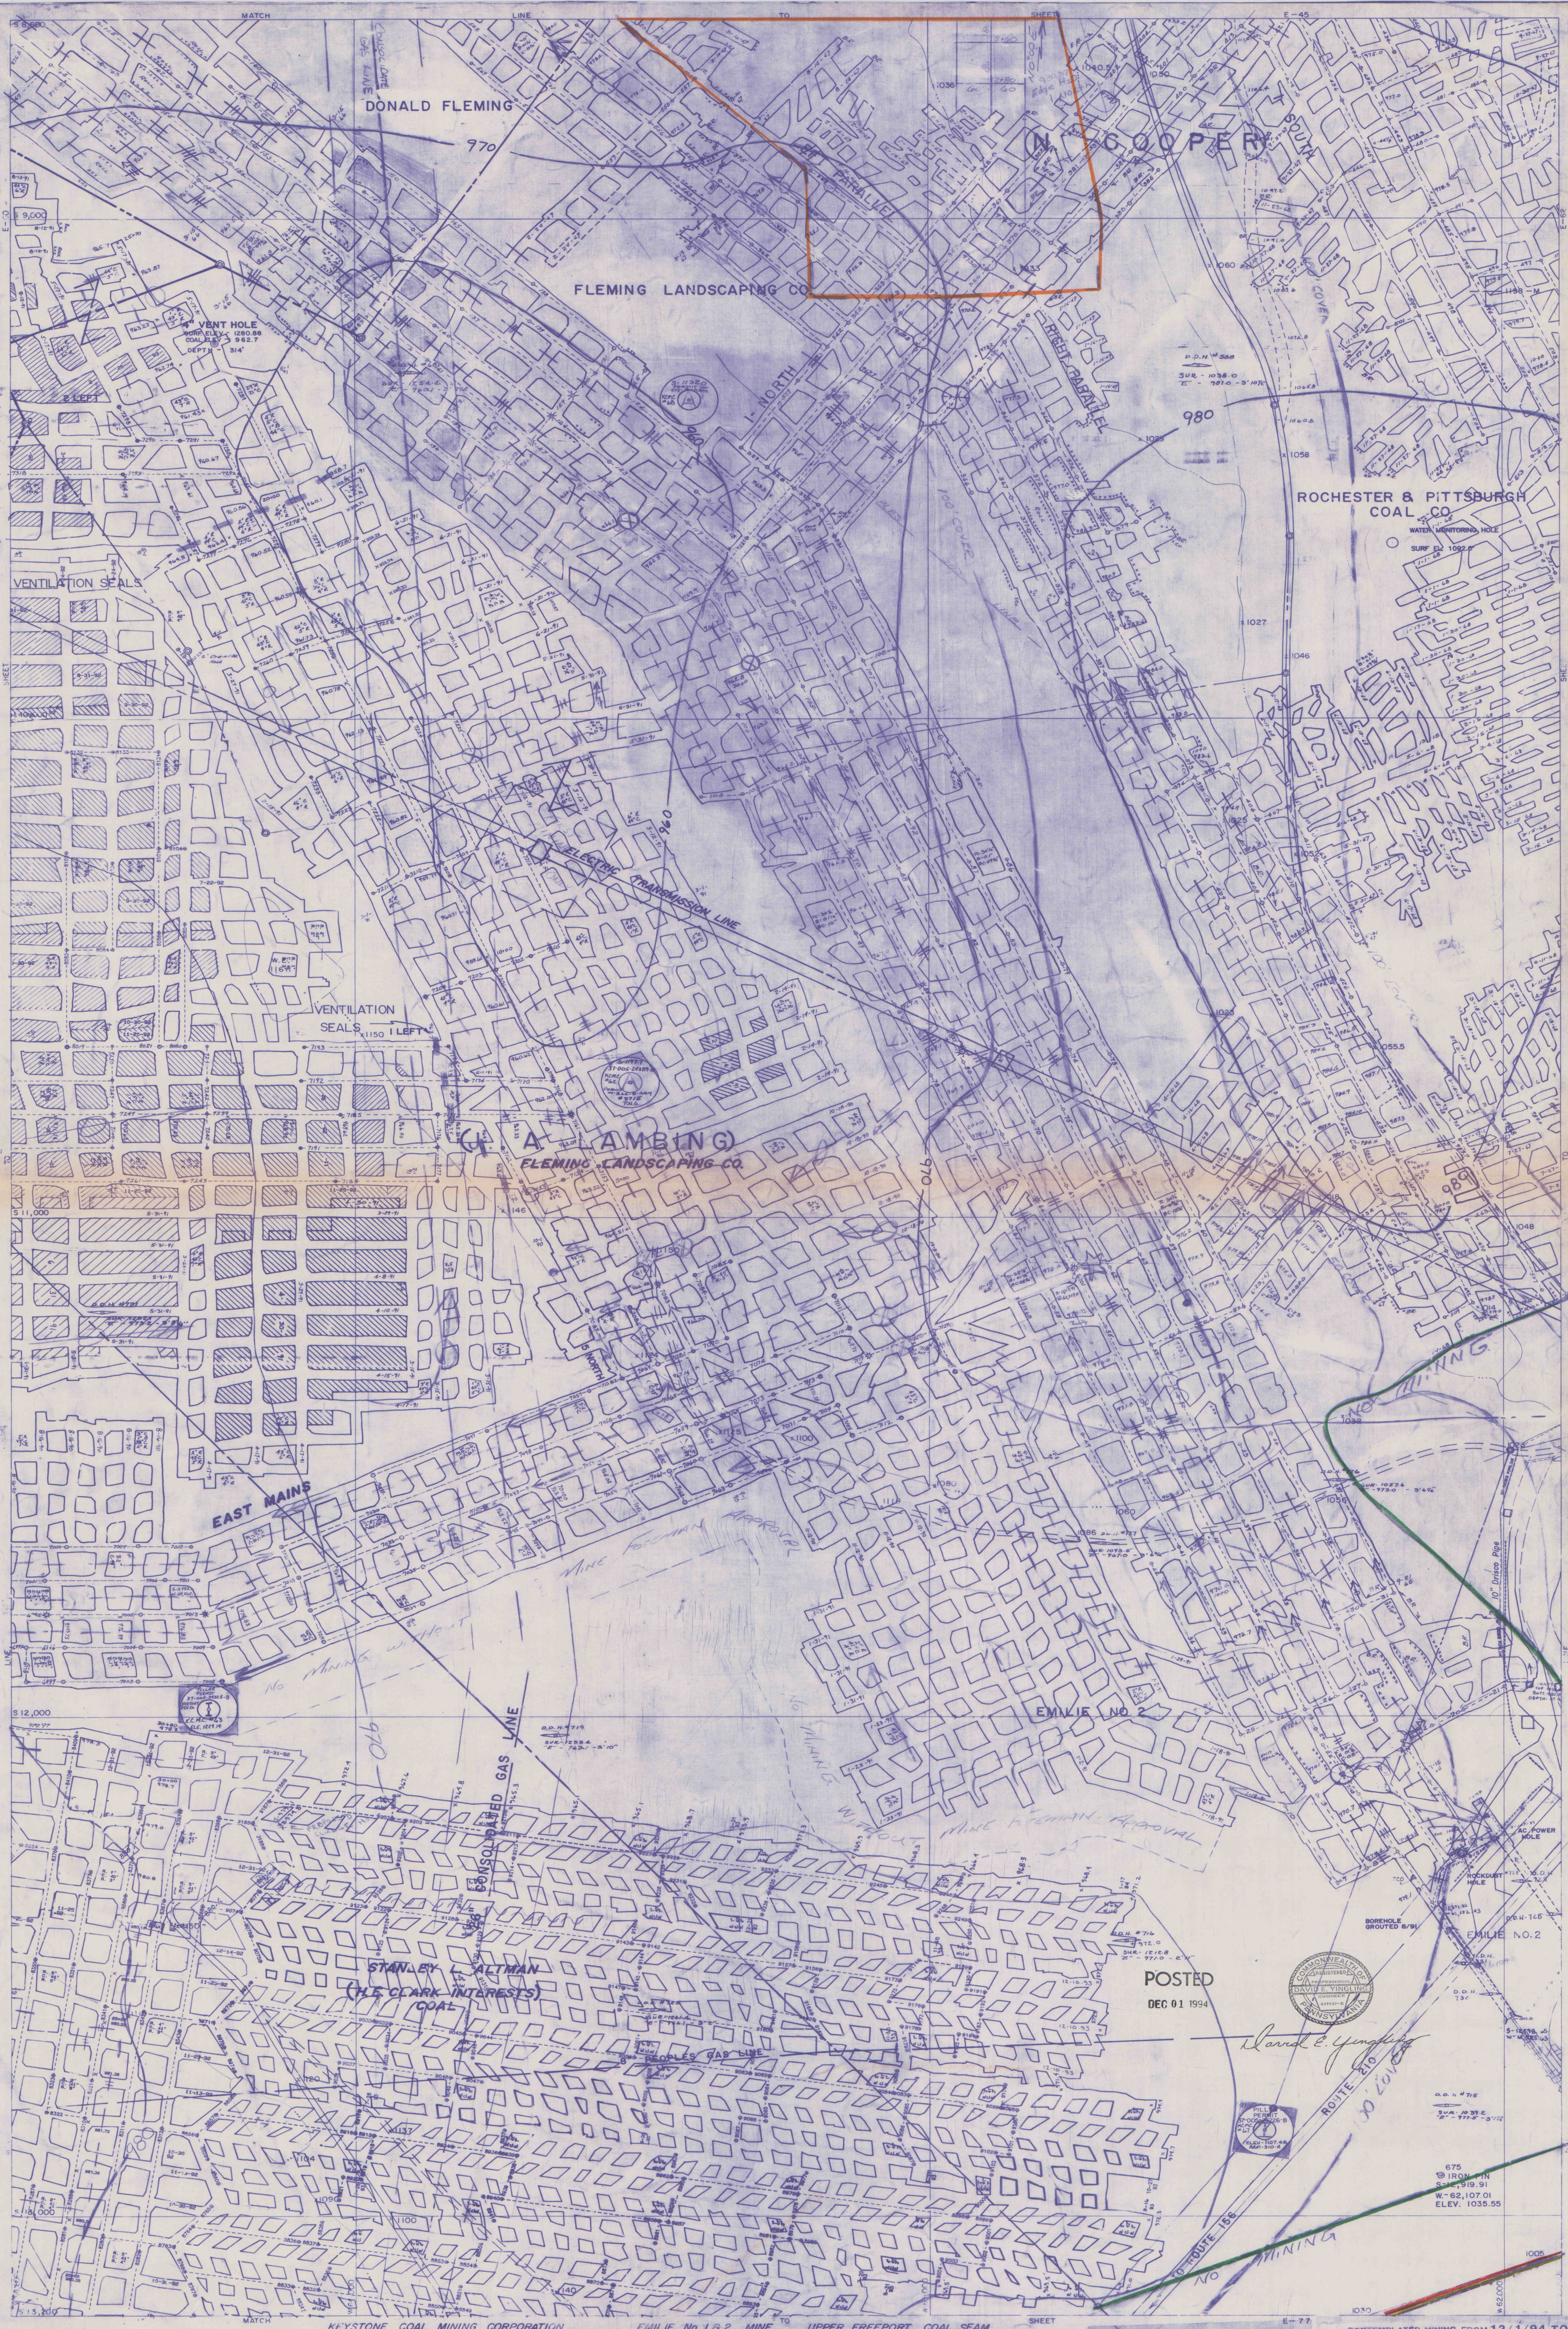

TRACING (E-6)

DRAWER

POSTED  
DEC 01 1994



*David E. Youngling*  
STATE ENGINEER

675  
W-62,107.01  
ELEV. 1035.55

KEYSTONE COAL MINING CORPORATION PLUMCREEK & SOUTH BEND LIPS  
EMILIE No. 1 & 2 MINE  
UPPER FREEPORT COAL SEAM  
COUNTY

CONTEMPLATED MINING FROM 12/1/94 TO 6/1/95

TRACING (E-6)

(E-6)