


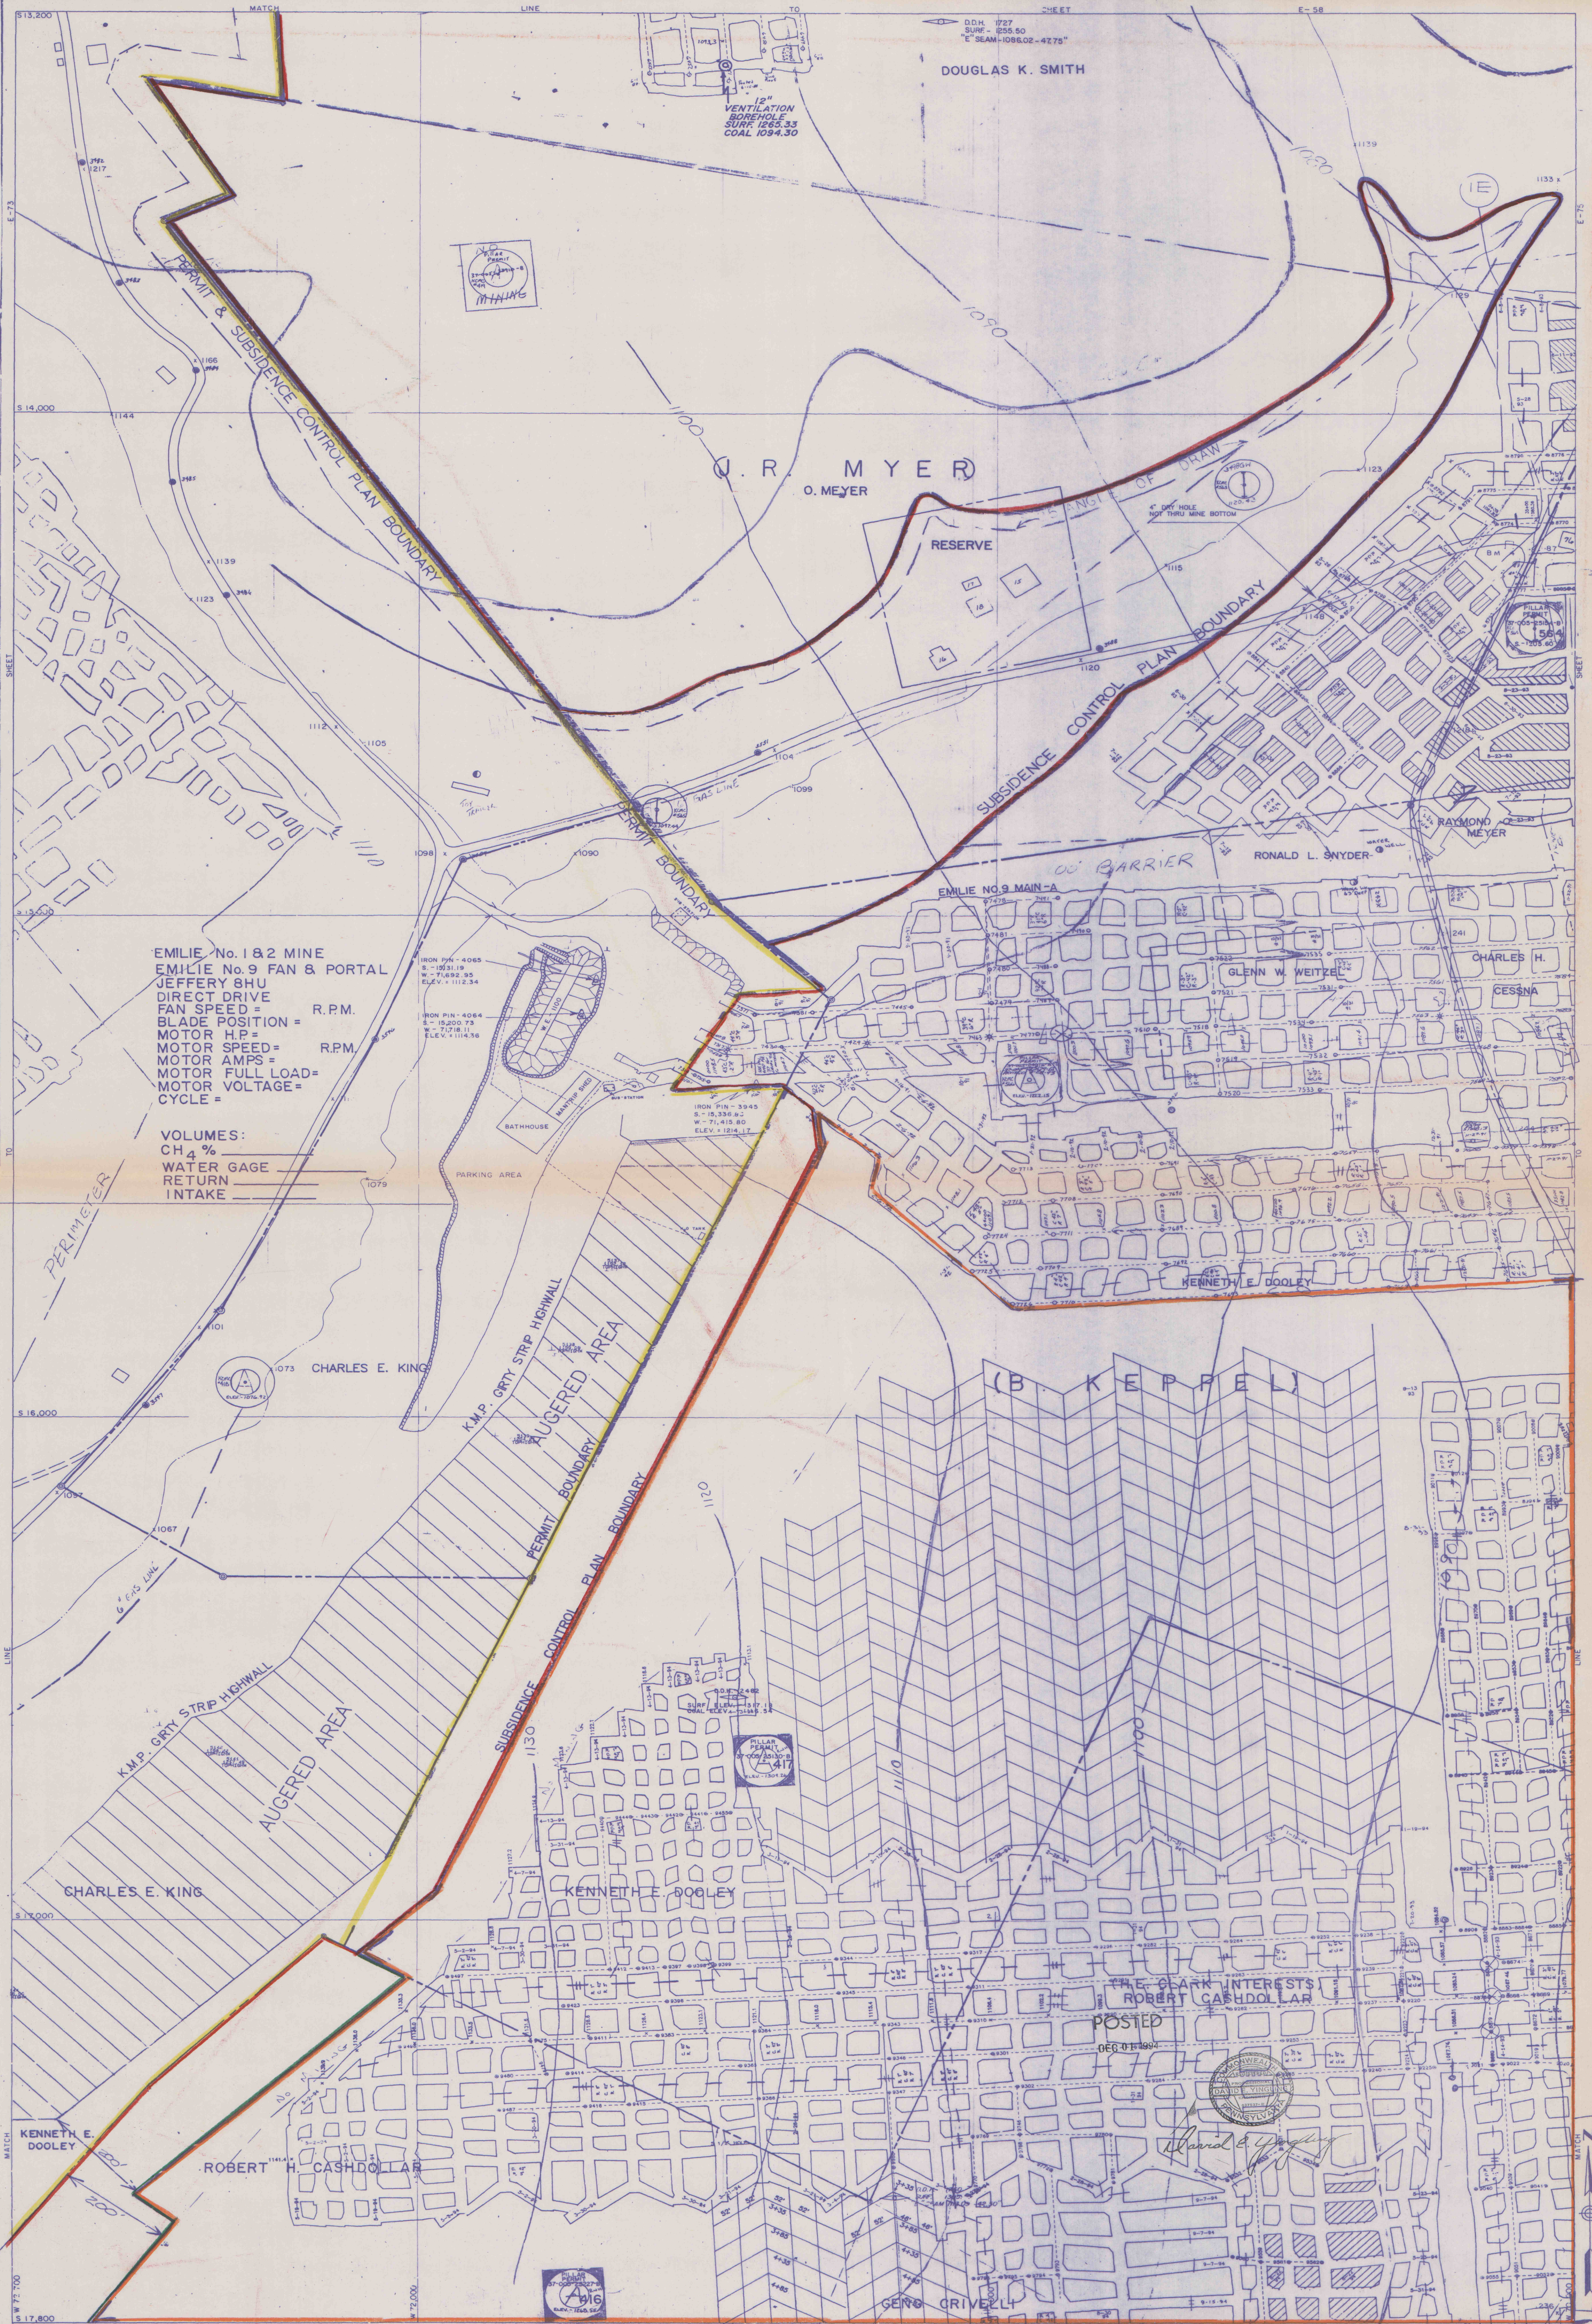

EMILIE No. 1 & 2 MINE
EMILIE No. 9 FAN & PORTAL
JEFFERY 8HU
DIRECT DRIVE
FAN SPEED = R.P.M.
BLADE POSITION = R.P.M.
MOTOR H.P. =
MOTOR SPEED =
MOTOR AMPS =
MOTOR FULL LOAD =
MOTOR VOLTAGE =
CYCLE =

VOLUMES:
CH 4 %
WATER GAGE
RETURN
INTAKE

IRON PIN - 4065
S - 12931.19
W - 71682.95
ELEV - 1112.34

IRON PIN - 4064
S - 15200.73
W - 71718.11
ELEV - 1114.36

IRON PIN - 3945
S - 15336.62
W - 71410.80
ELEV - 1124.17

K.M.P. GRTY STRIP HIGHWALL
AUGERED AREA
PERMIT BOUNDARY
SUBSIDENCE CONTROL PLAN BOUNDARY

CHARLES E. KING

KENNETH E. DOOLEY

ROBERT H. CASHDOLLAR

THE CLARK INTERESTS
ROBERT CASHDOLLAR