


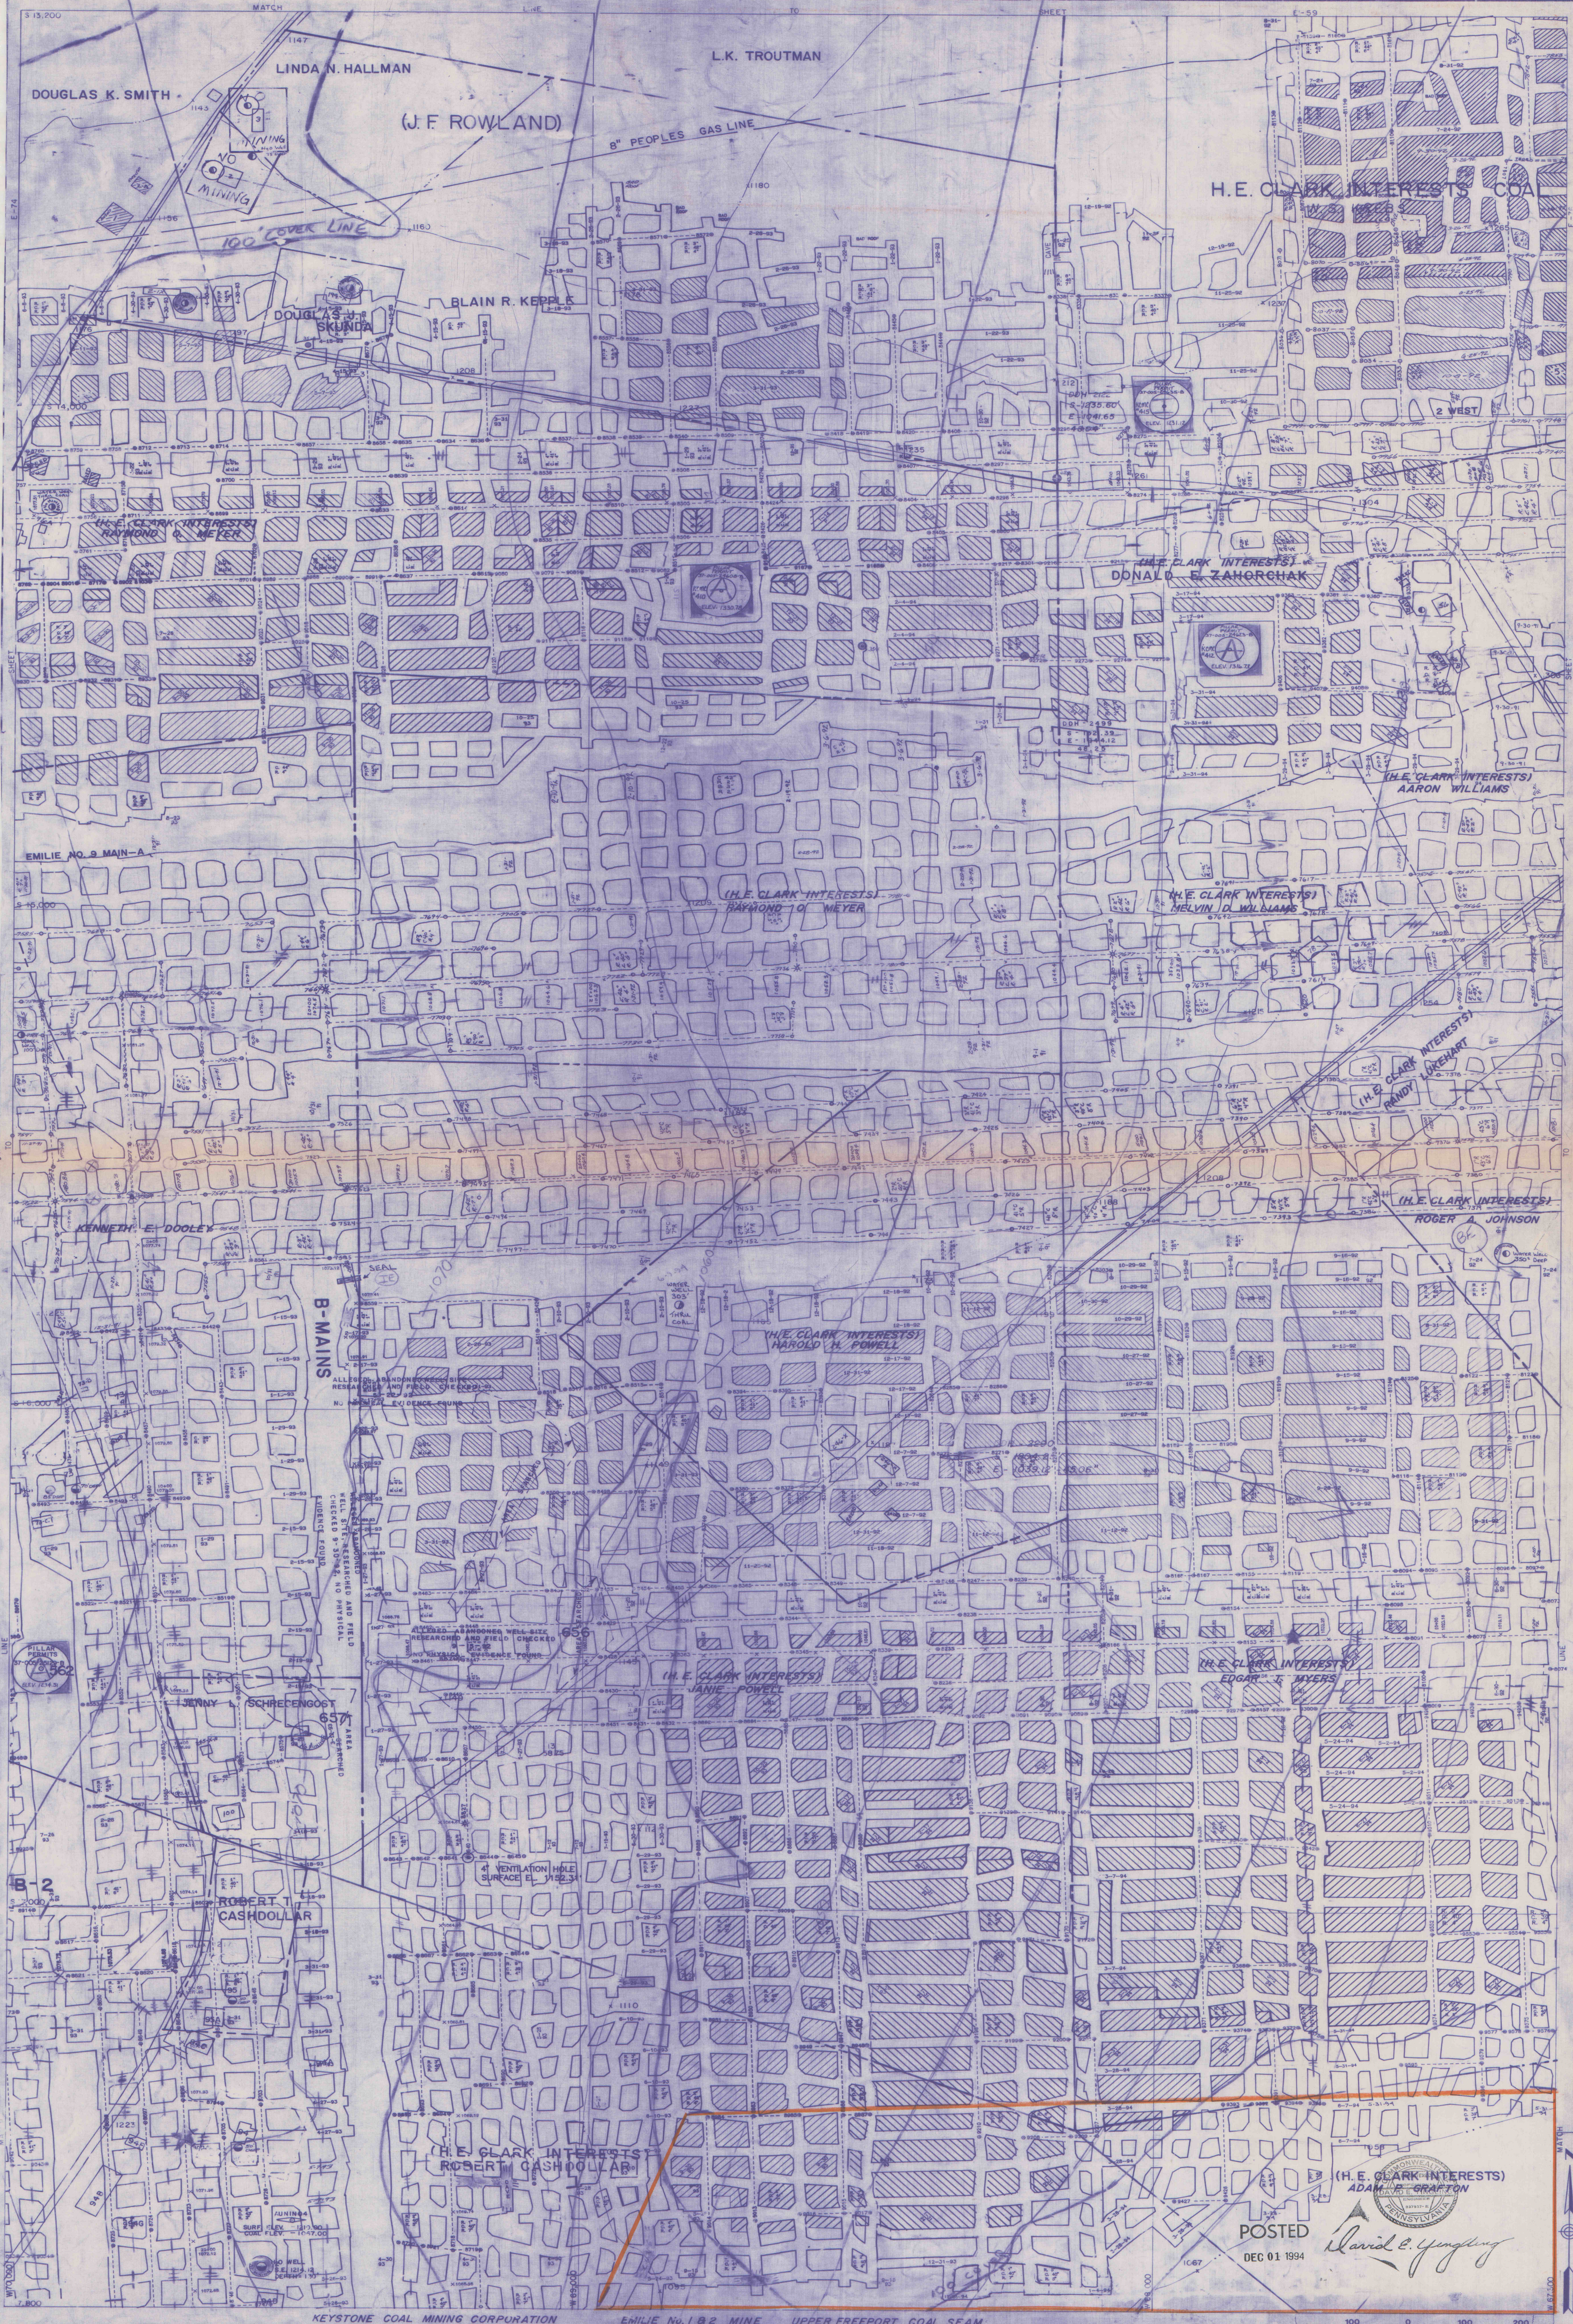

KEYSTONE COAL MINING CORPORATION
PLUMCREEK & SOUTH BEND TOWNSHIPS
EMILIE No. 1 & 2 MINE
UPPER FREEPORT COAL SEAM
ARMSTRONG COUNTY

CONTEMPLATED MINING FROM 12/1/94 TO 6/1/95

POSTED
DEC 01 1994
David E. Jungling



(H.E. CLARK INTERESTS)
ADAM E. GRAFTON

David E. Jungling

DEC 01 1994

1"=100'

0 100 200 feet

TRACING E-76

DRAWER

E-75