




TRACING

DRAWER

RACING

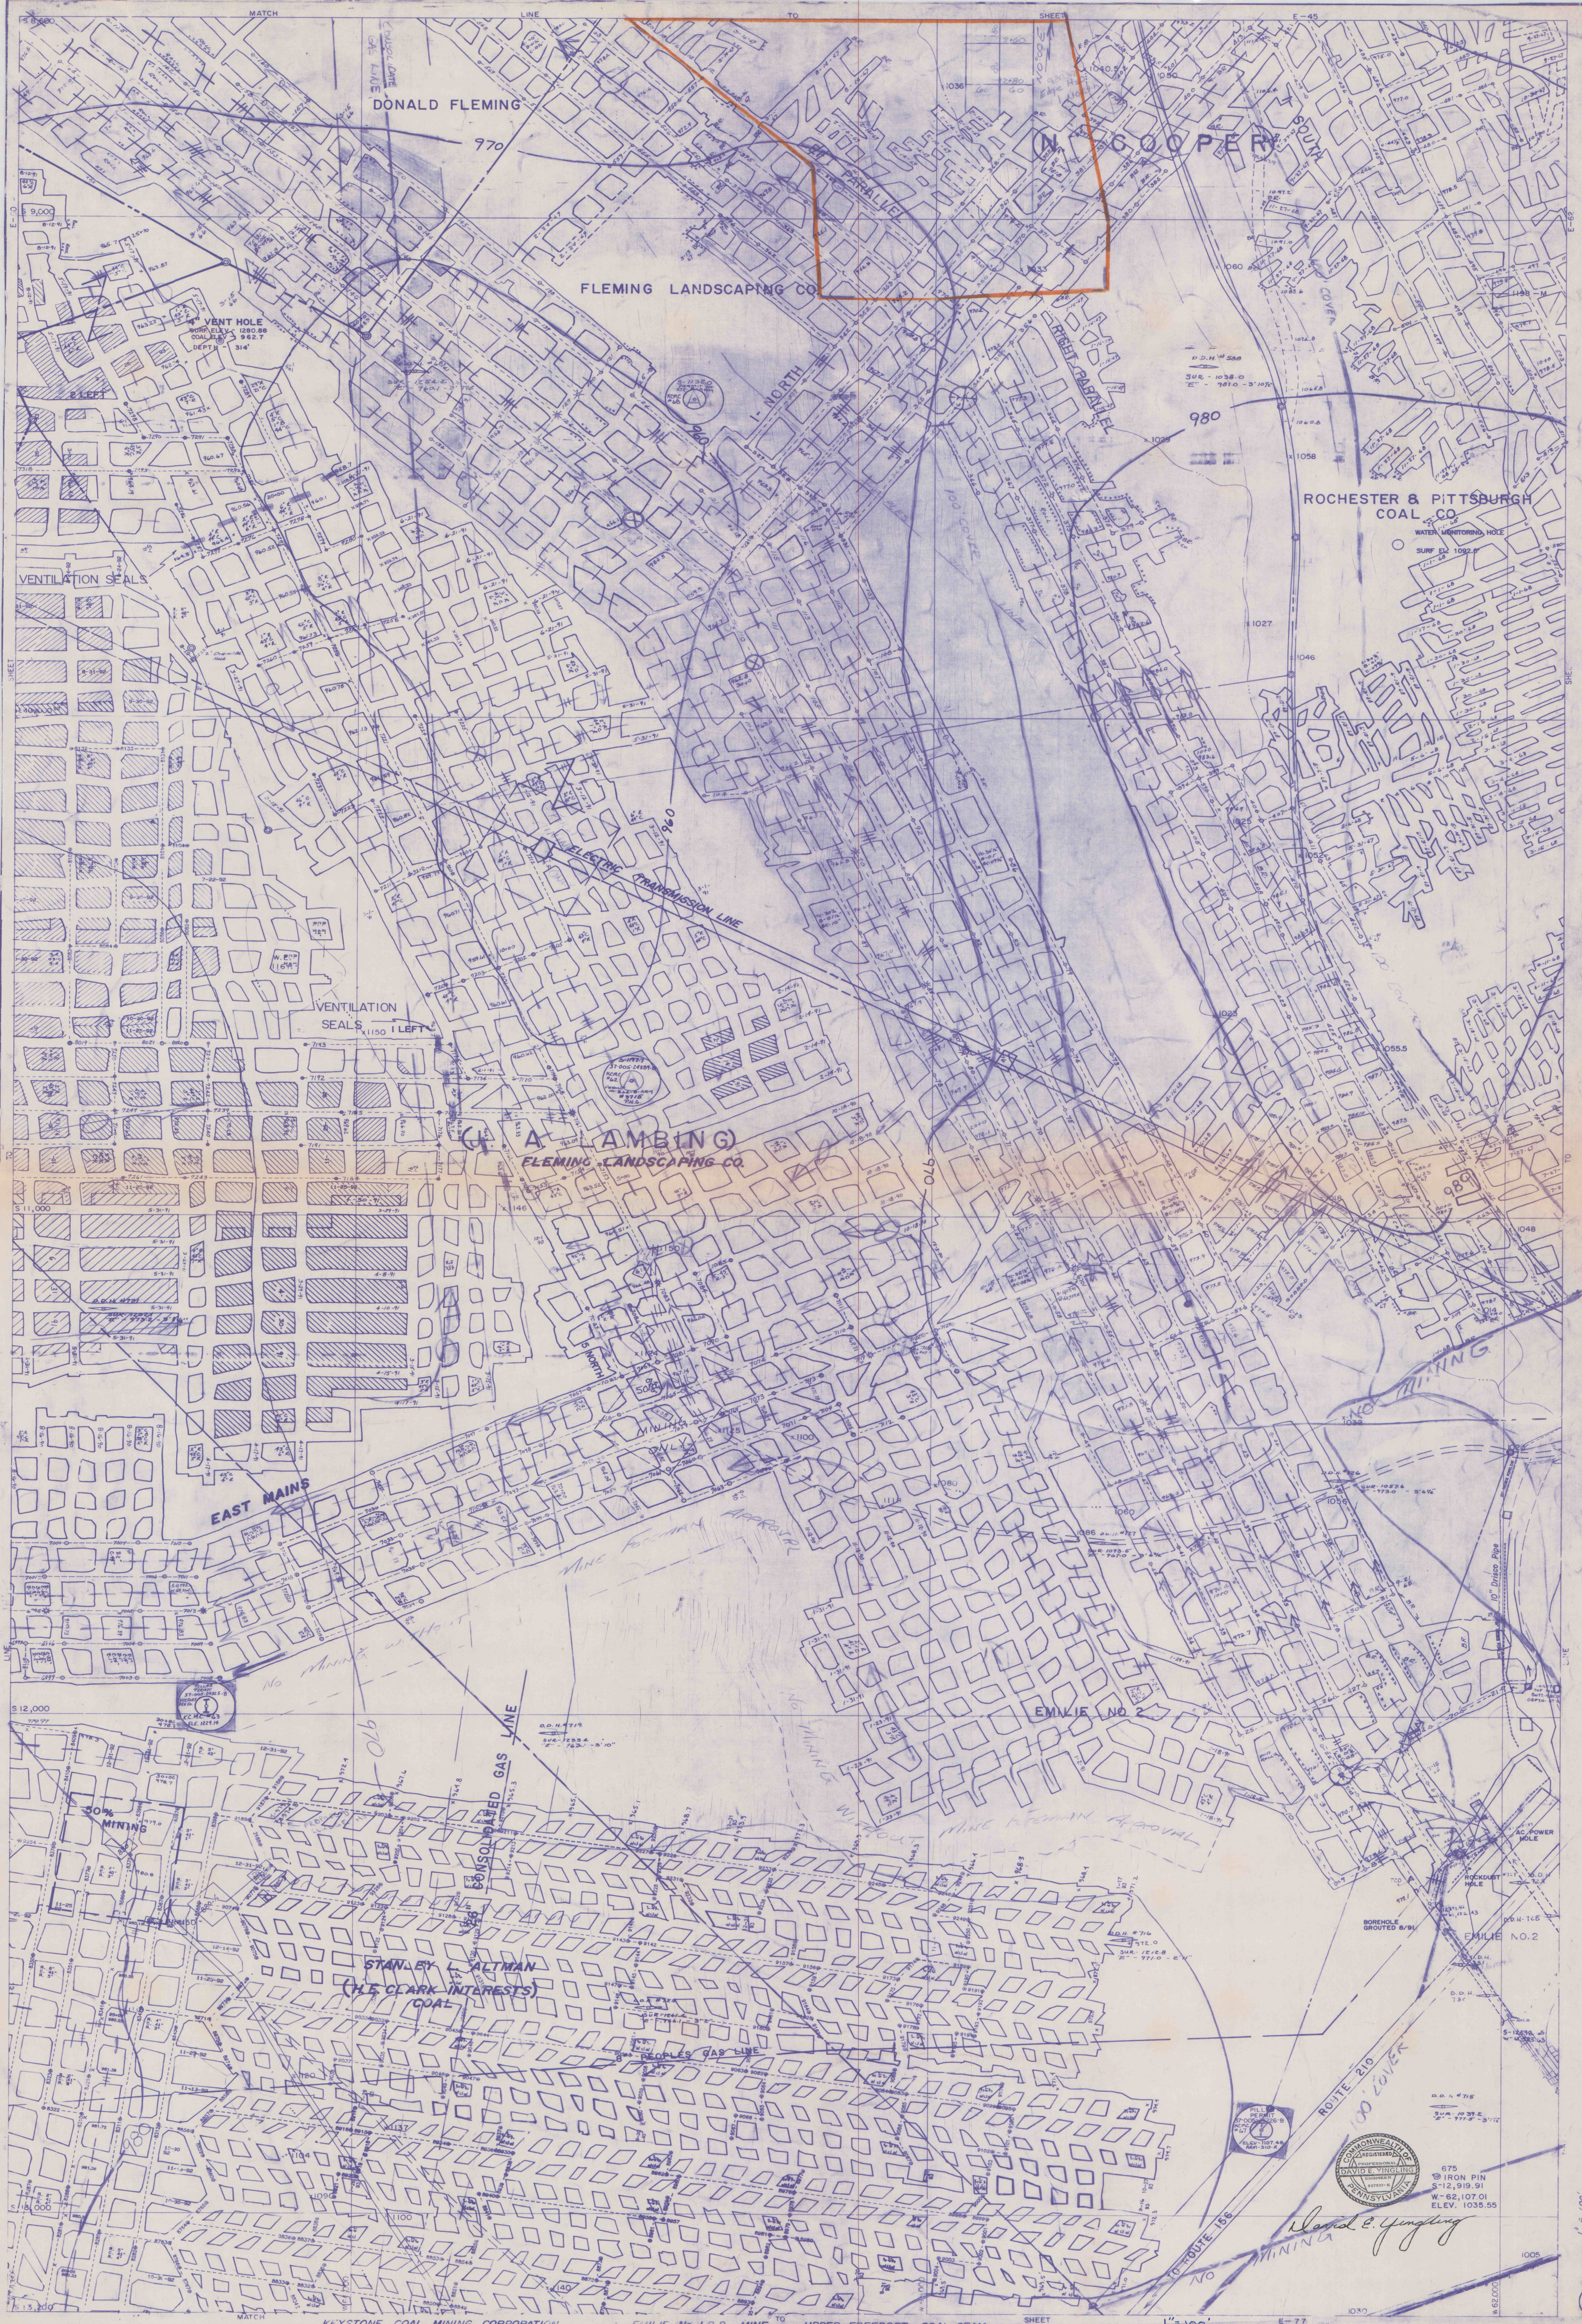

675  
IRON PIN  
S-12-919.91  
W-62-107.01  
ELEV. 1035.55