


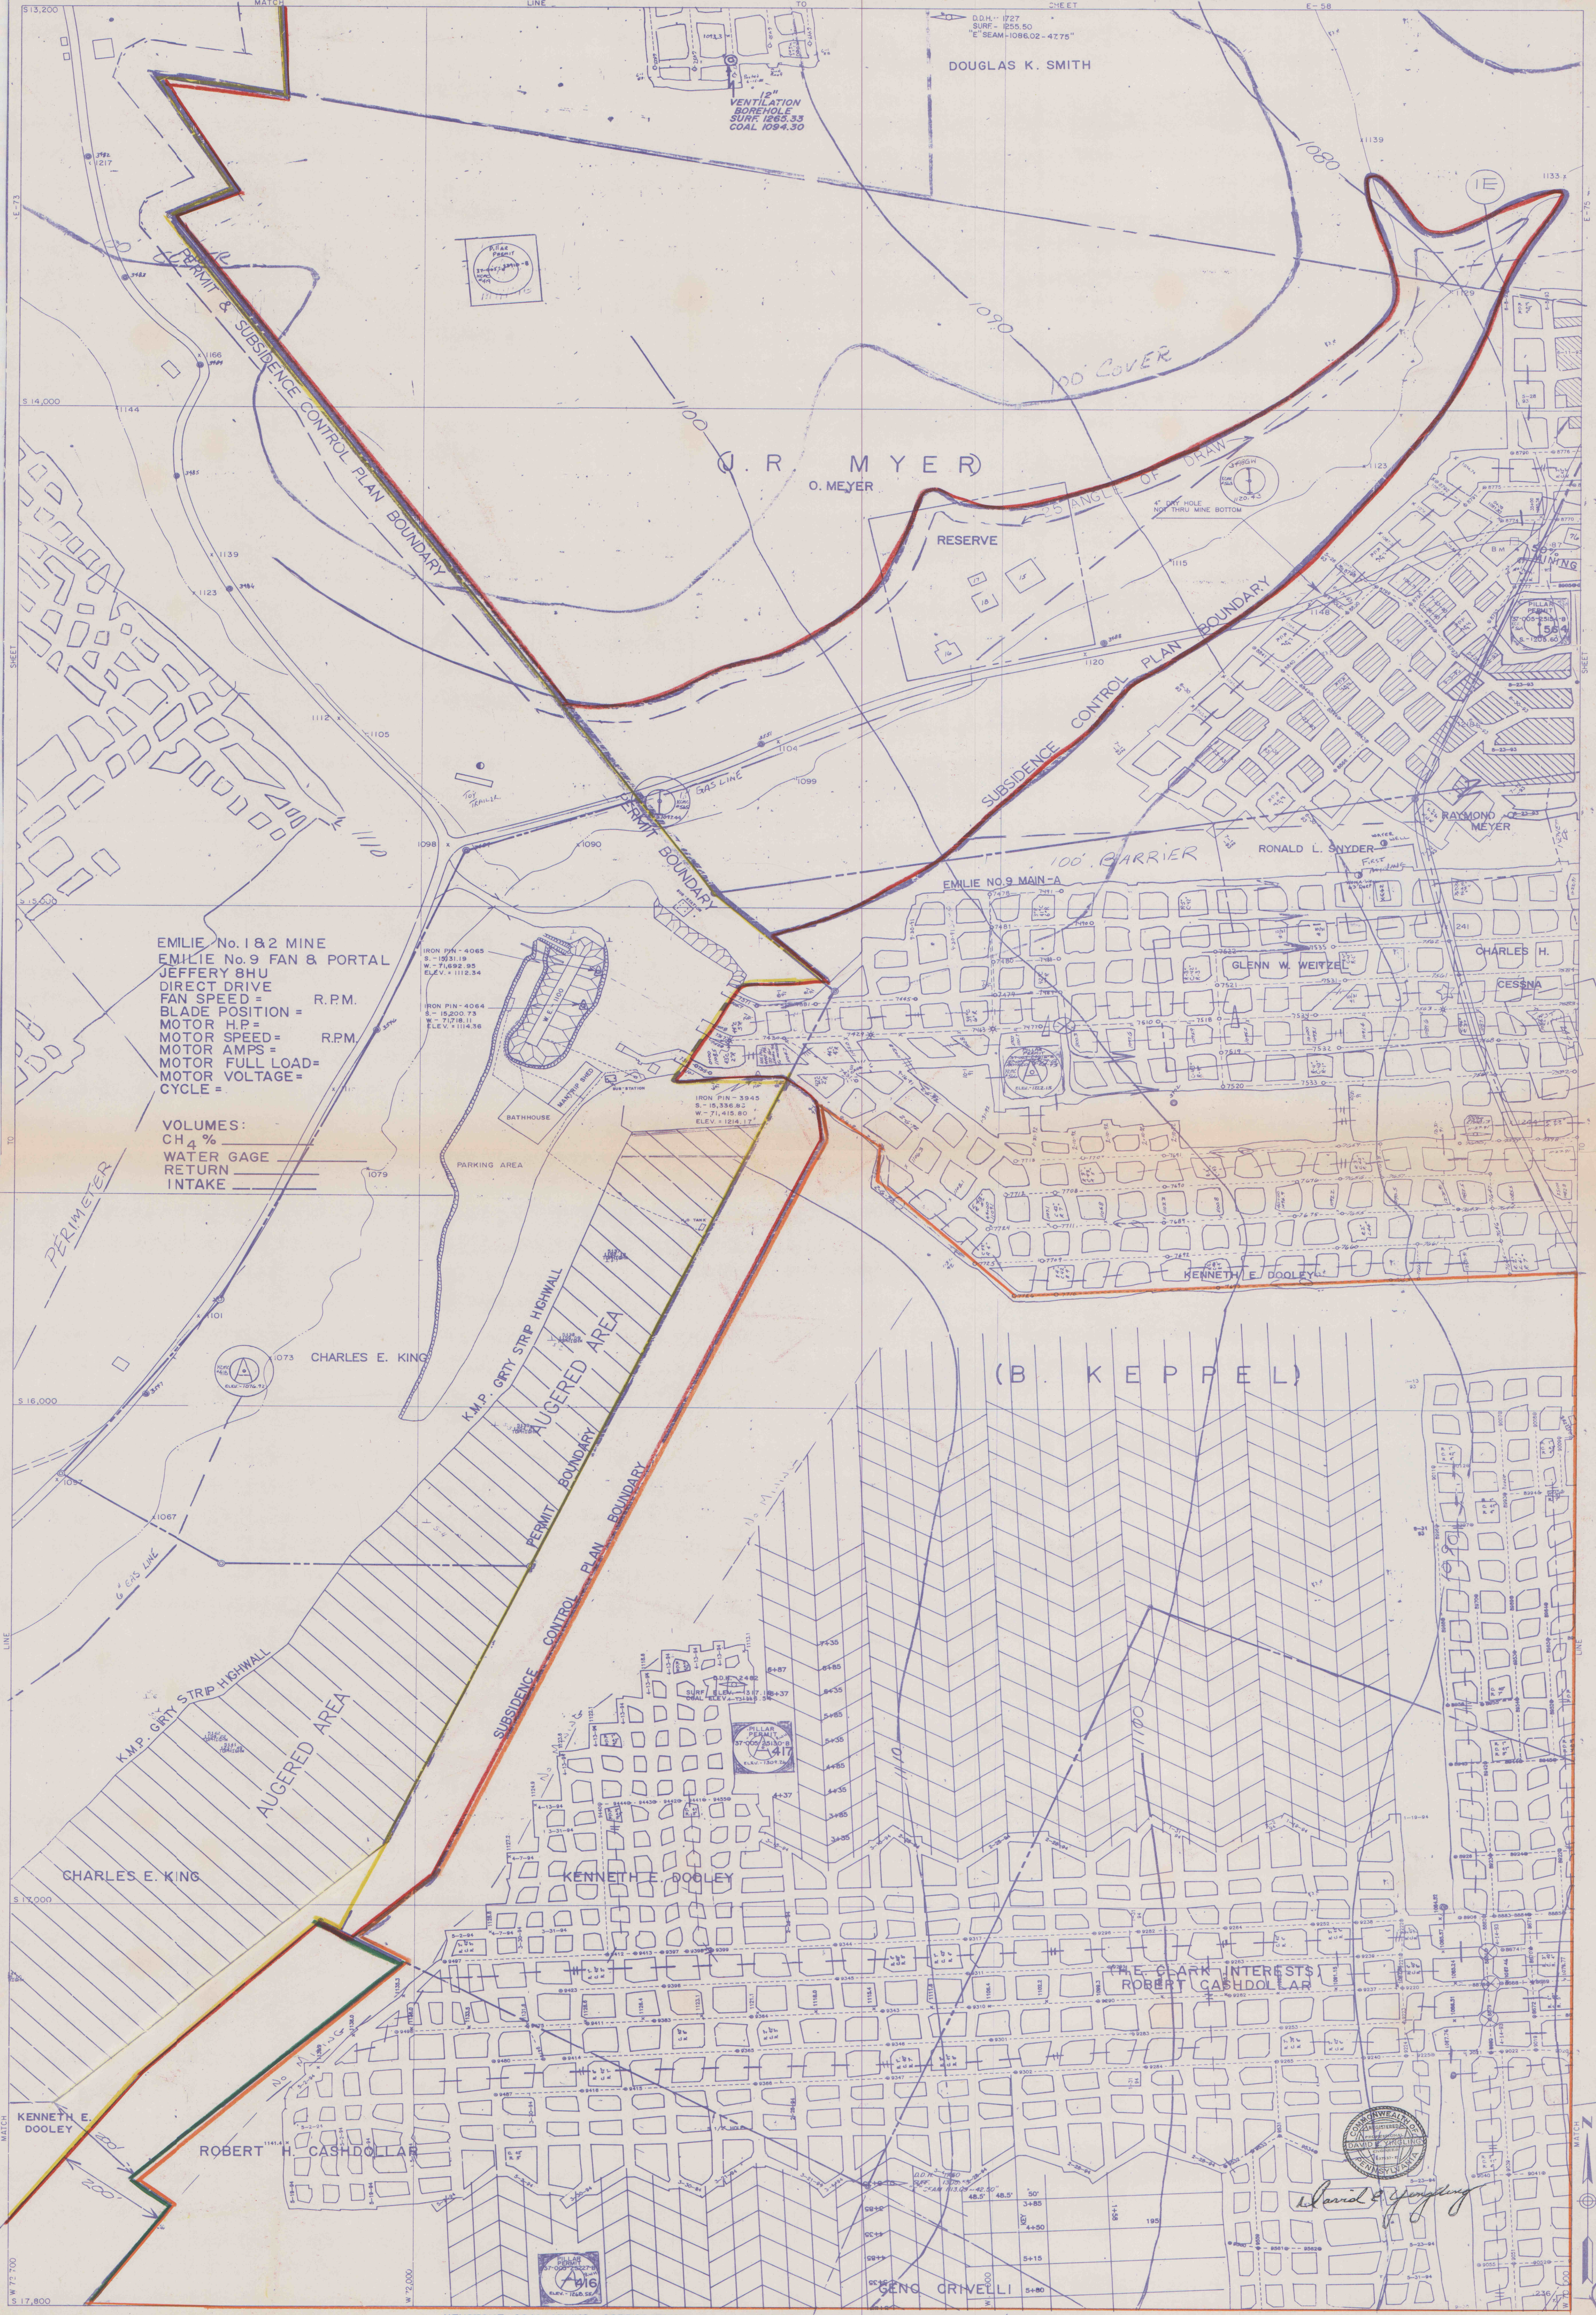

EMILIE No. 182 MINE
EMILIE No. 9 FAN & PORTAL
JEFFERY 8HU
DIRECT DRIVE
FAN SPEED = R.P.M.

VOLUMES:
CH₄ %
WATER GAGE
RETURN
INTAKE

