


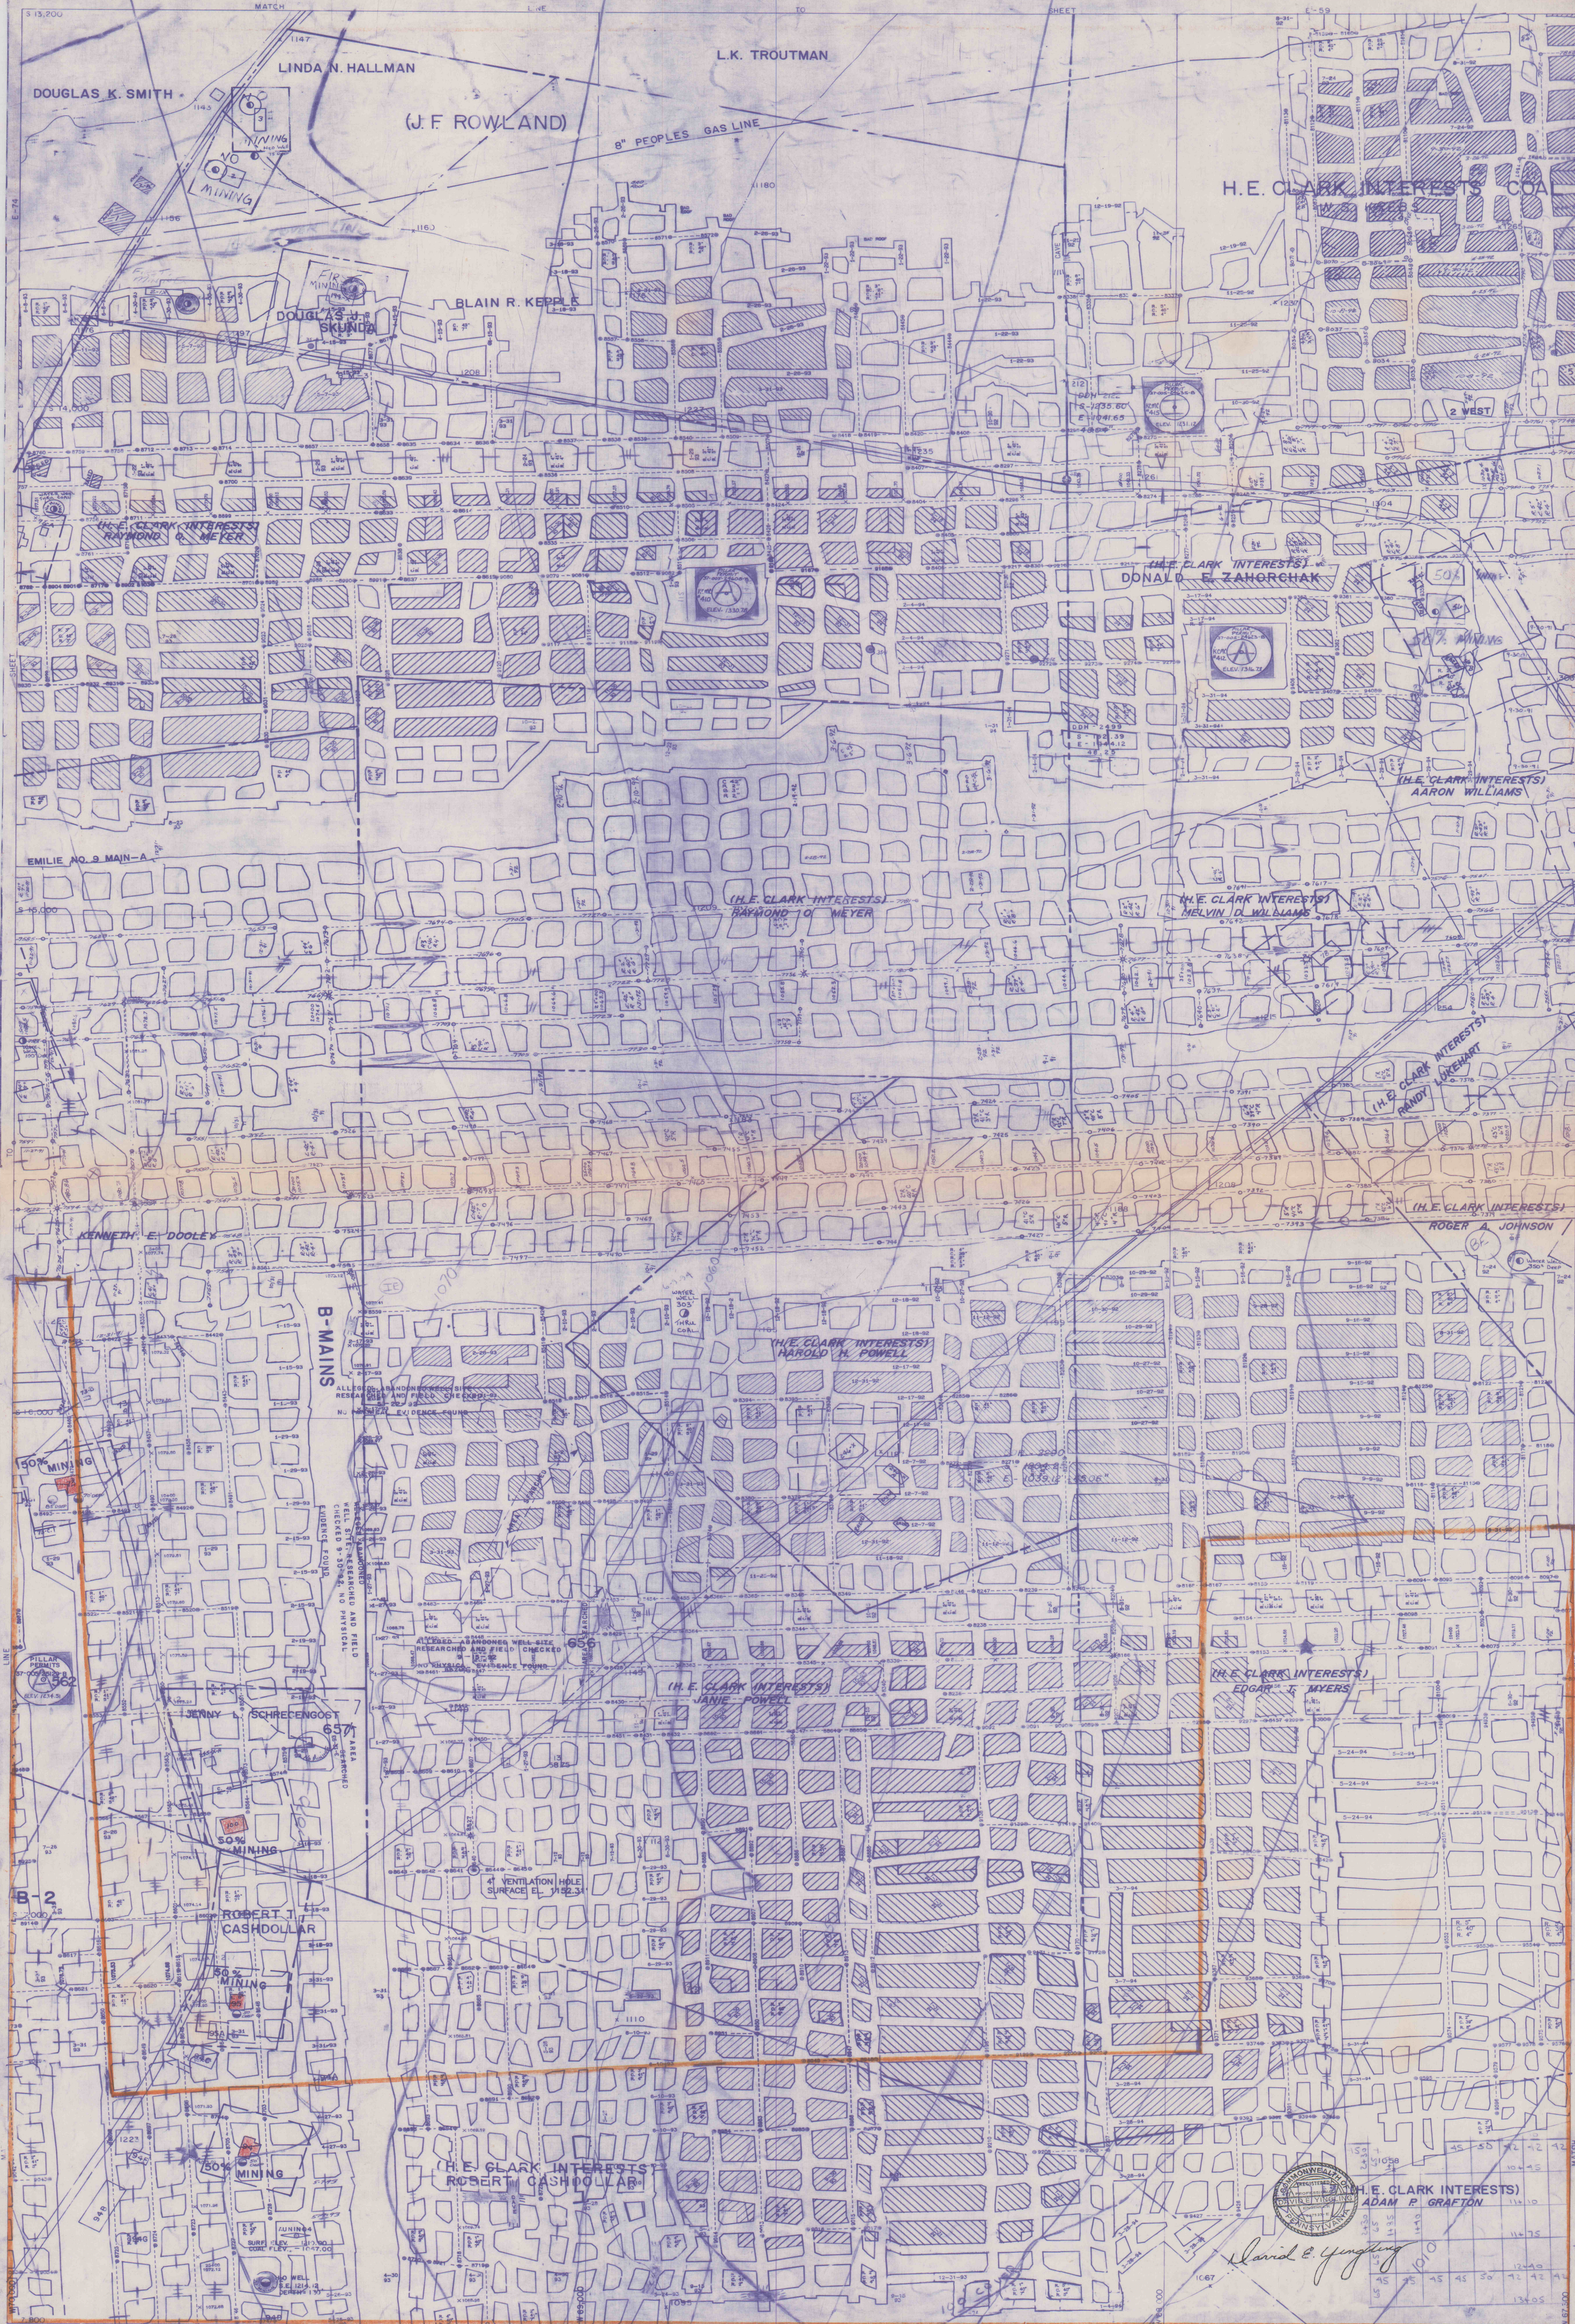

David & Yangling

TRACING E-75

DRAWER

E75