


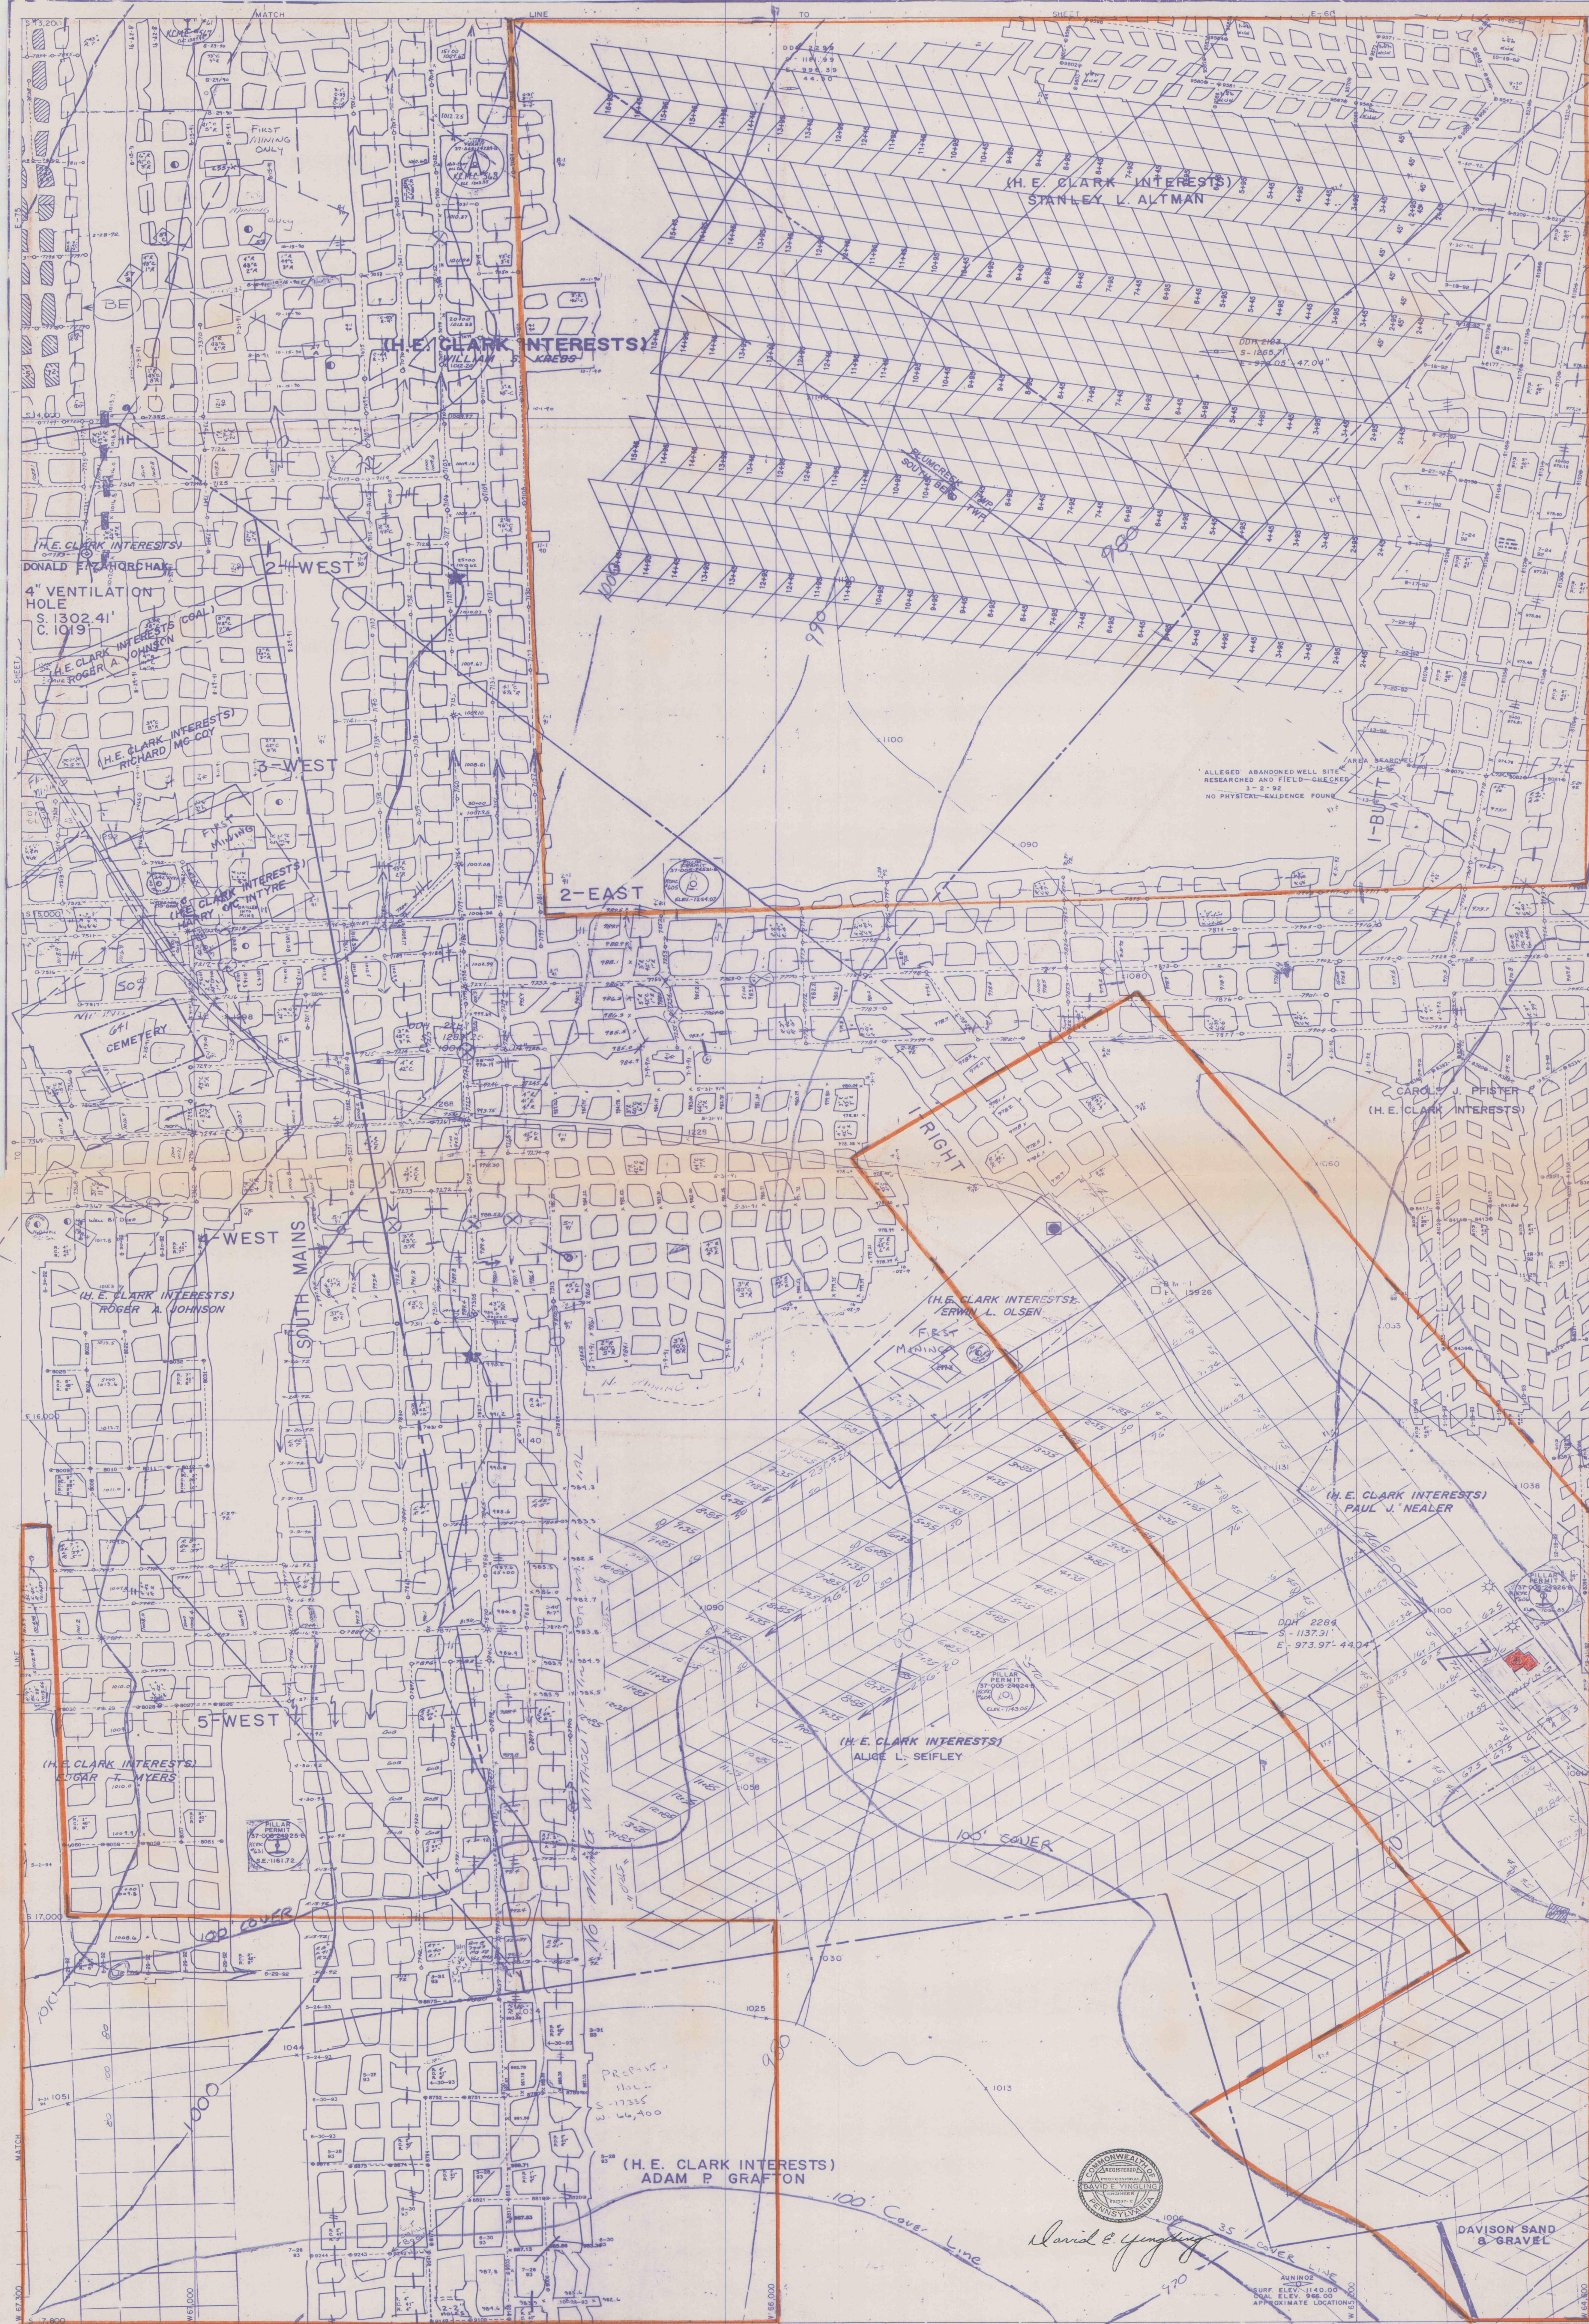

DRAWER