


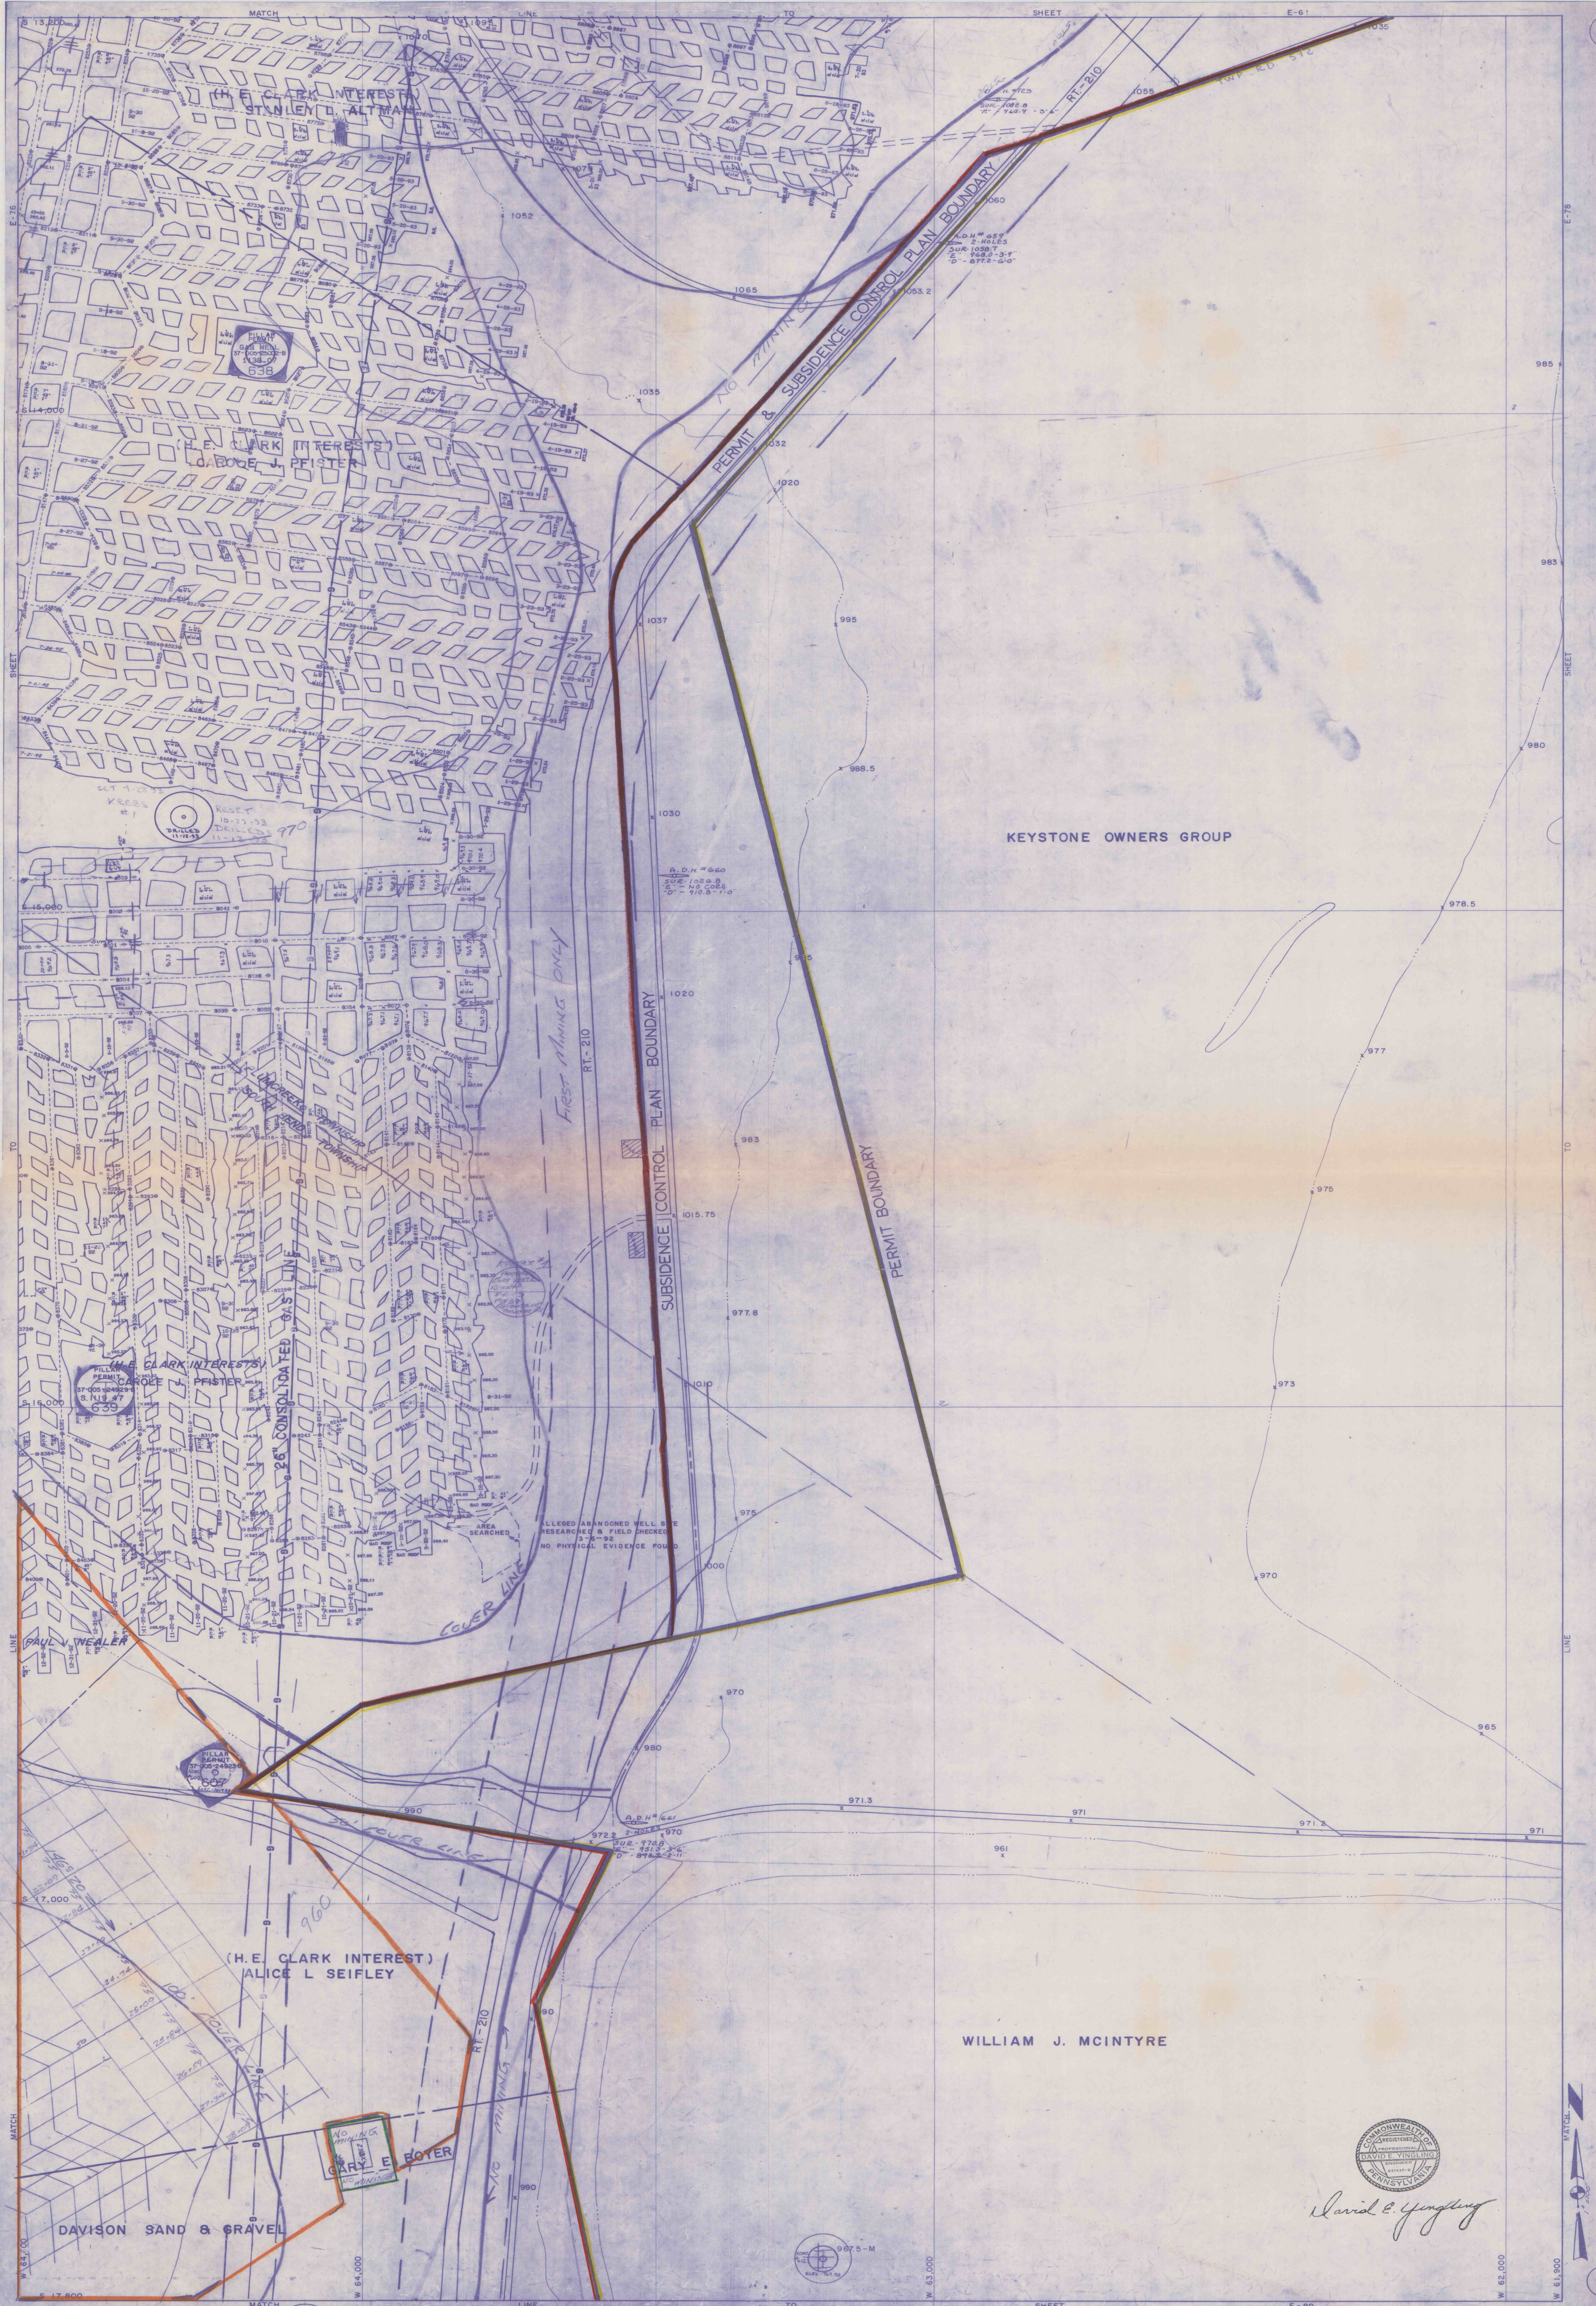

David E. Vingling