


DRAWER 132

H TO SHEET N-12

MATCH TO SHEET N-14

DRAWER 132

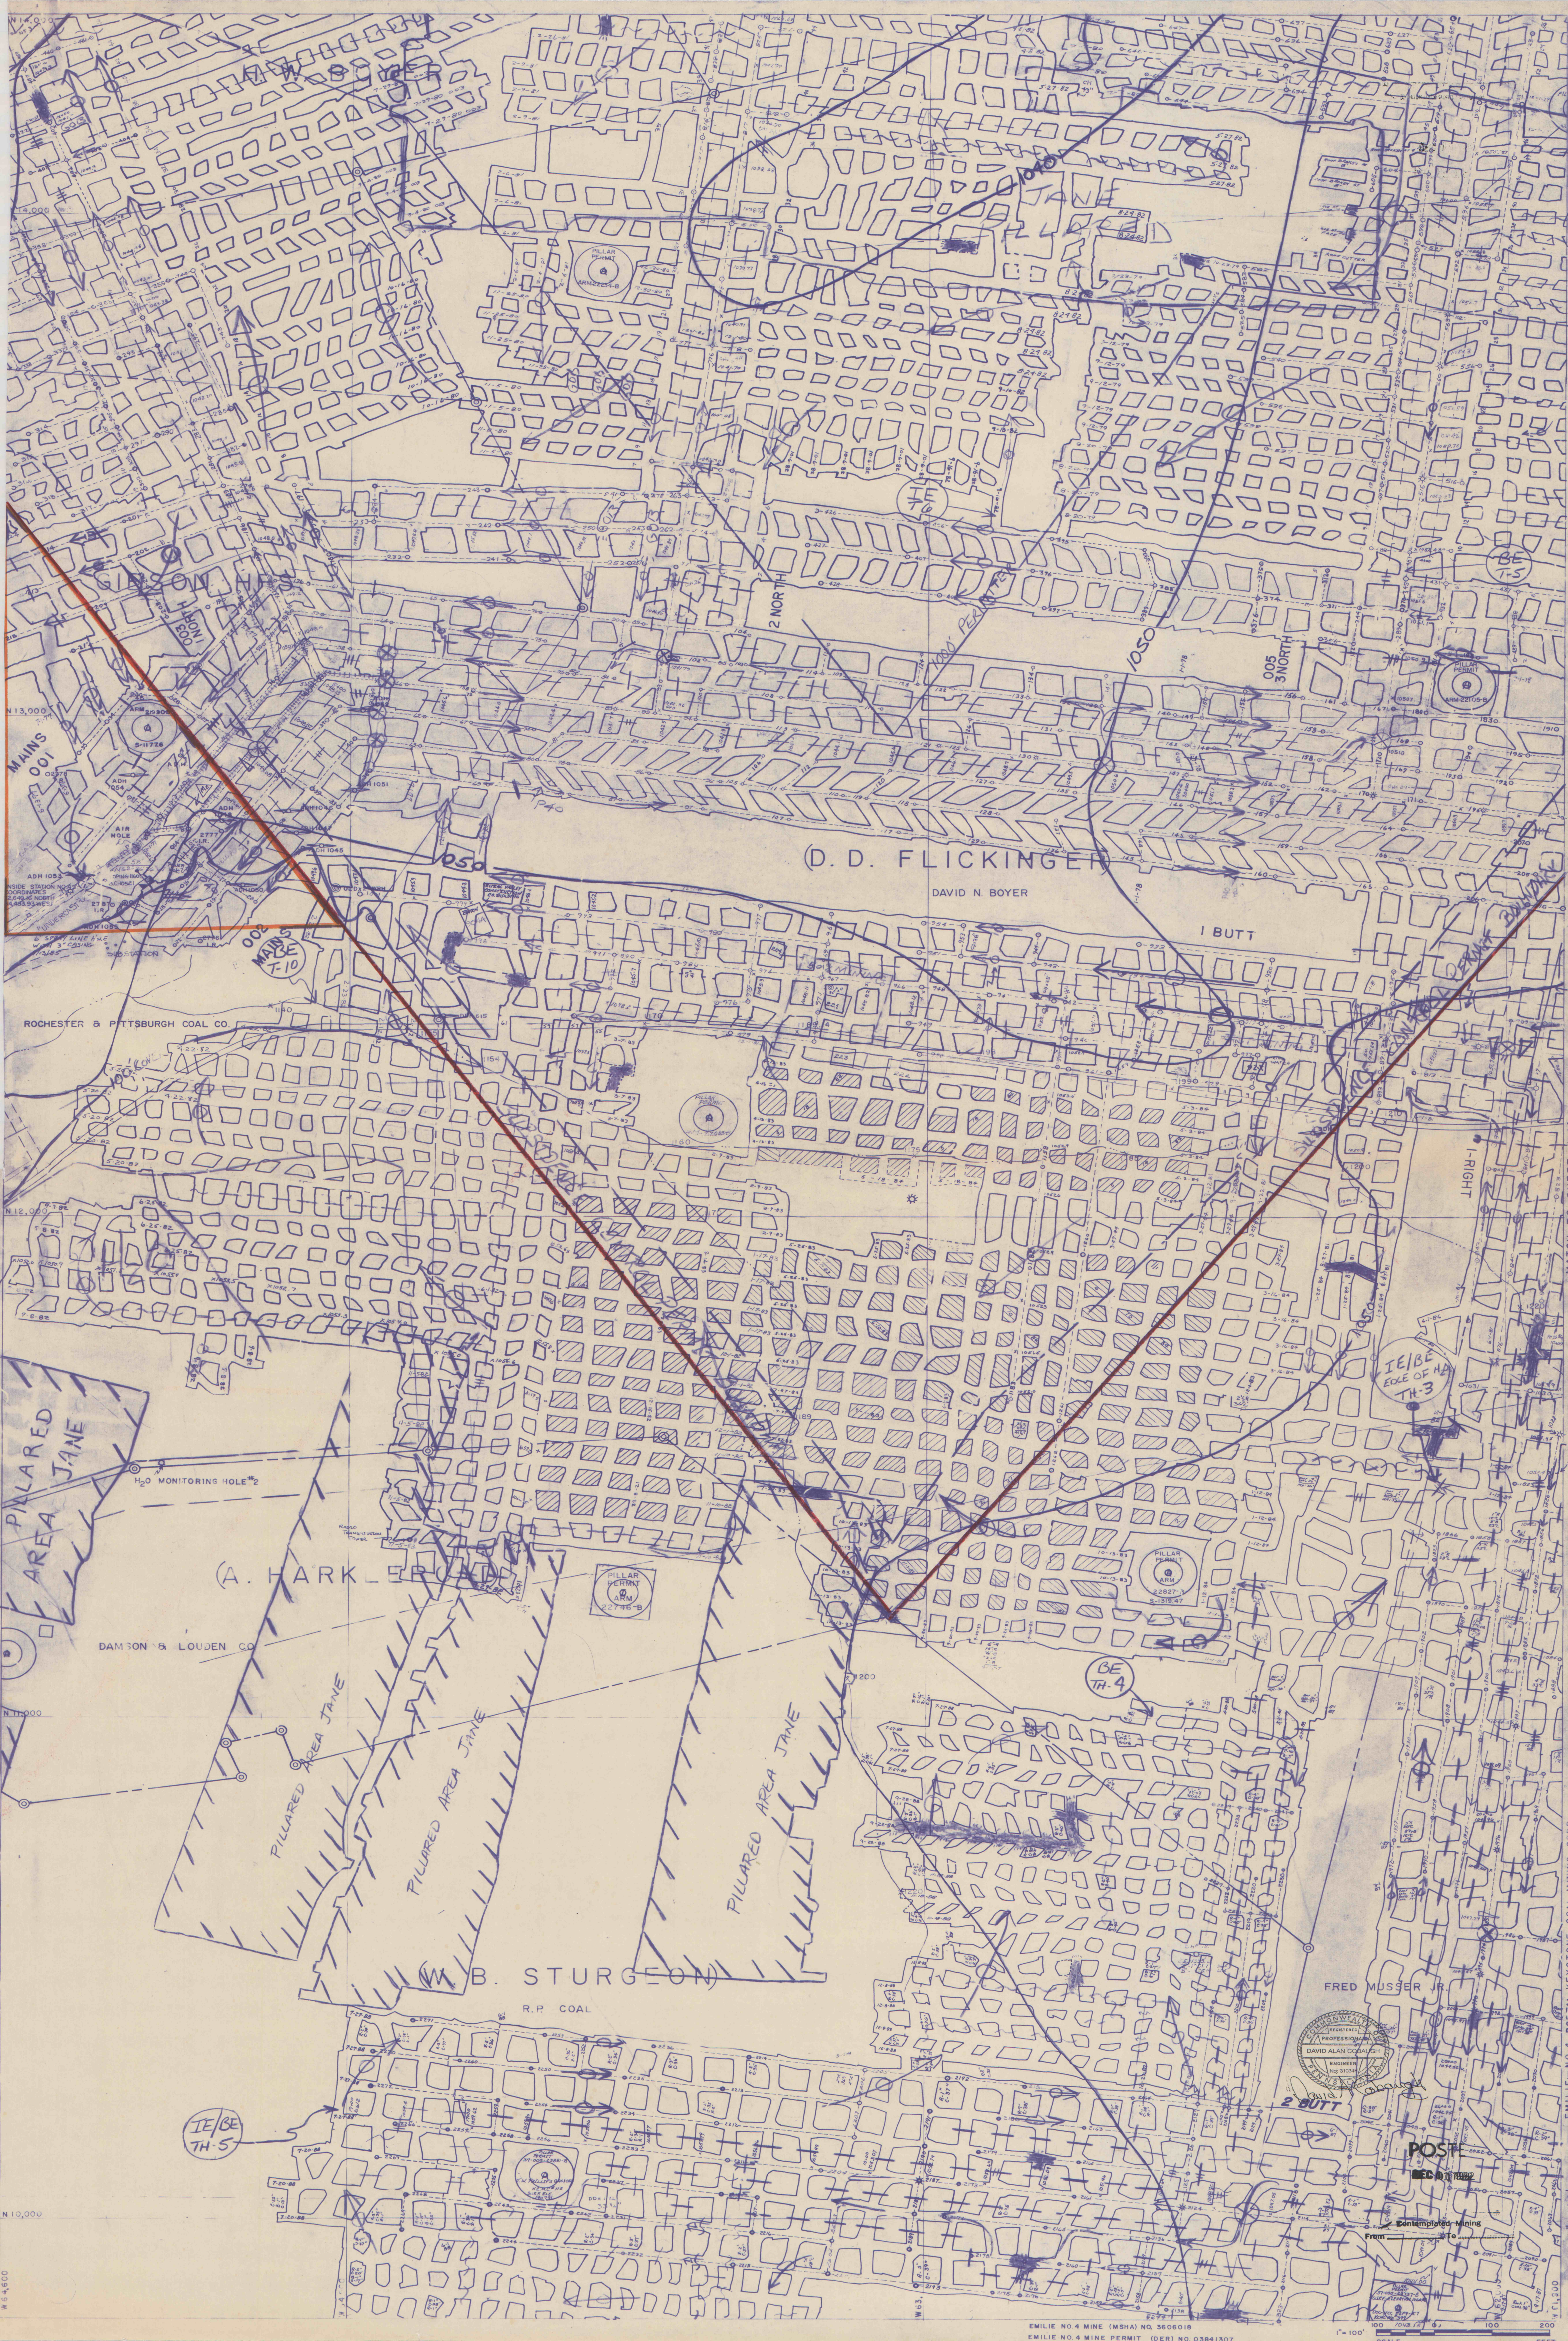

N-13

N-13

EMILIE NO. 4 MINE (MSHA) NO. 3806018
EMILIE NO. 4 MINE PERMIT (DER) NO. 03841307

1" = 100'
SCALE
FEET

EMILIE NO. 4 POCAL KEYSTONE COAL MINING CORP.
PLUM CREEK TWP. ARMSTRONG CO.
UPPER FREEPORT SEAM