


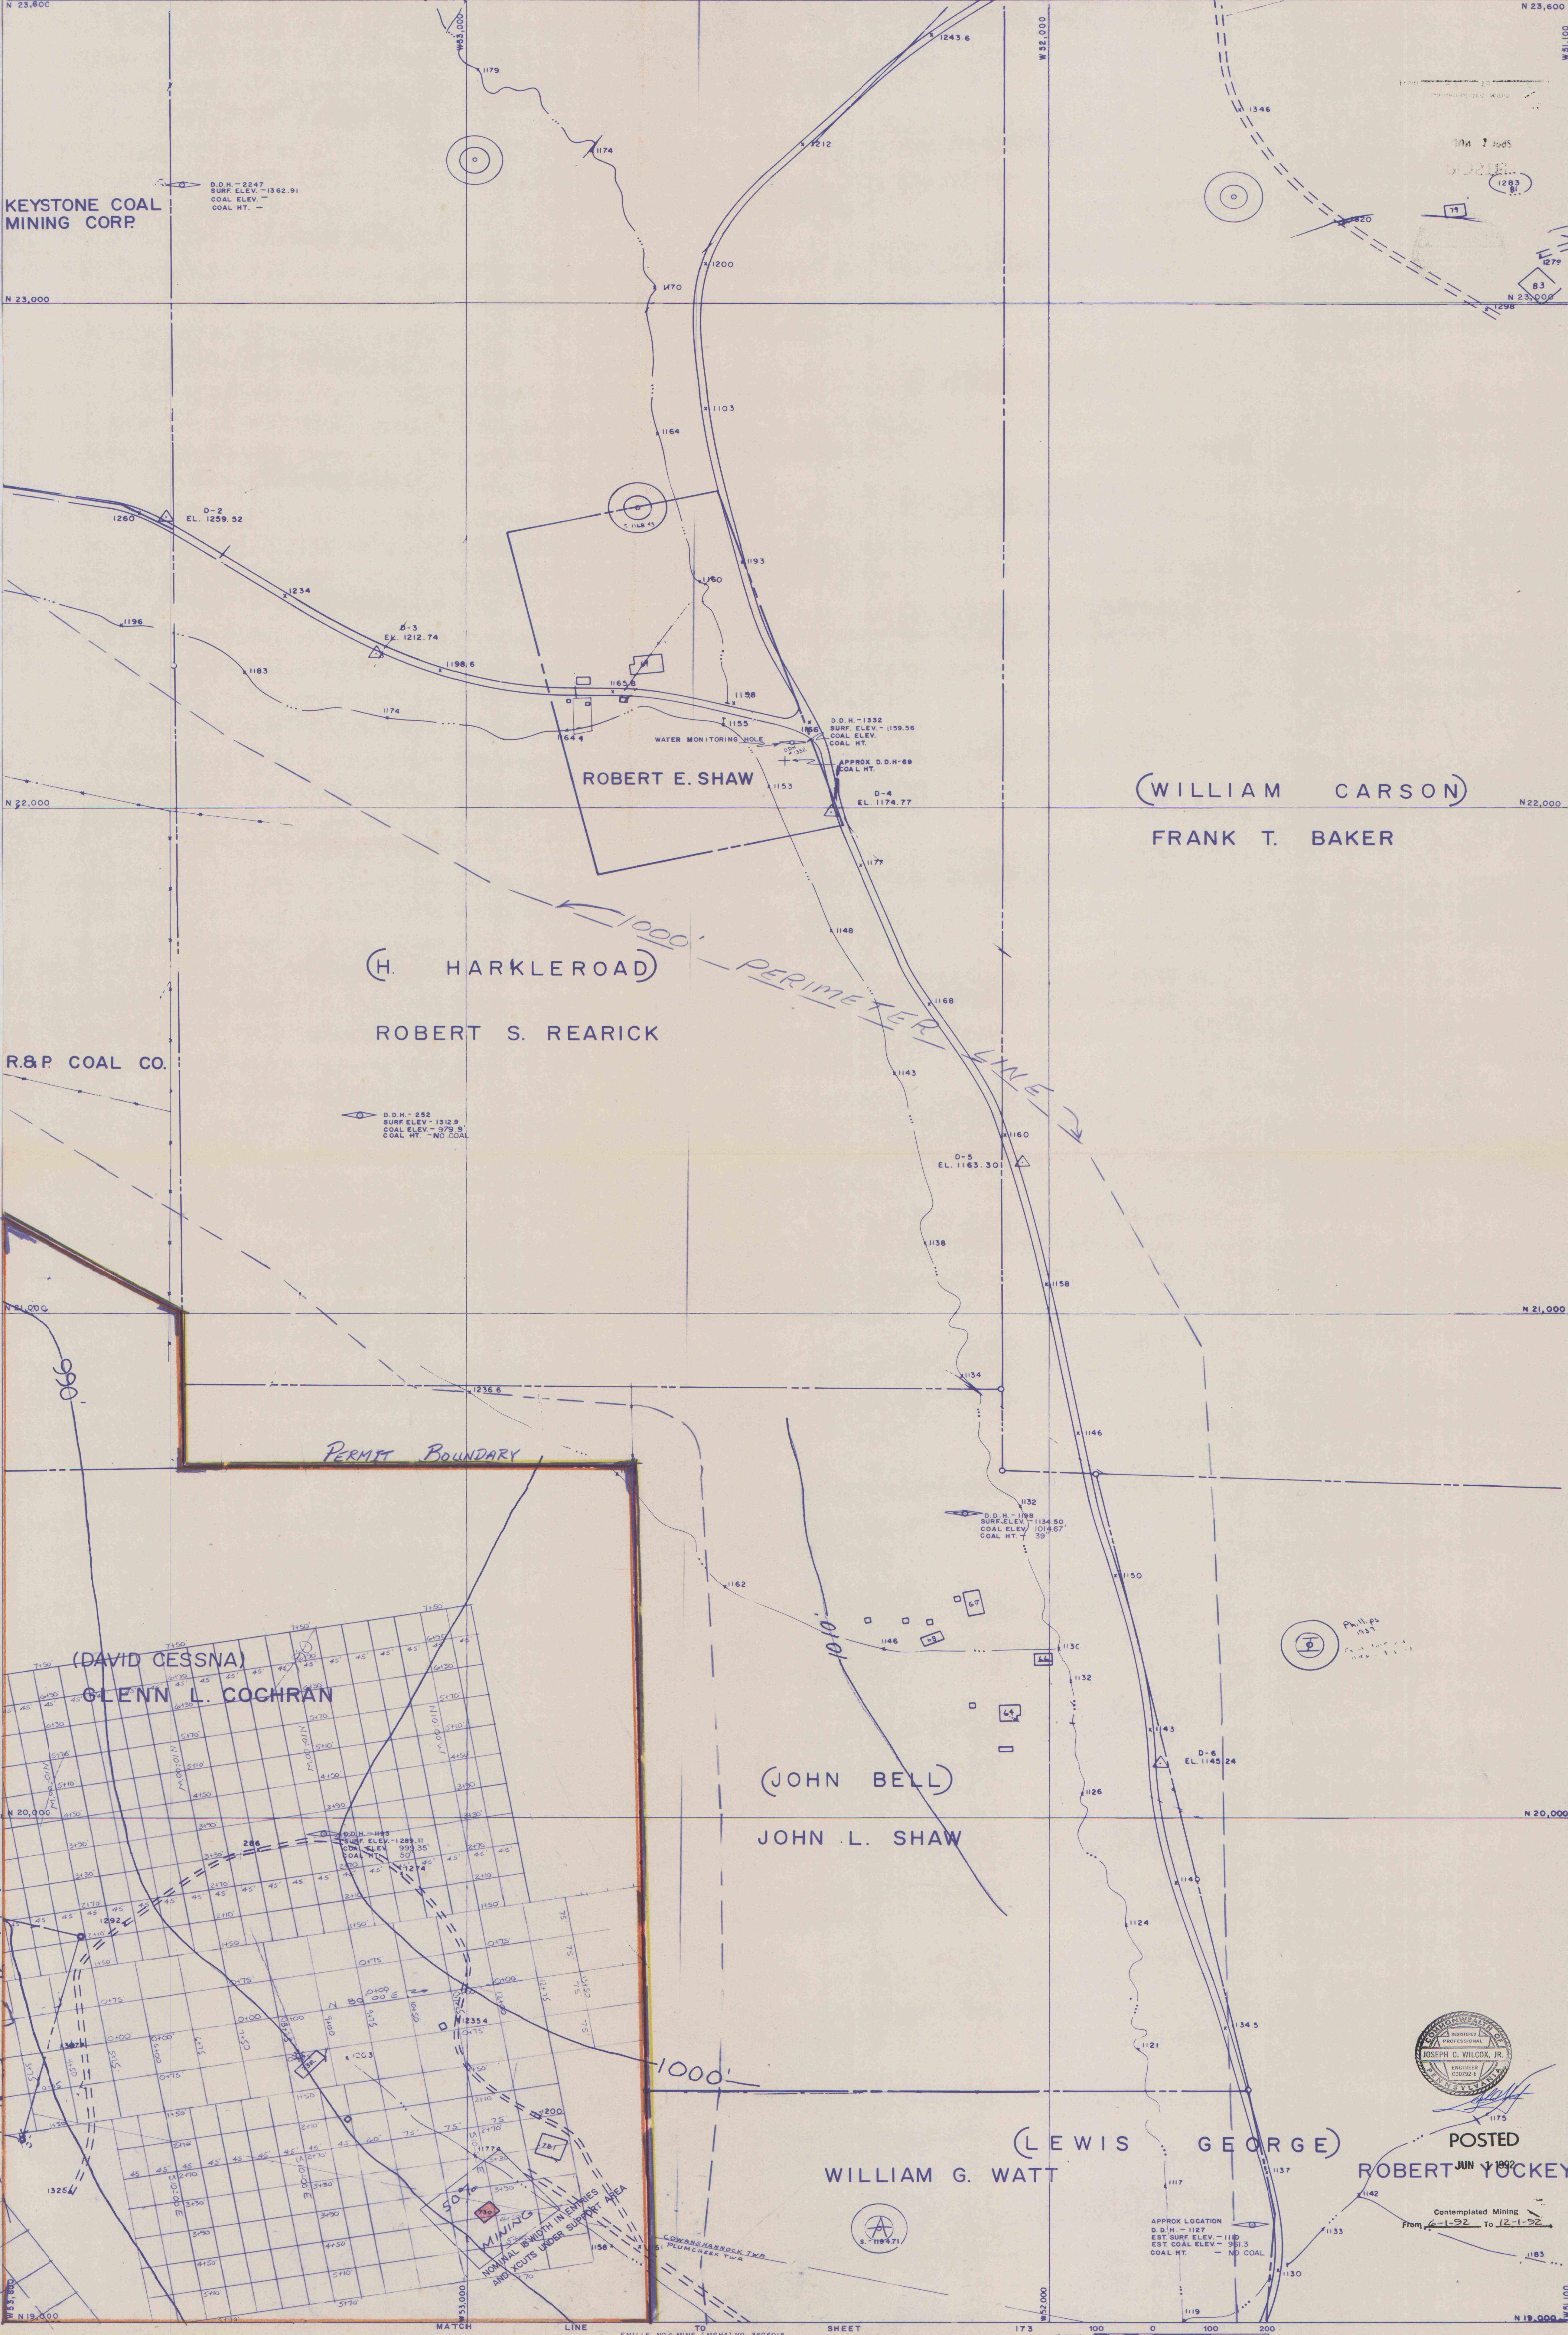

KEYSTONE COAL MINING CORP.

D.D.H. - 2247
SURF. ELEV. - 1362.91
COAL ELEV. -
COAL HT. -

ROBERT E. SHAW

(WILLIAM CARSON)

FRANK T. BAKER

(H. HARKLER ROAD)

ROBERT S. REARICK

R.&P. COAL CO.

D.D.H. - 252
SURF. ELEV. - 1312.9
COAL ELEV. - 979.9
COAL HT. - NO COAL


(JOHN BELL)

JOHN L. SHAW

(LEWIS GEORGE)

WILLIAM G. WATT

POSTED
ROBERT YUCKEY

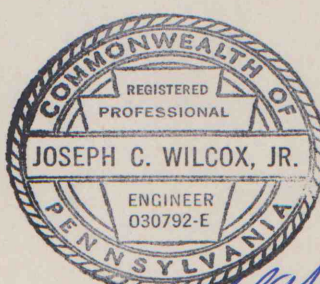

APPROX LOCATION
D.D.H. - 1127
EST. SURF. ELEV. - 1118
EST. COAL ELEV. - 961.3
COAL HT. - NO COAL