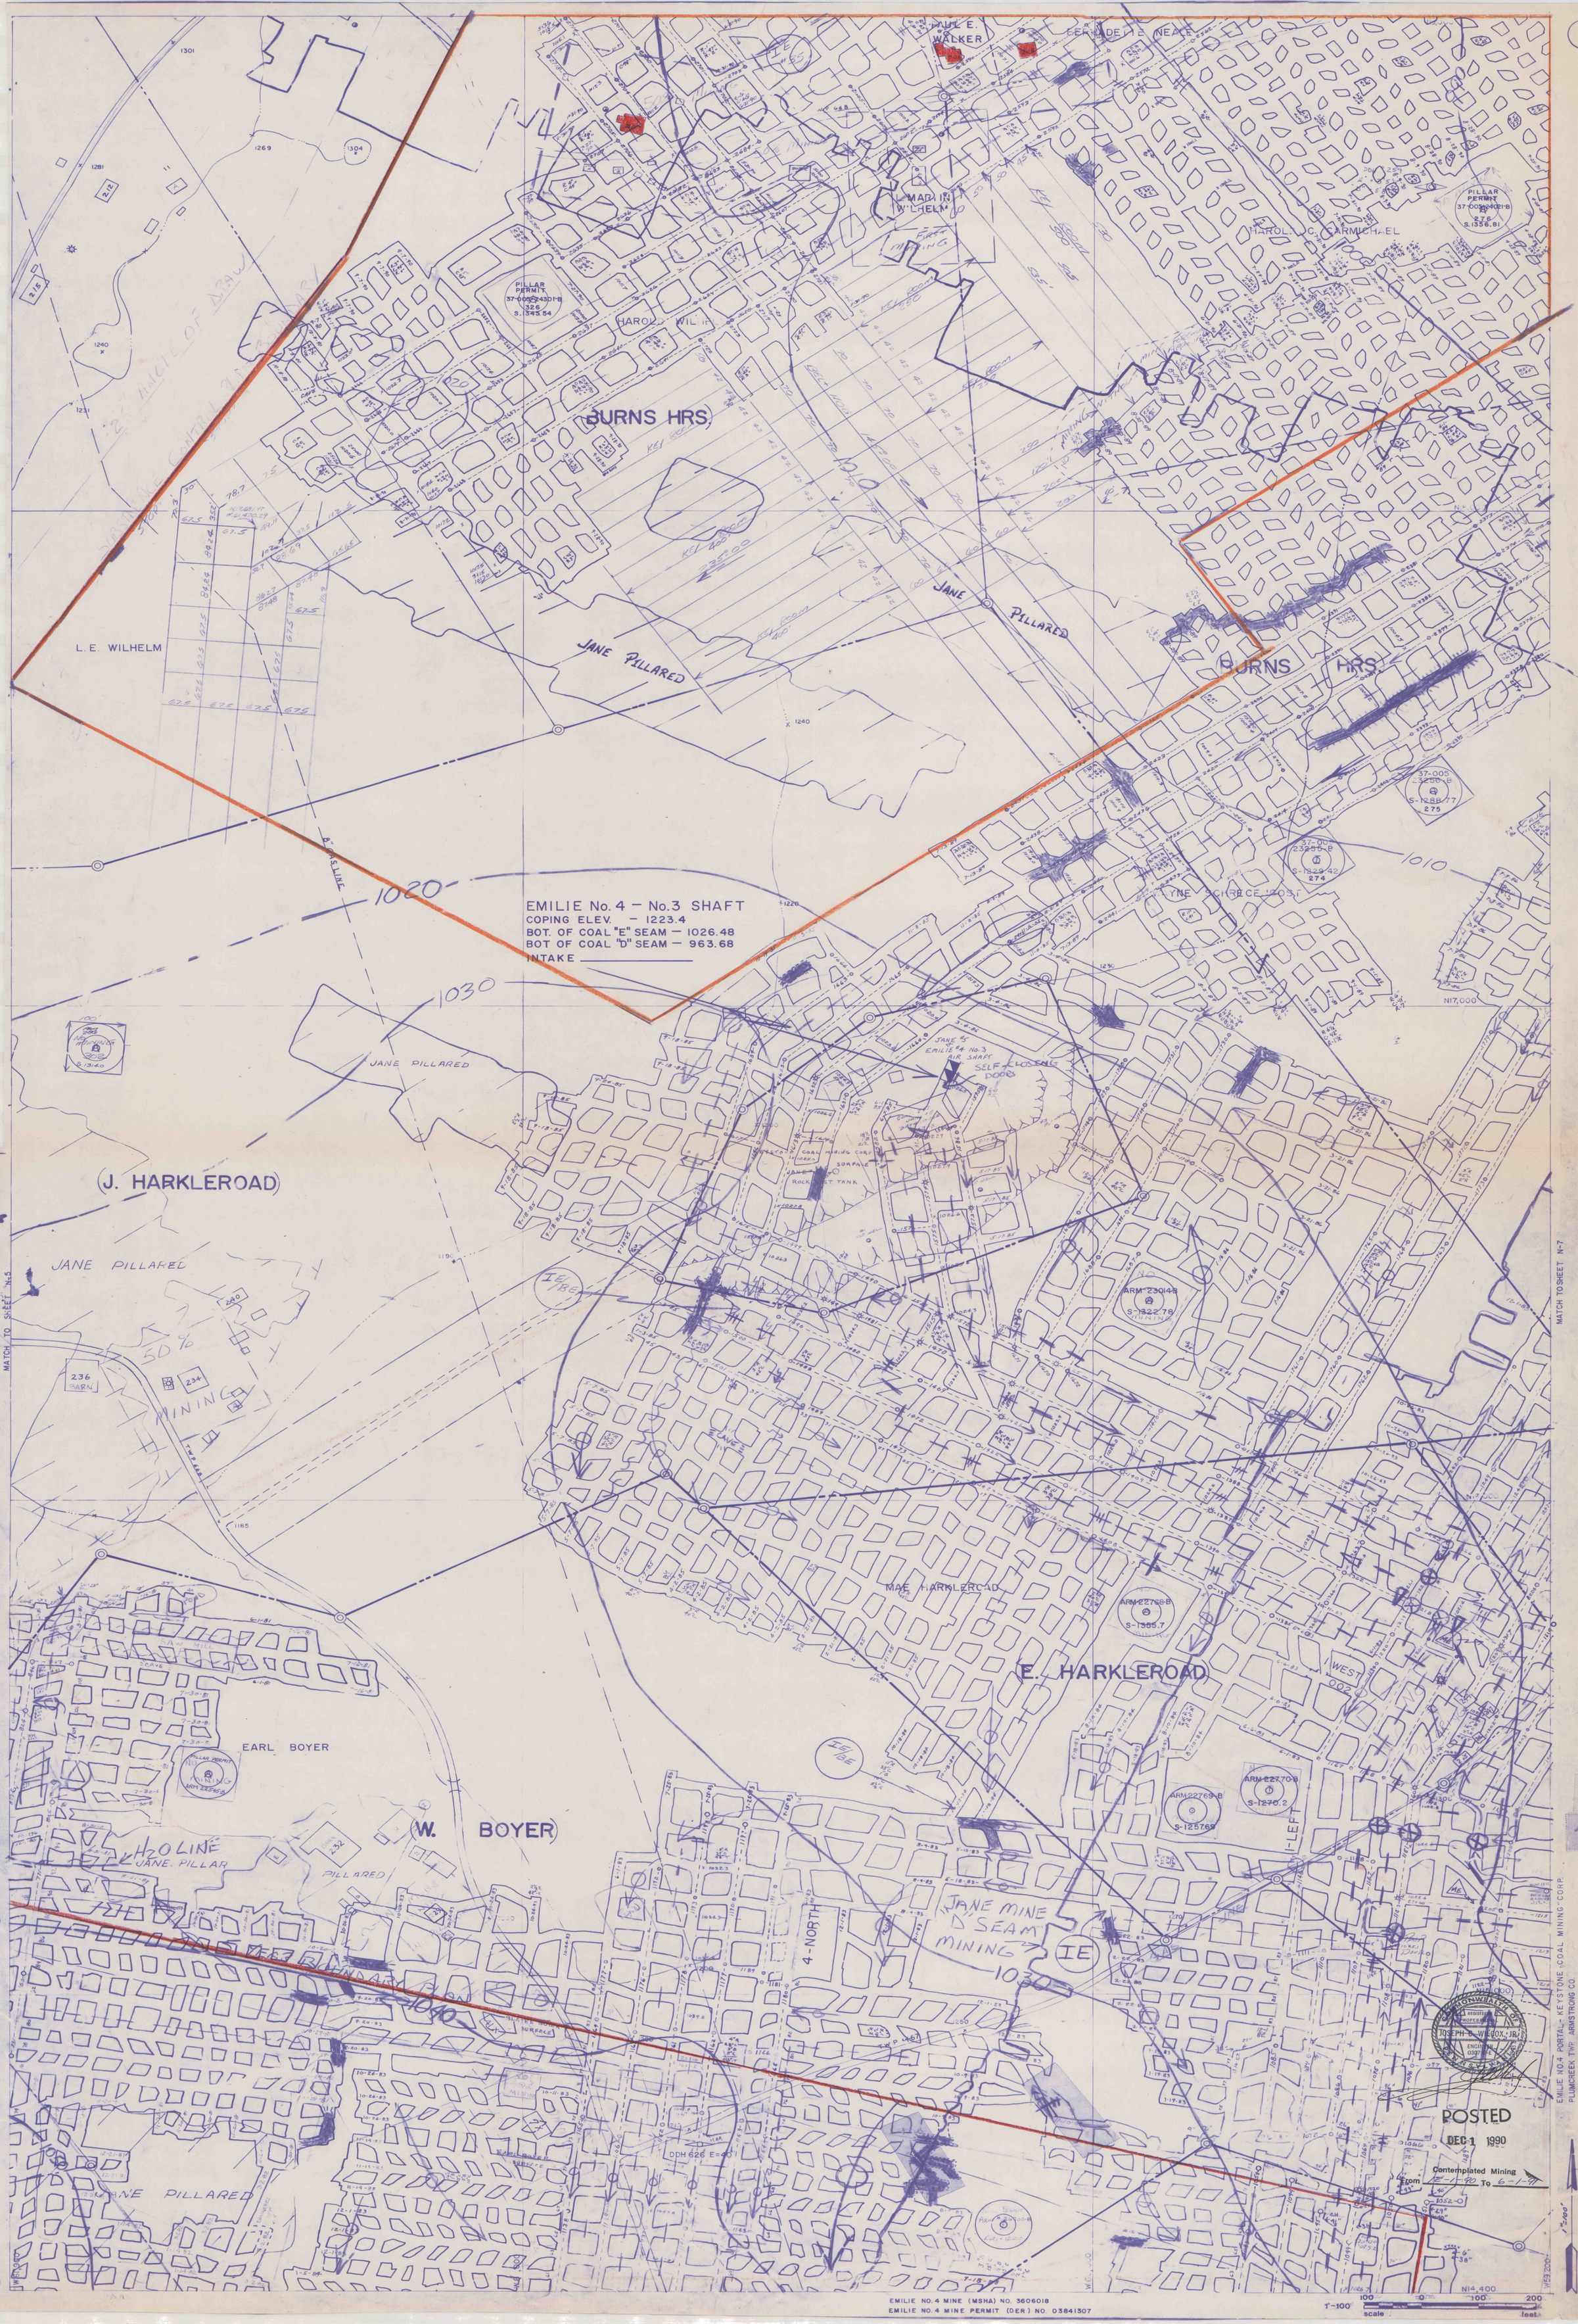
N-6
PAUL E. WALKER
LEFRADE (NEALE)
MARTIN WILHELM
HAROLD C. CARMICHAEL
PILLAR PERMIT 37-005-24301-B 326 S.1343.54
PILLAR PERMIT 37-005-24021-B 276 S.1356.81
HAROLD WILHELM
BURNS HRS
KEY ROOM
JANE PILLARED
L. E. WILHELM
37-005-23256-B S-1288.77 275
37-005-23255-B S-1229.42 274
1020
1010
EMILIE No. 4 — No.3 SHAFT
COPING ELEV. — 1223.4
BOT. OF COAL "E" SEAM — 1026.48
BOT OF COAL "D" SEAM — 963.68
INTAKE _____
1030
N17,000
JANE #5 or EMILIE #4 No.3 AIR SHAFT
SELF CLOSING DOORS
(J. HARKLEROAD)
JANE PILLARED
MATCH TO SHEET N-5
MATCH TO SHEET N-7
ARM 23014-B S-1322.78
ARM 22768-B S-1355.7
MAE HARKLEROAD
(E. HARKLEROAD)
EARL BOYER
(W. BOYER)
ARM 22769-B S-1257.69
ARM 22770-B S-1270.2
H2O LINE
JANE PILLAR
PILLARED
4-NORTH
JANE MINE D SEAM MINING
IE
DDH 626 E=40
N14,400
POSTED
DEC 1 1990
Contemplated Mining
From 12-1-90 To 6-1-91
EMILIE NO.4 PORTAL- KEYSTONE COAL MINING CORP.
PLUMCREEK TWP. ARMSTRONG CO.
UPPER FREEPORT SEAM
1"=100'
scale feet
EMILIE NO. 4 MINE (MSHA) NO. 3606018
EMILIE NO. 4 MINE PERMIT (DER) NO. 03841307