


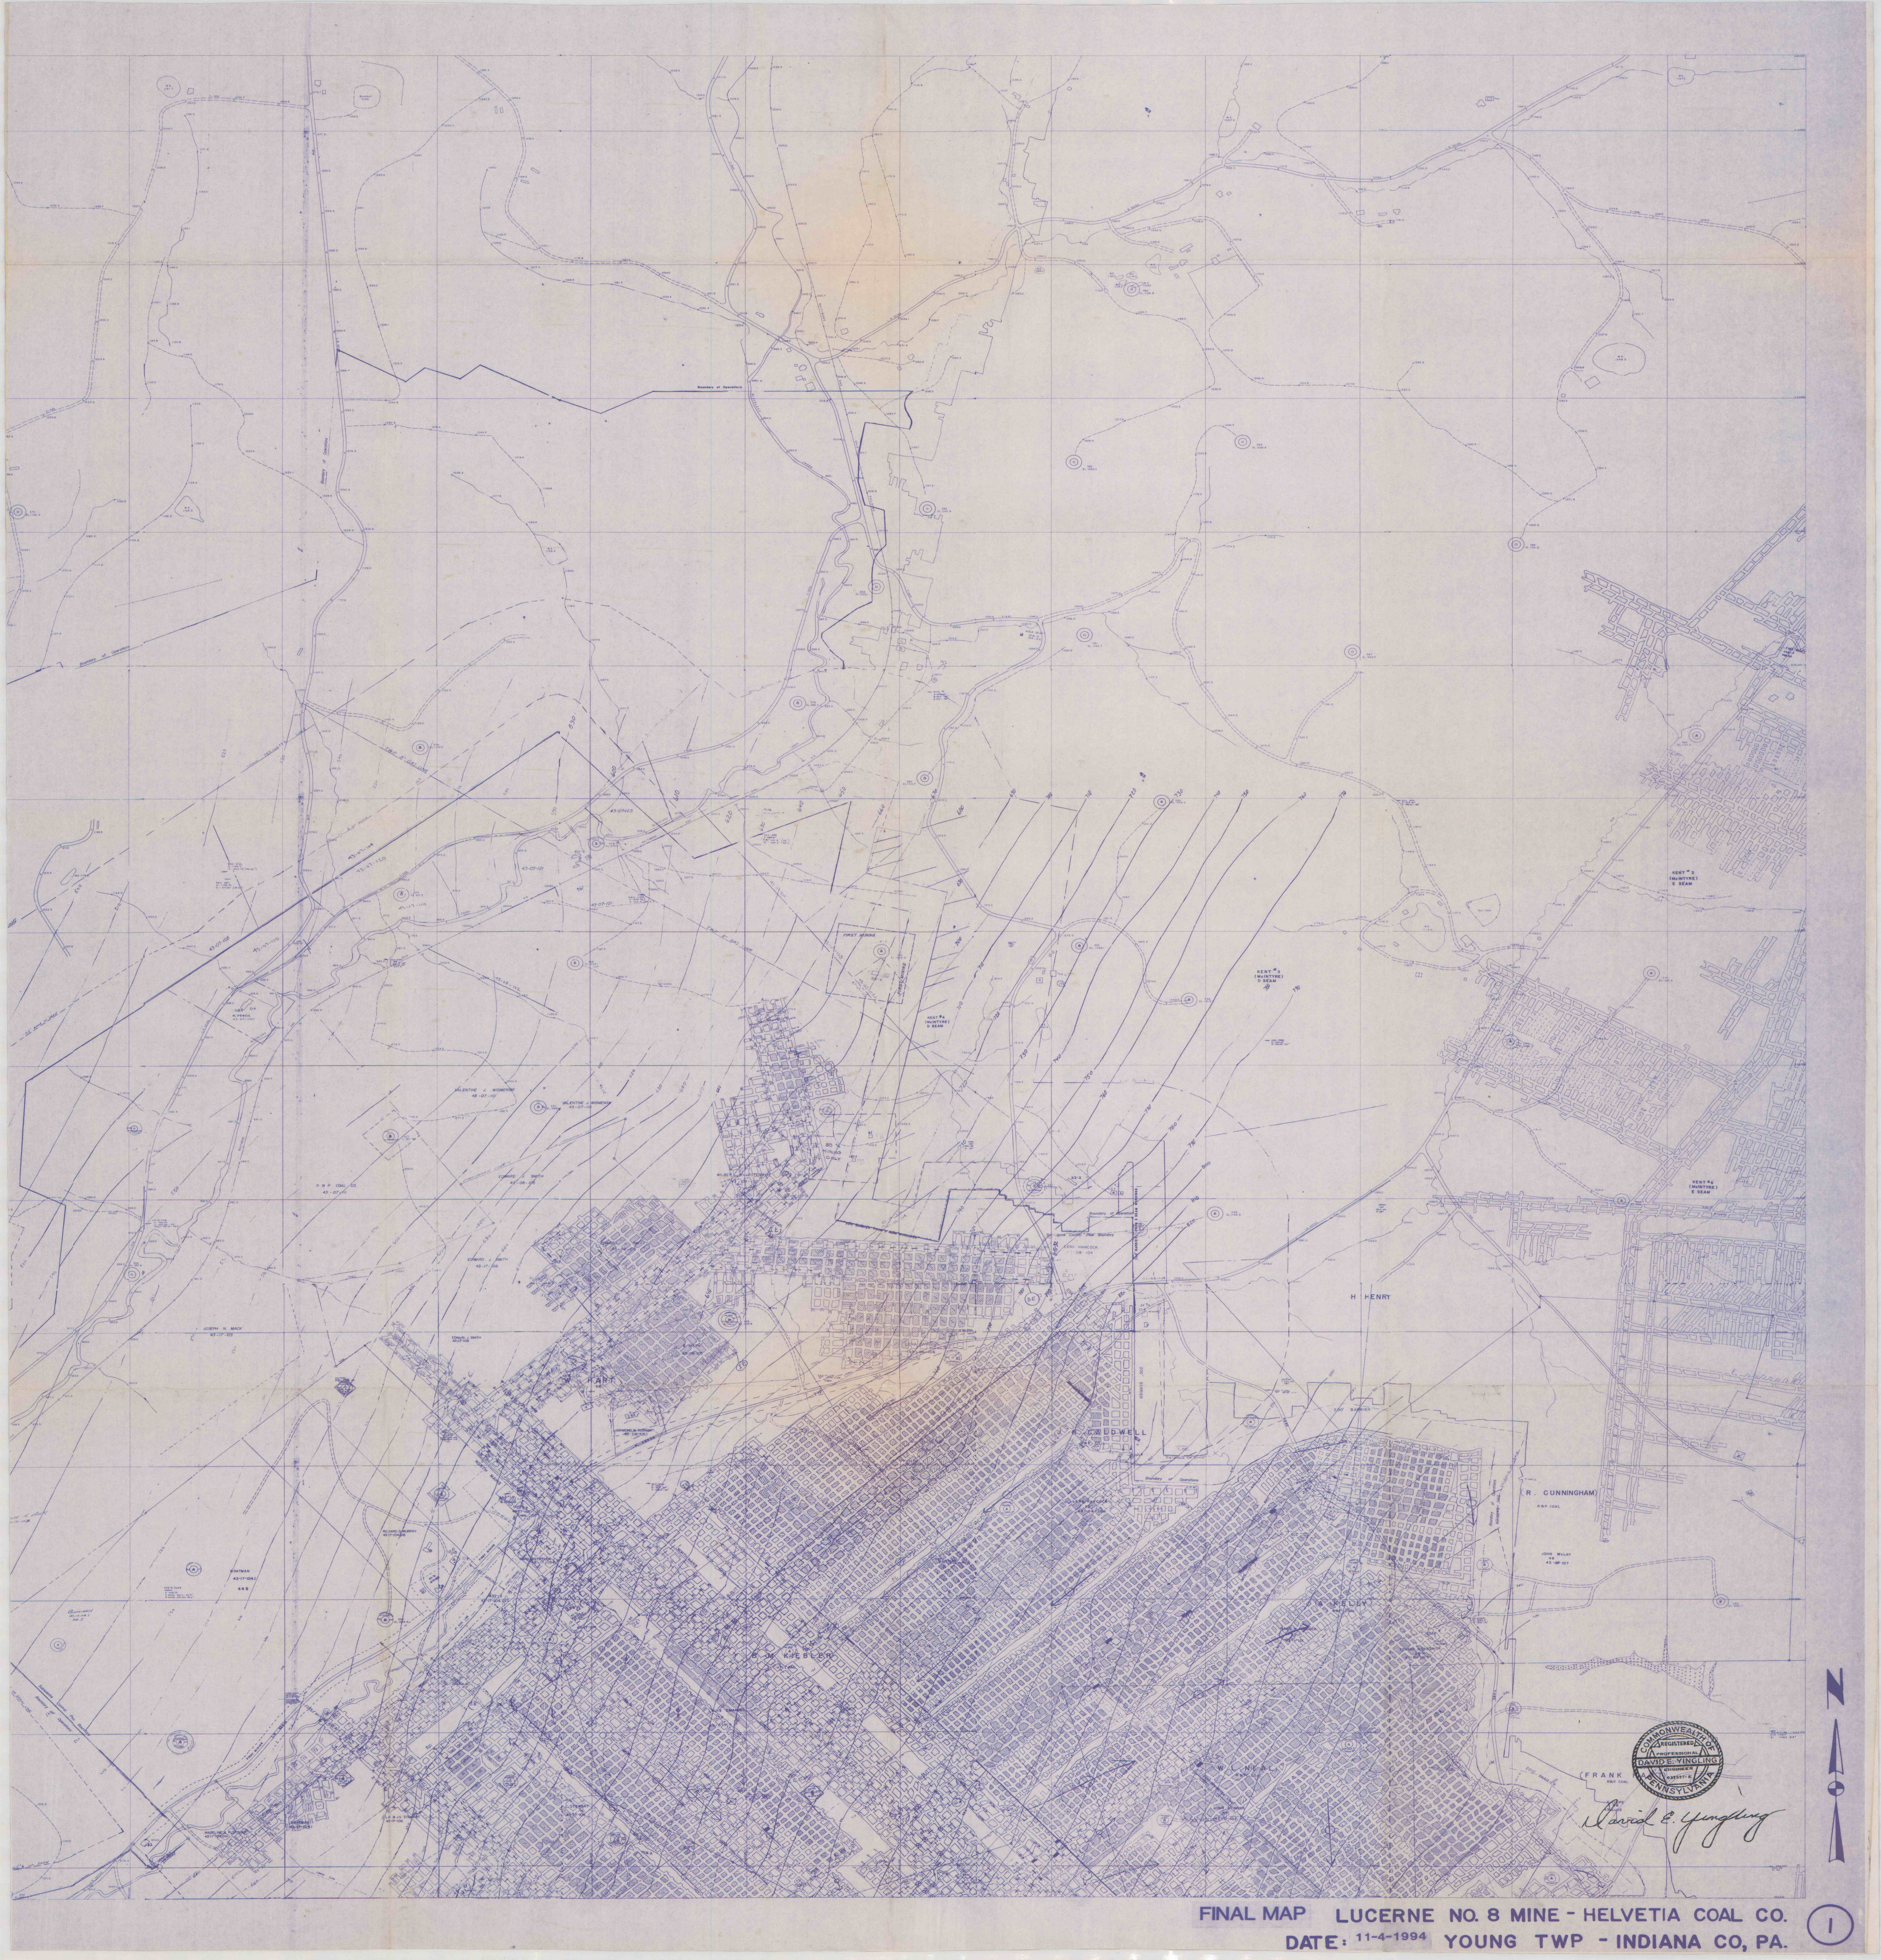

*David E. Jungling*