


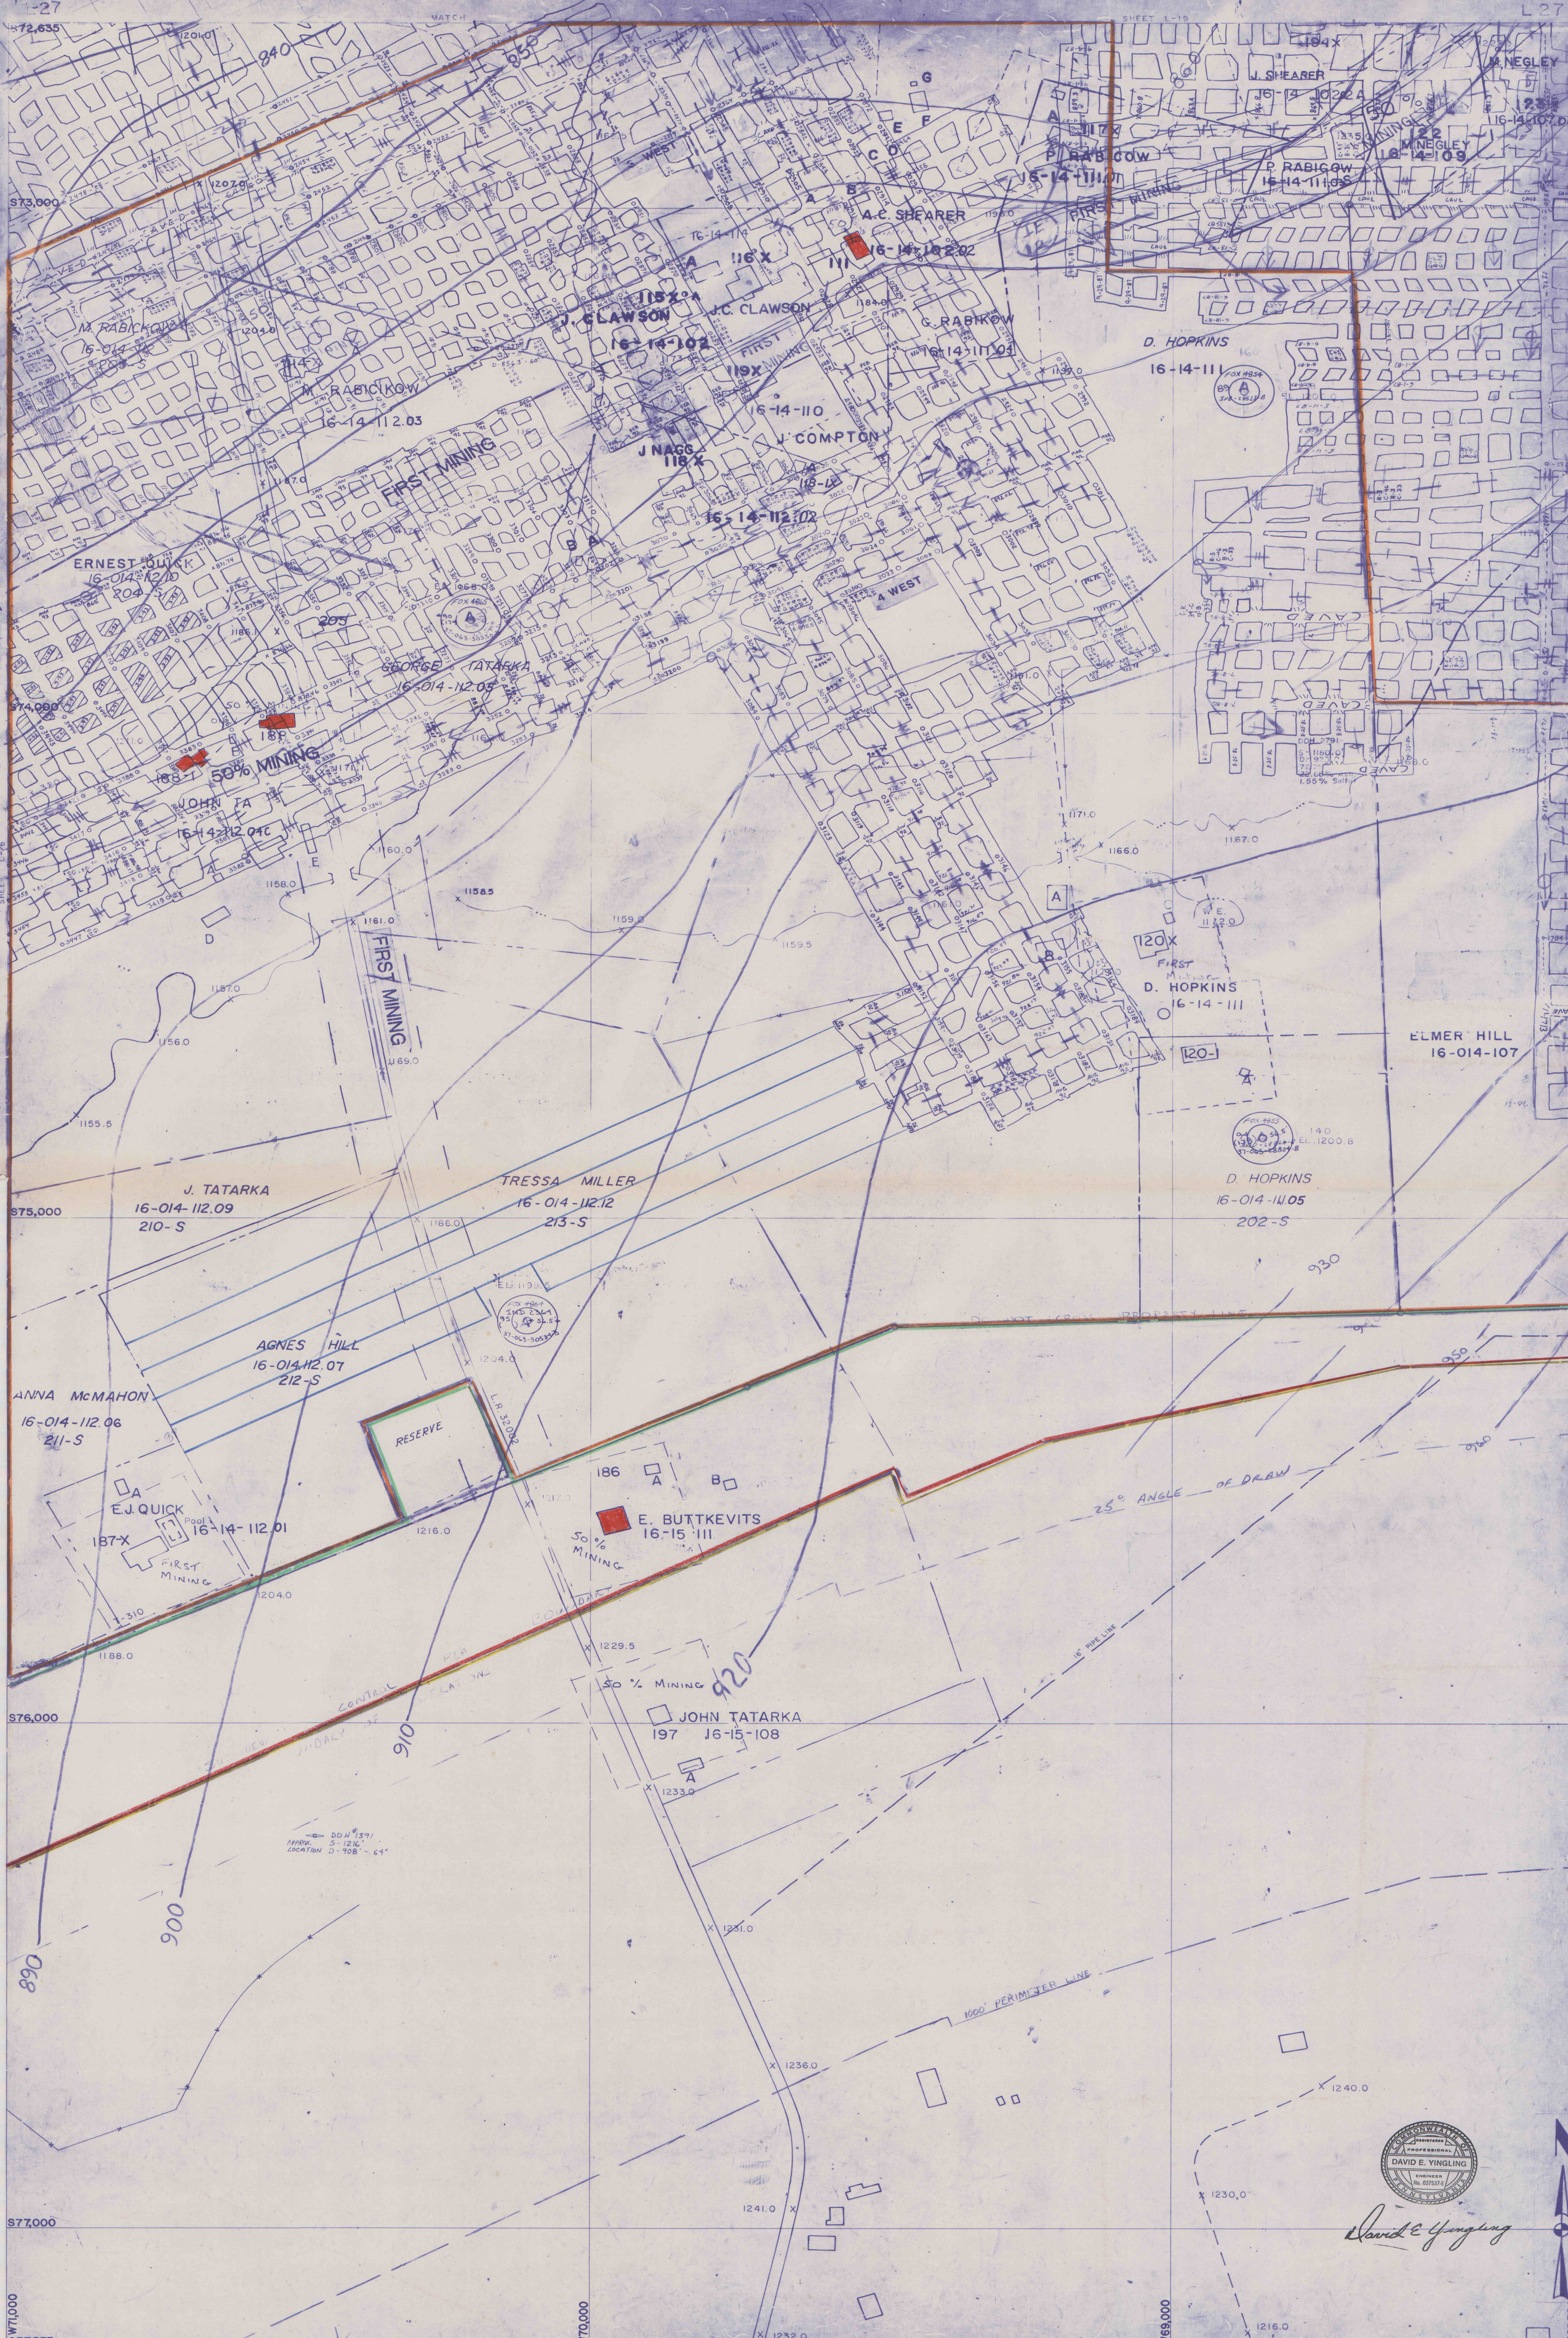

*David E. Yingling*