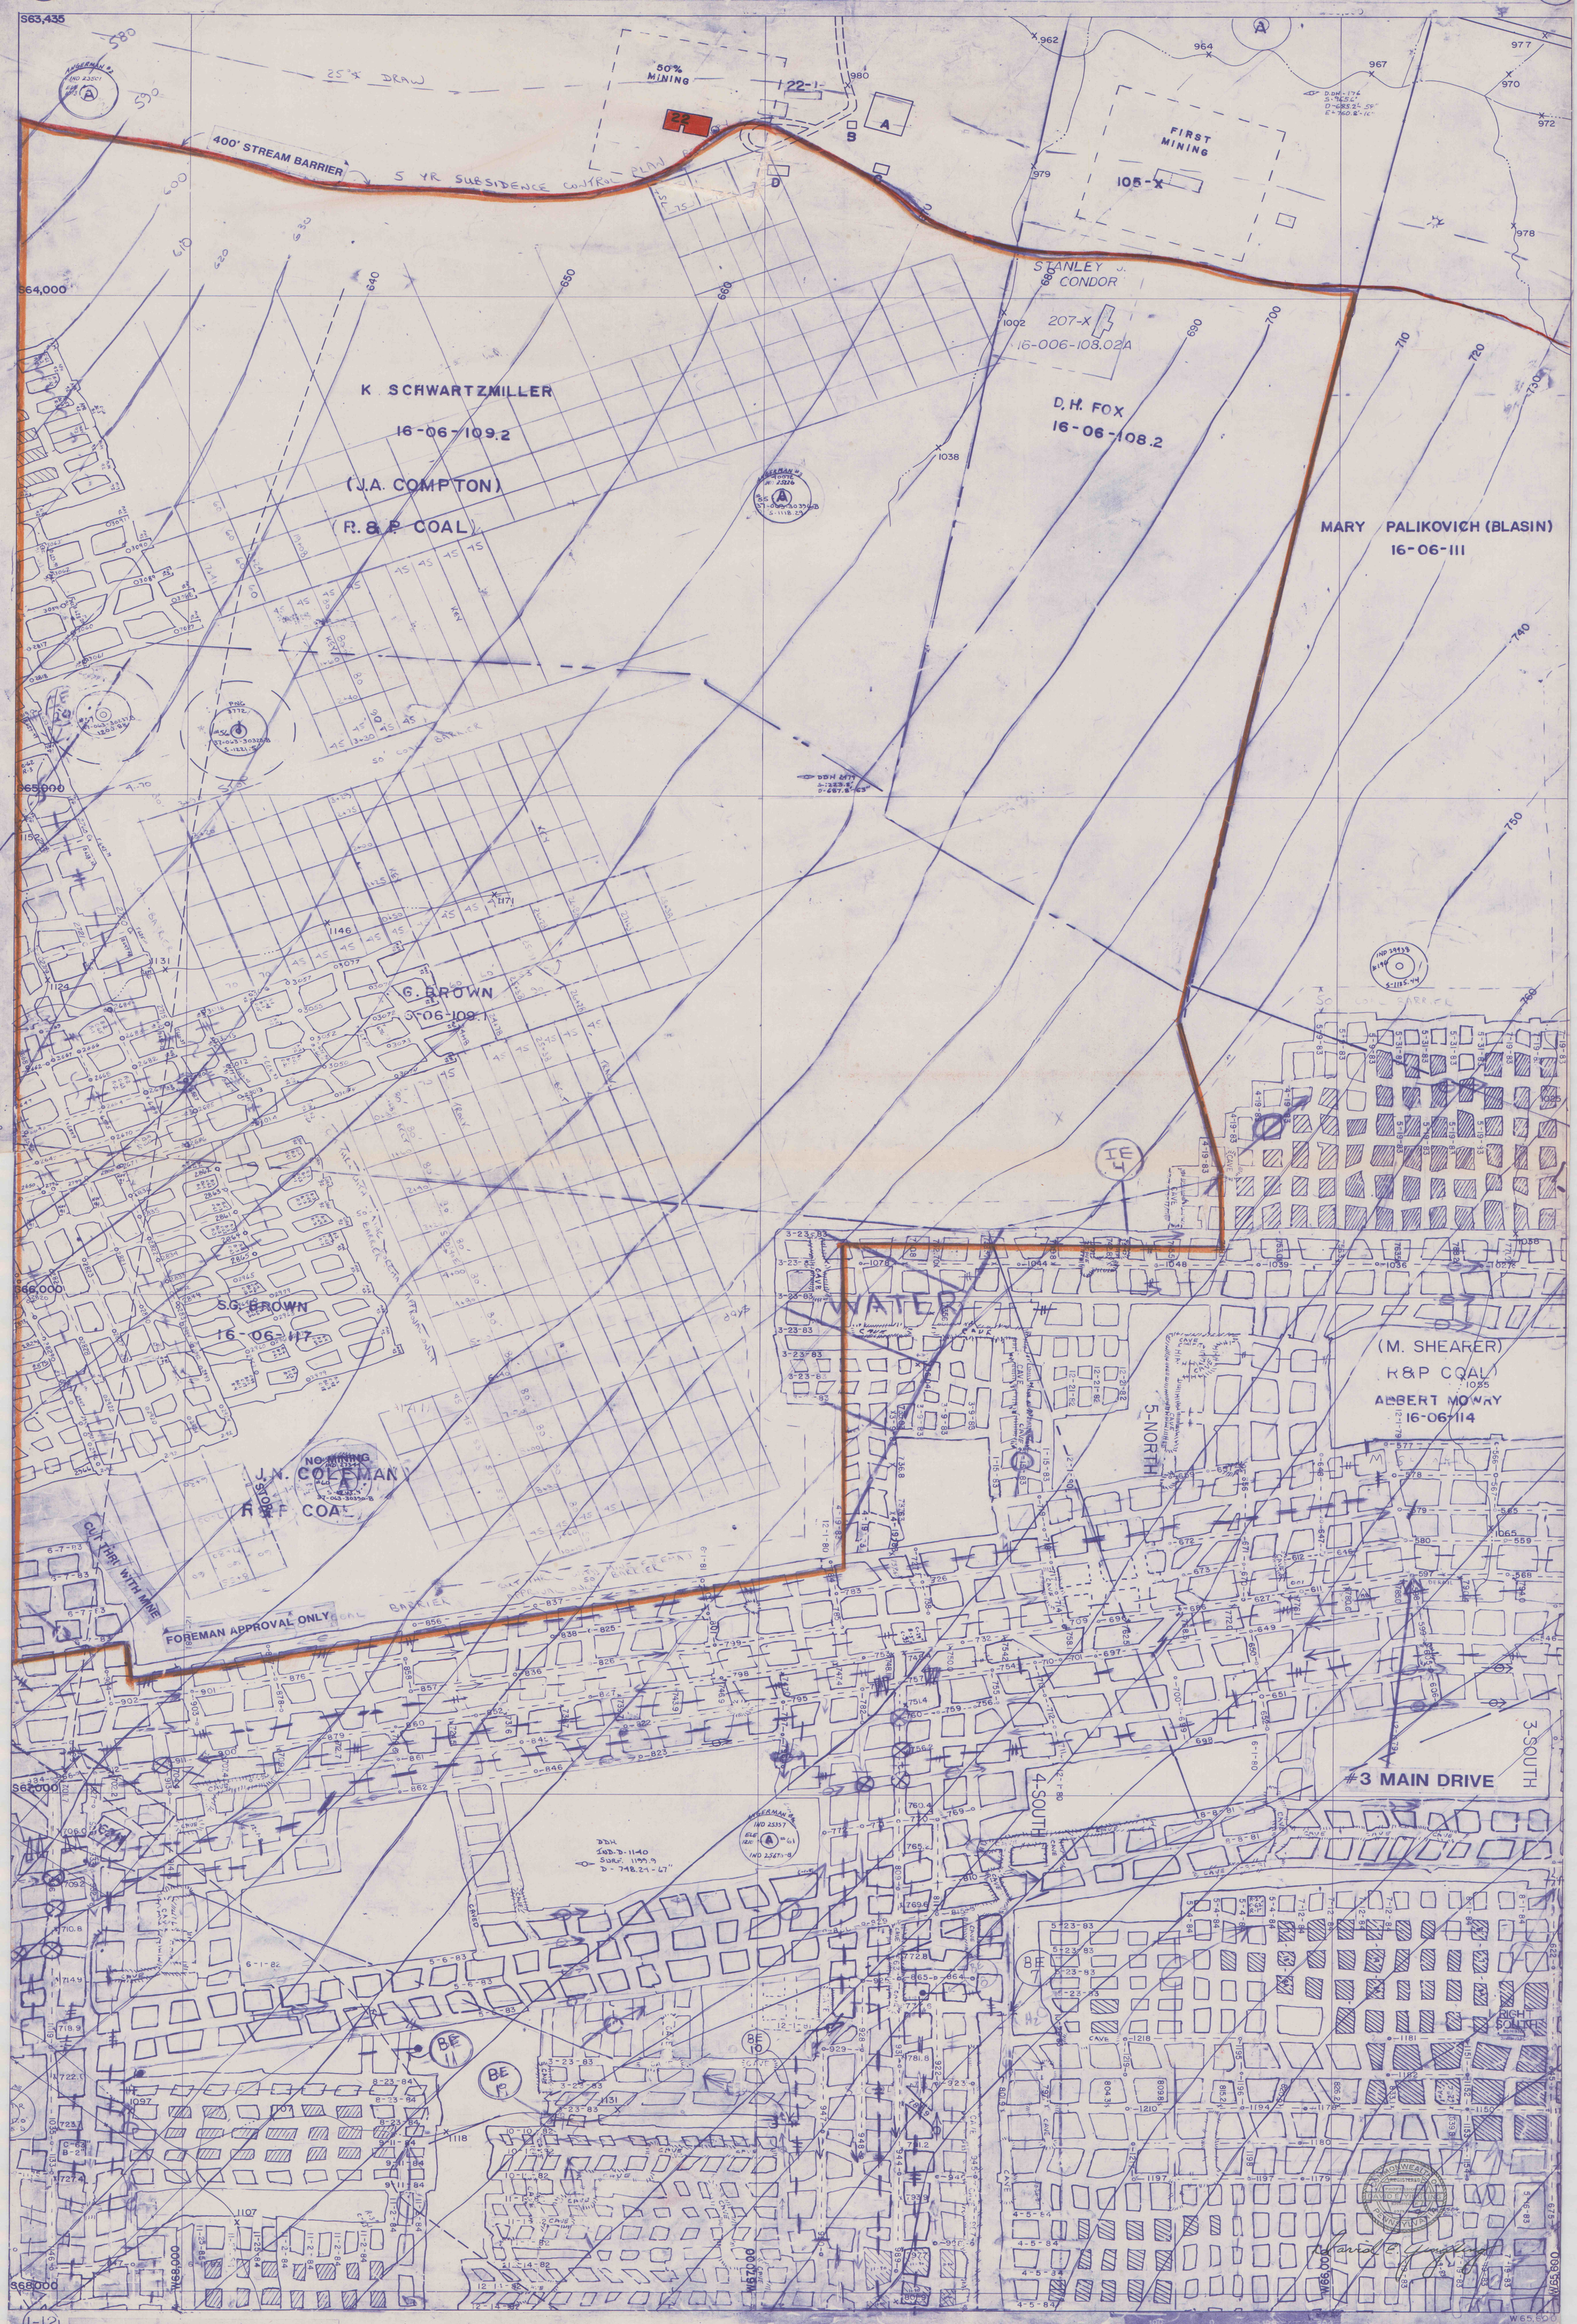

L-12 LOWER FREEPORT P# 32841317

POSTED 6-1-92 CONTEMPLATED MINING 6-1 TO 12-1-92

HELVETIA COAL CO LUCERNE NO.5 36-05374, 352-3 L-12
CONEMAUGH TWP., INDIANA CO. LOWER FREEPORT SEAM