


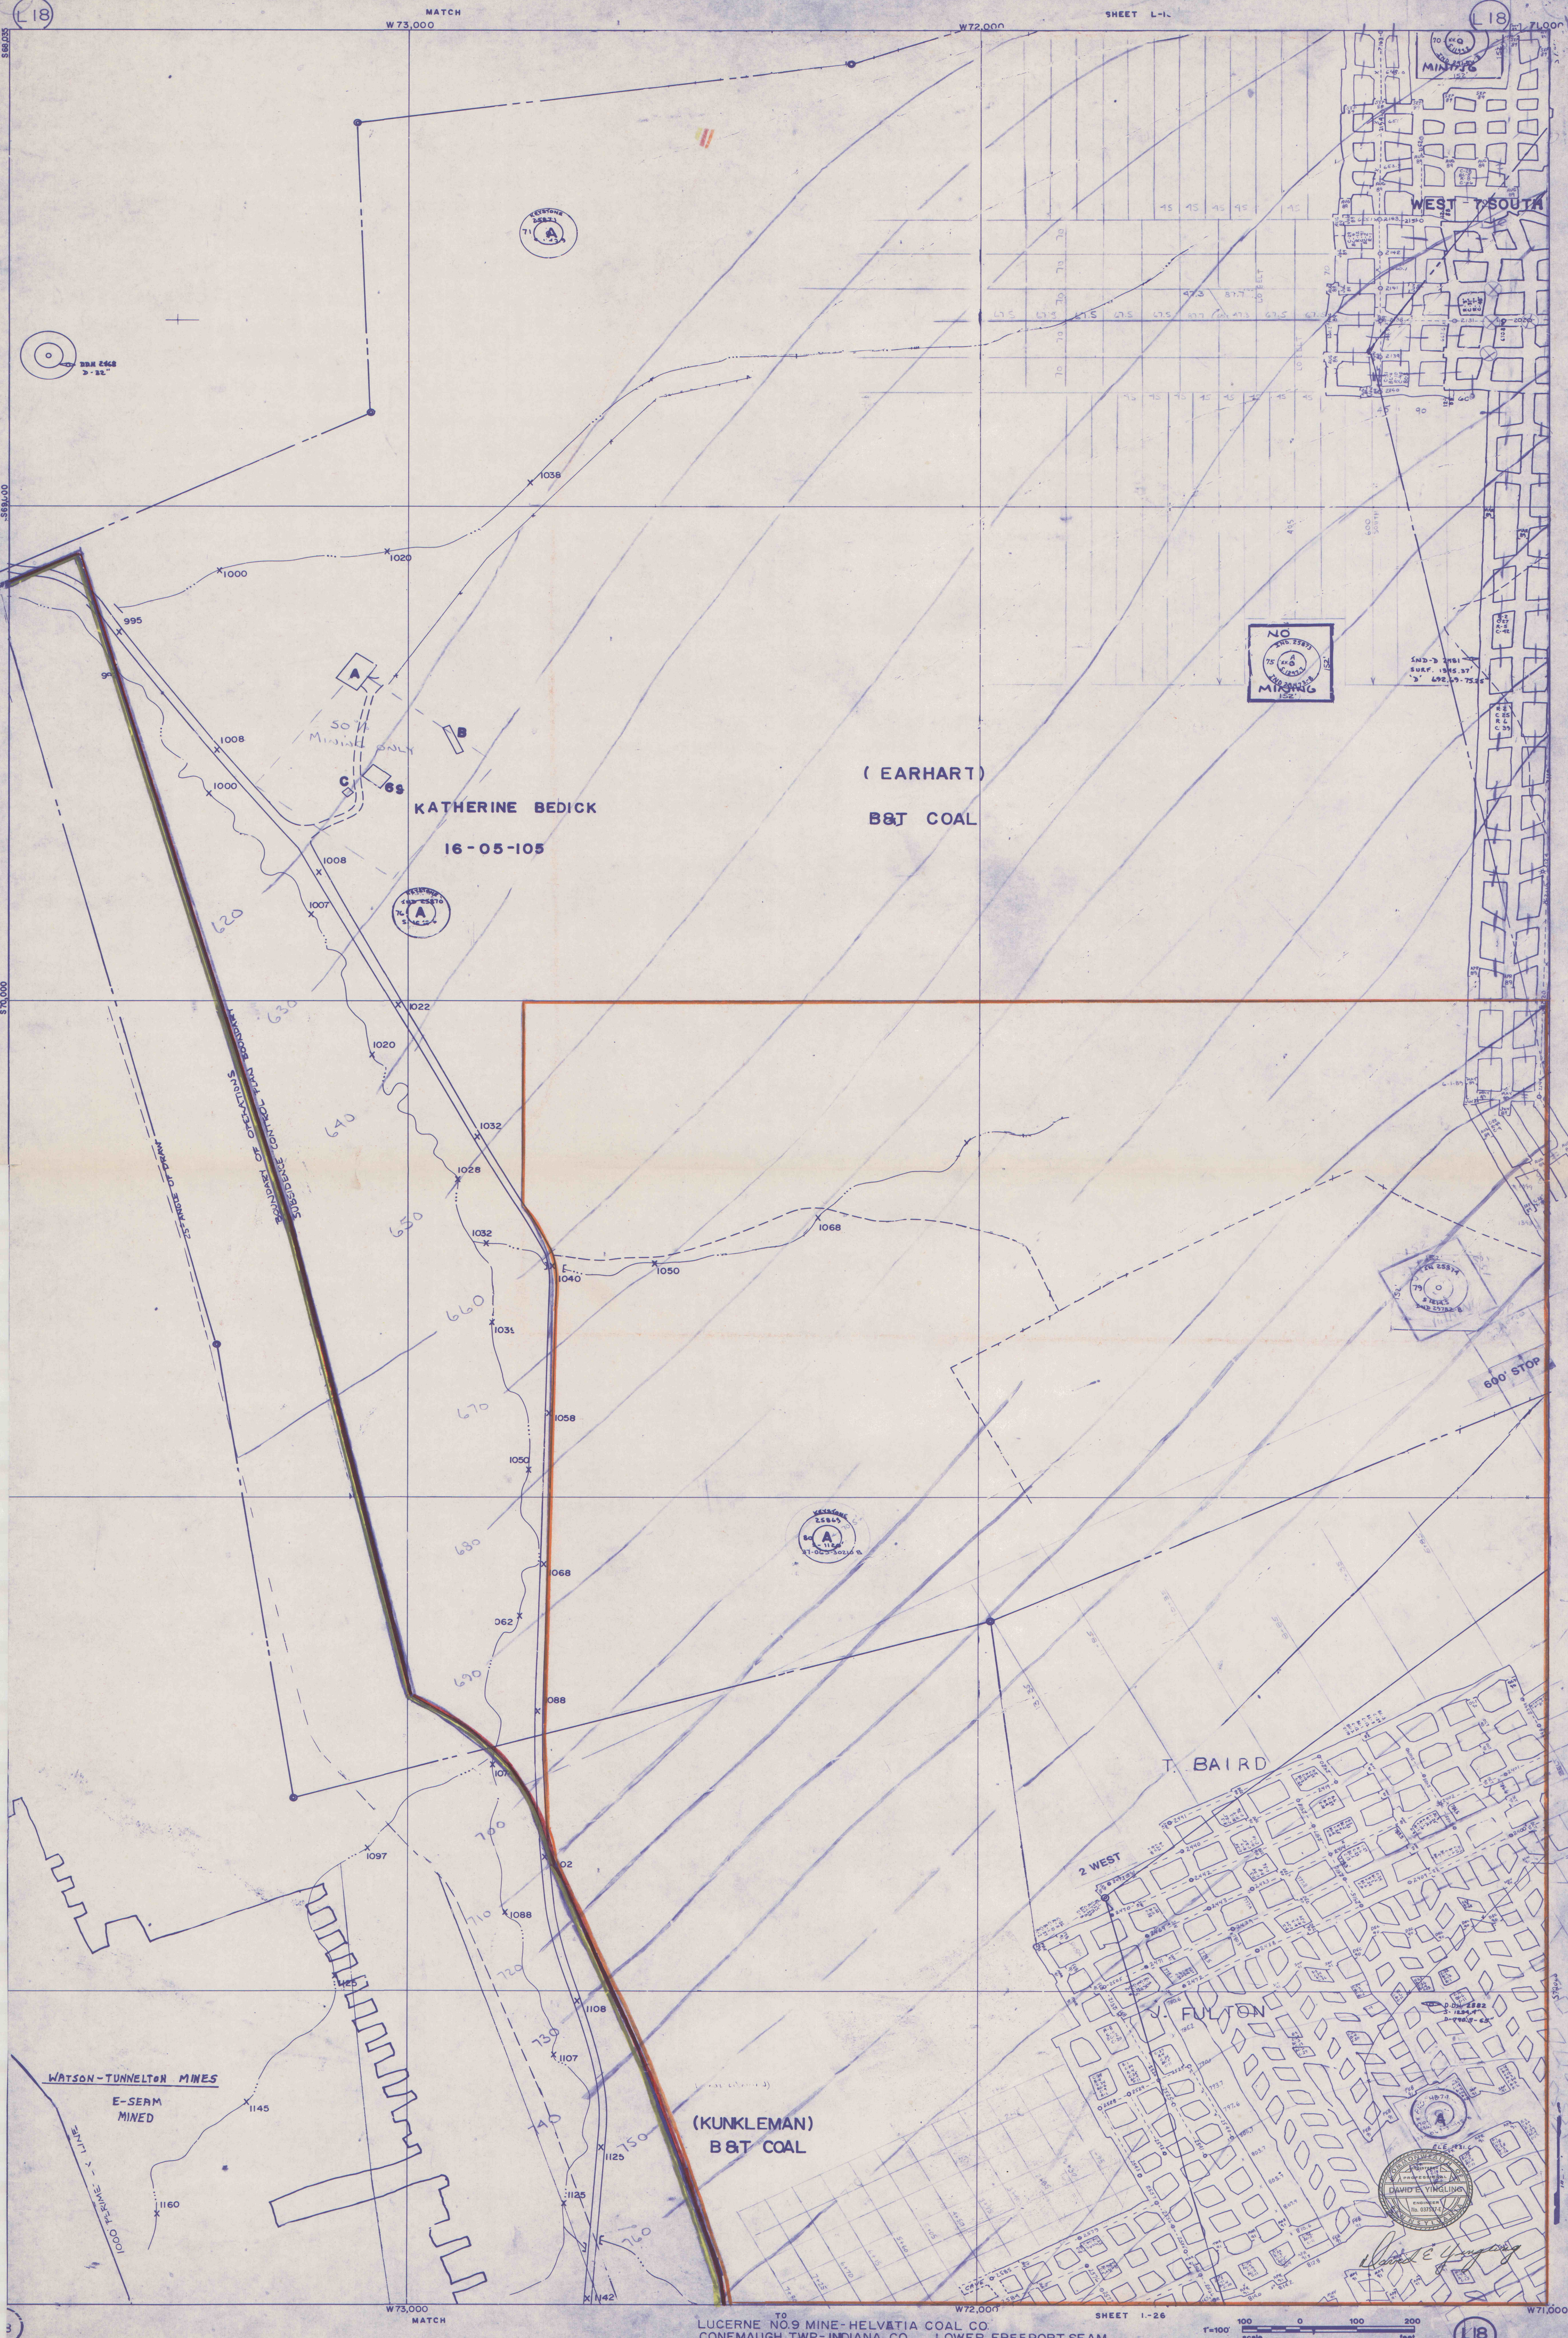

TO
LUCERNE NO.9 MINE-HELVATIA COAL CO.
CONEMAUGH TWP-INDIANA CO. LOWER FREEPORT SEAM

SHEET 1-26

100 0 100 200
scale feet

POSTED 6-1-91 CONTEMPLATED MINING 6-1-91 TO 12-1-91