



L18

L18

MATCH
W73,000

SHEET L-1
W72,000

W71,000

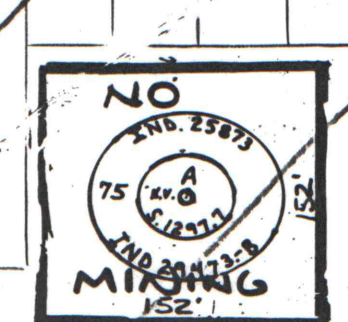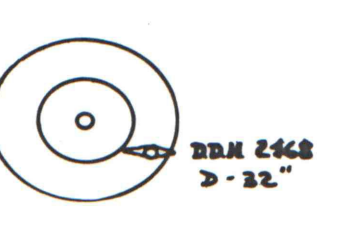

5247.781
SURF. 1986.37
3 692.57-75.52

KATHERINE BEDICK
16-05-105


(EARHART)
B&T COAL

T. BAIRD

J. FULTON

(KUNKLEMAN)
B&T COAL

WATSON-TUNNELTON MINES
E-SEAM MINED

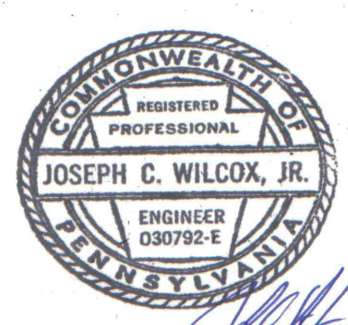

TO
LUCERNE NO. 9 MINE-HELVETIA COAL CO.
CONEMAUGH TWP-INDIANA CO. LOWER FREEPORT SEAM

SHEET 1-26



L18

POSTED 6-1-90 CONTEMPLATED MINING 6-1-90 TO 12-1-90