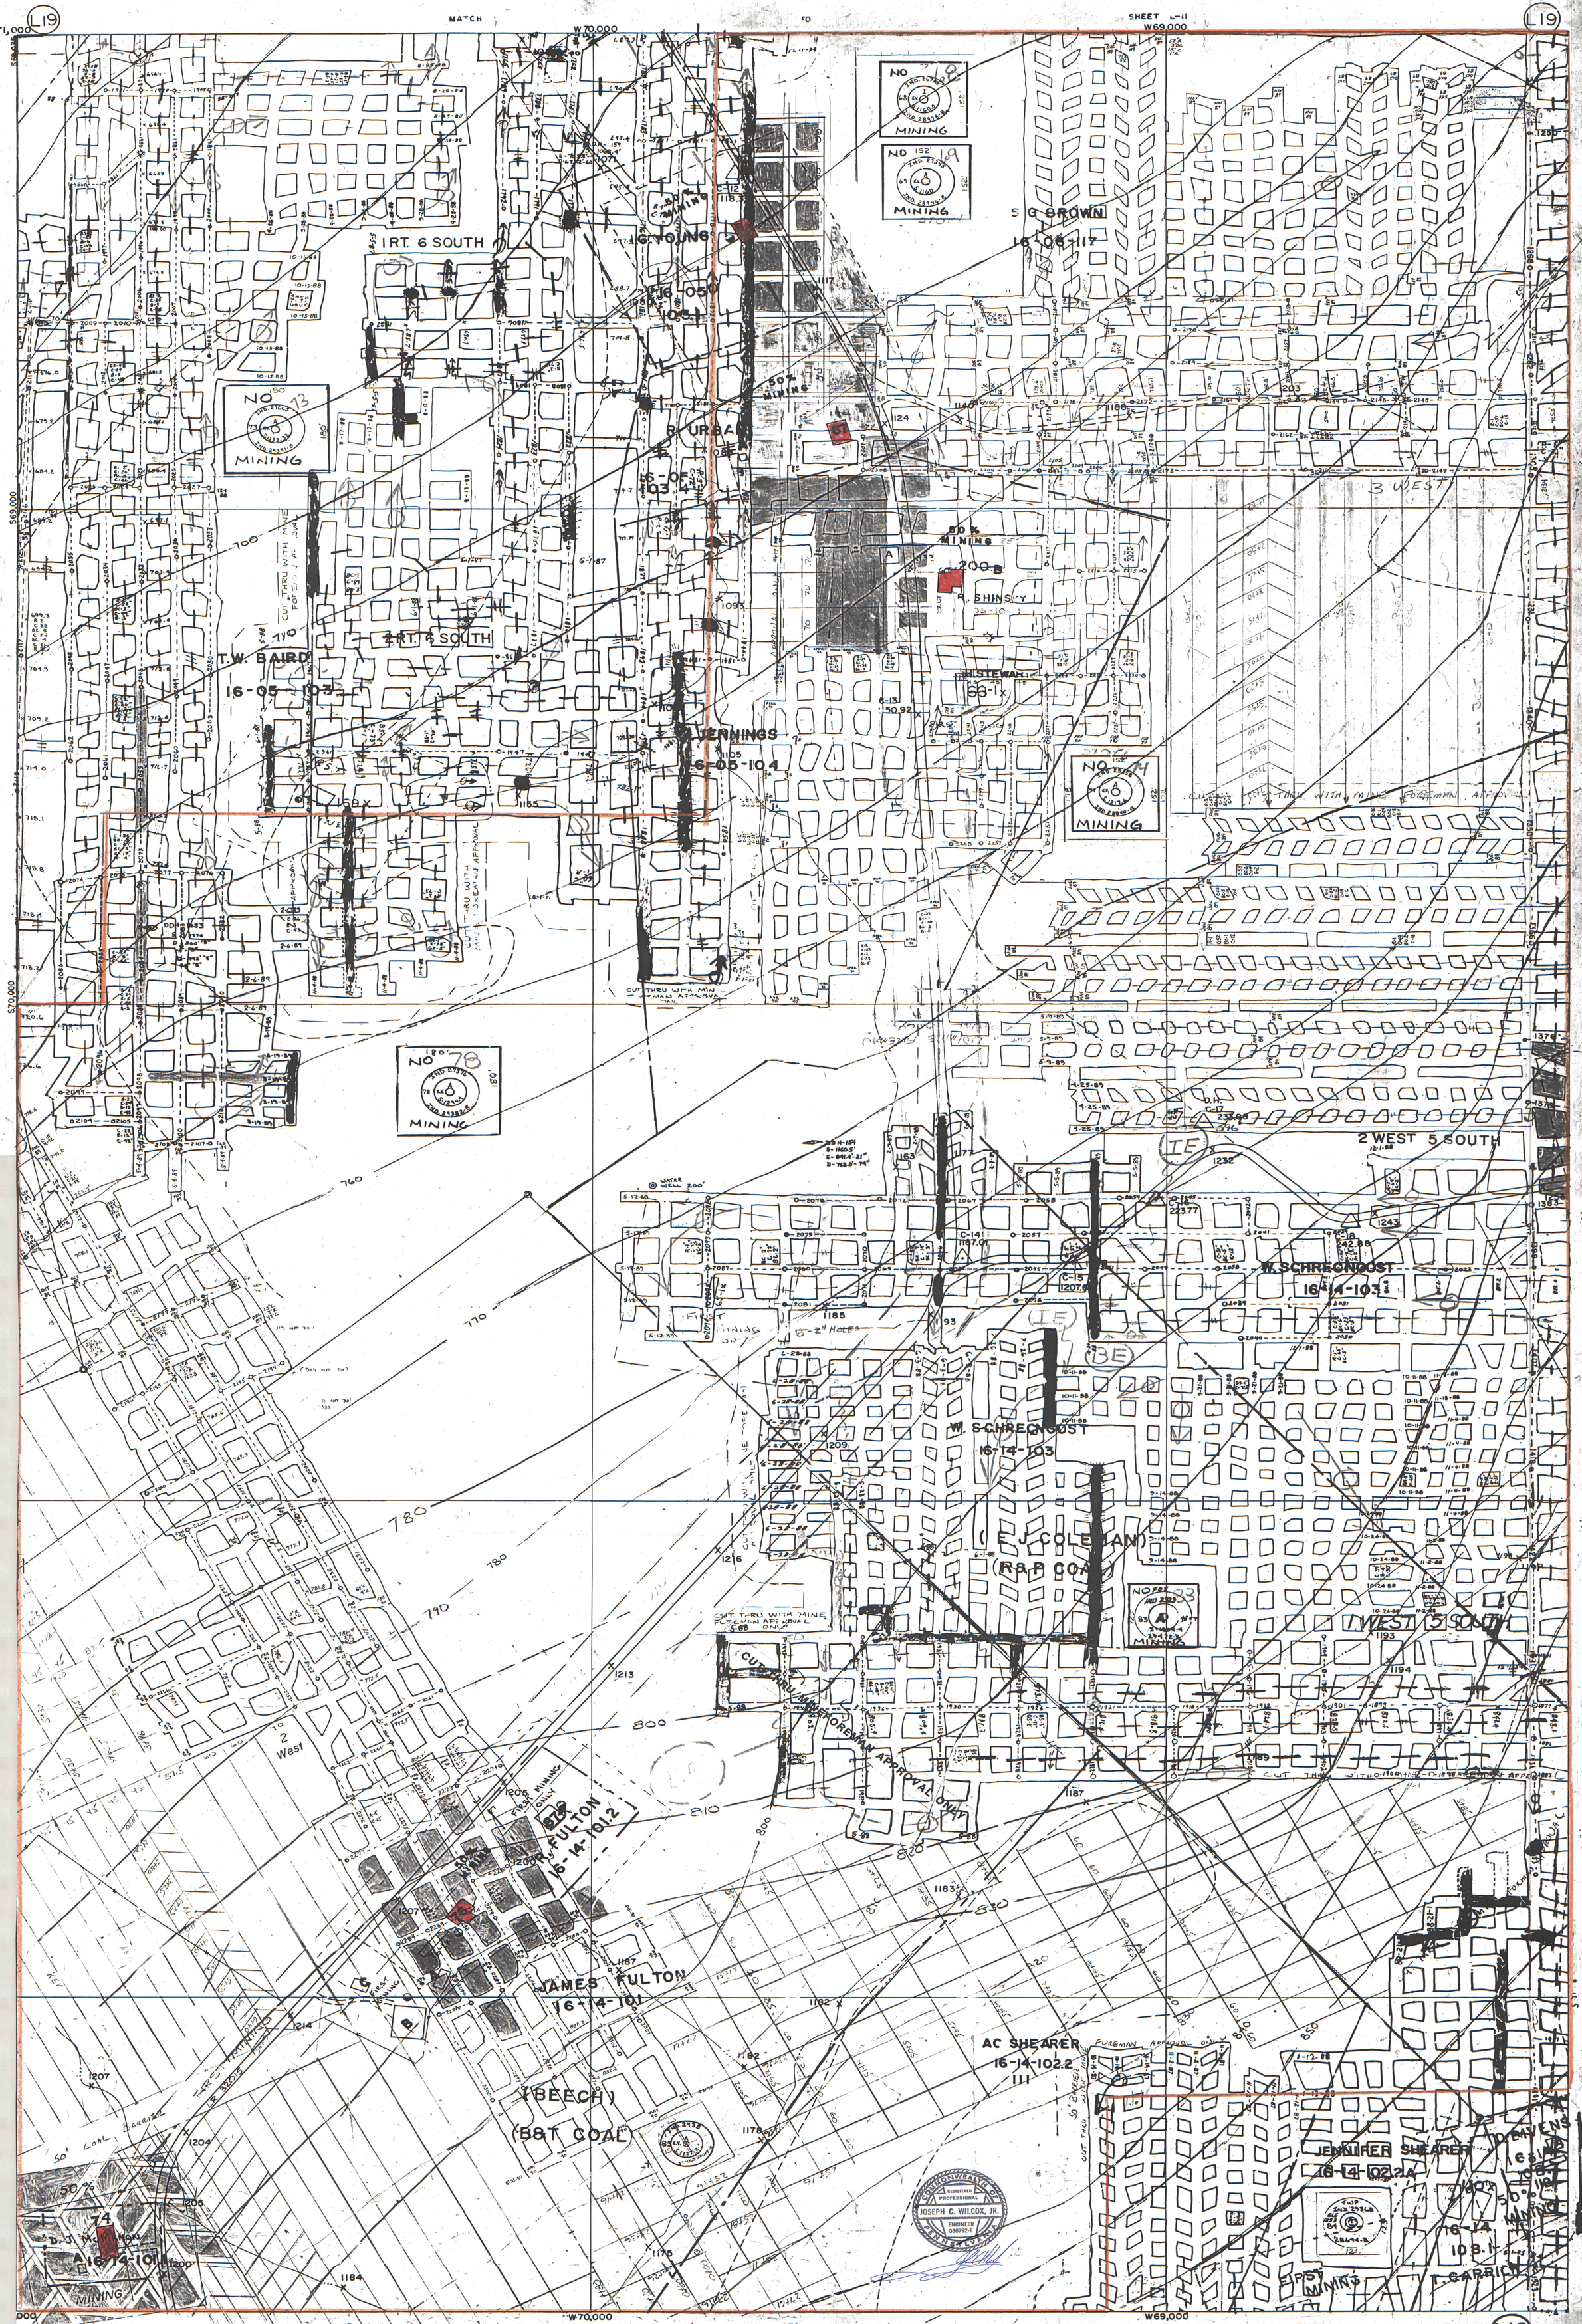
MATCH TO SHEET L-11
W70,000
W69,000
S69,000
S70,000
L19
1RT. 6 SOUTH
2RT. 6 SOUTH
T.W. BAIRD
16-05-103
VERNINGS
6-05-104
S G BROWN
16-06-117
B. URBAN
3 WEST
2 WEST 5 SOUTH
W. SCHREGNOOST
16-14-103
(E J COLEMAN)
(R&P COAL)
1 WEST 5 SOUTH
JAMES FULTON
16-14-101
(BEECH)
(BST COAL)
AC SHEARER
16-14-102.2
JENNIFER SHEARER
16-14-102.2A
D. J. McMILLAN
16-14-101
MINING
NO 78
NO 74
NO 73
NO 80
NO 152
NO 83
50% MINING
FIRST MINING ONLY
CUT THRU WITH MINE FOREMAN APPROVAL ONLY
COMMONWEALTH OF PENNSYLVANIA
REGISTERED PROFESSIONAL
JOSEPH C. WILCOX, JR.
ENGINEER
030792-E
HELVETIA COAL COMPANY, LUCERNE No. 9, 36-05374, 352-3.
CONEMAUGH TWP. INDIANA CO. LOWER FREEPORT SEAM
SHEET L-27
1"=100'
scale
POSTED 6-1-90
CONTEMPLATED MINING 6-1-90 TO 12-1-90