



L18

MATCH
W73,000

SHEET L-1

L18

W71,000

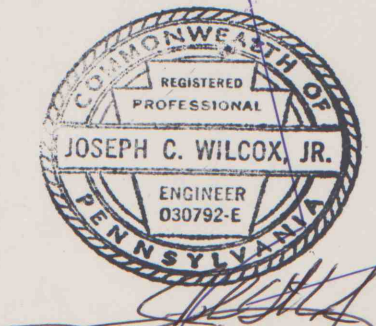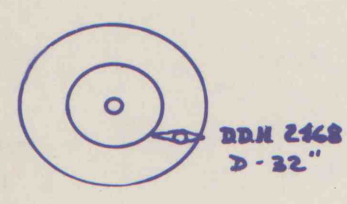

WATSON-TUNNELTON MINES

E-SEAM MINED

KATHERINE BEDICK
16-05-105

(EARHART)
B&T COAL

T. BAIRD

J. FULTON

(KUNKLEMAN)
B&T COAL

TO
LUCERNE NO. 9 MINE-HELVETIA COAL CO.
CONEMAUGH TWP-INDIANA CO. LOWER FREEPORT SEAM

SHEET 1-26

1"=100'
scale
0 100 200
feet

L18

POSTED 12-1-89 CONTEMPLATED MINING 12-1-89 TO 6-1-90