


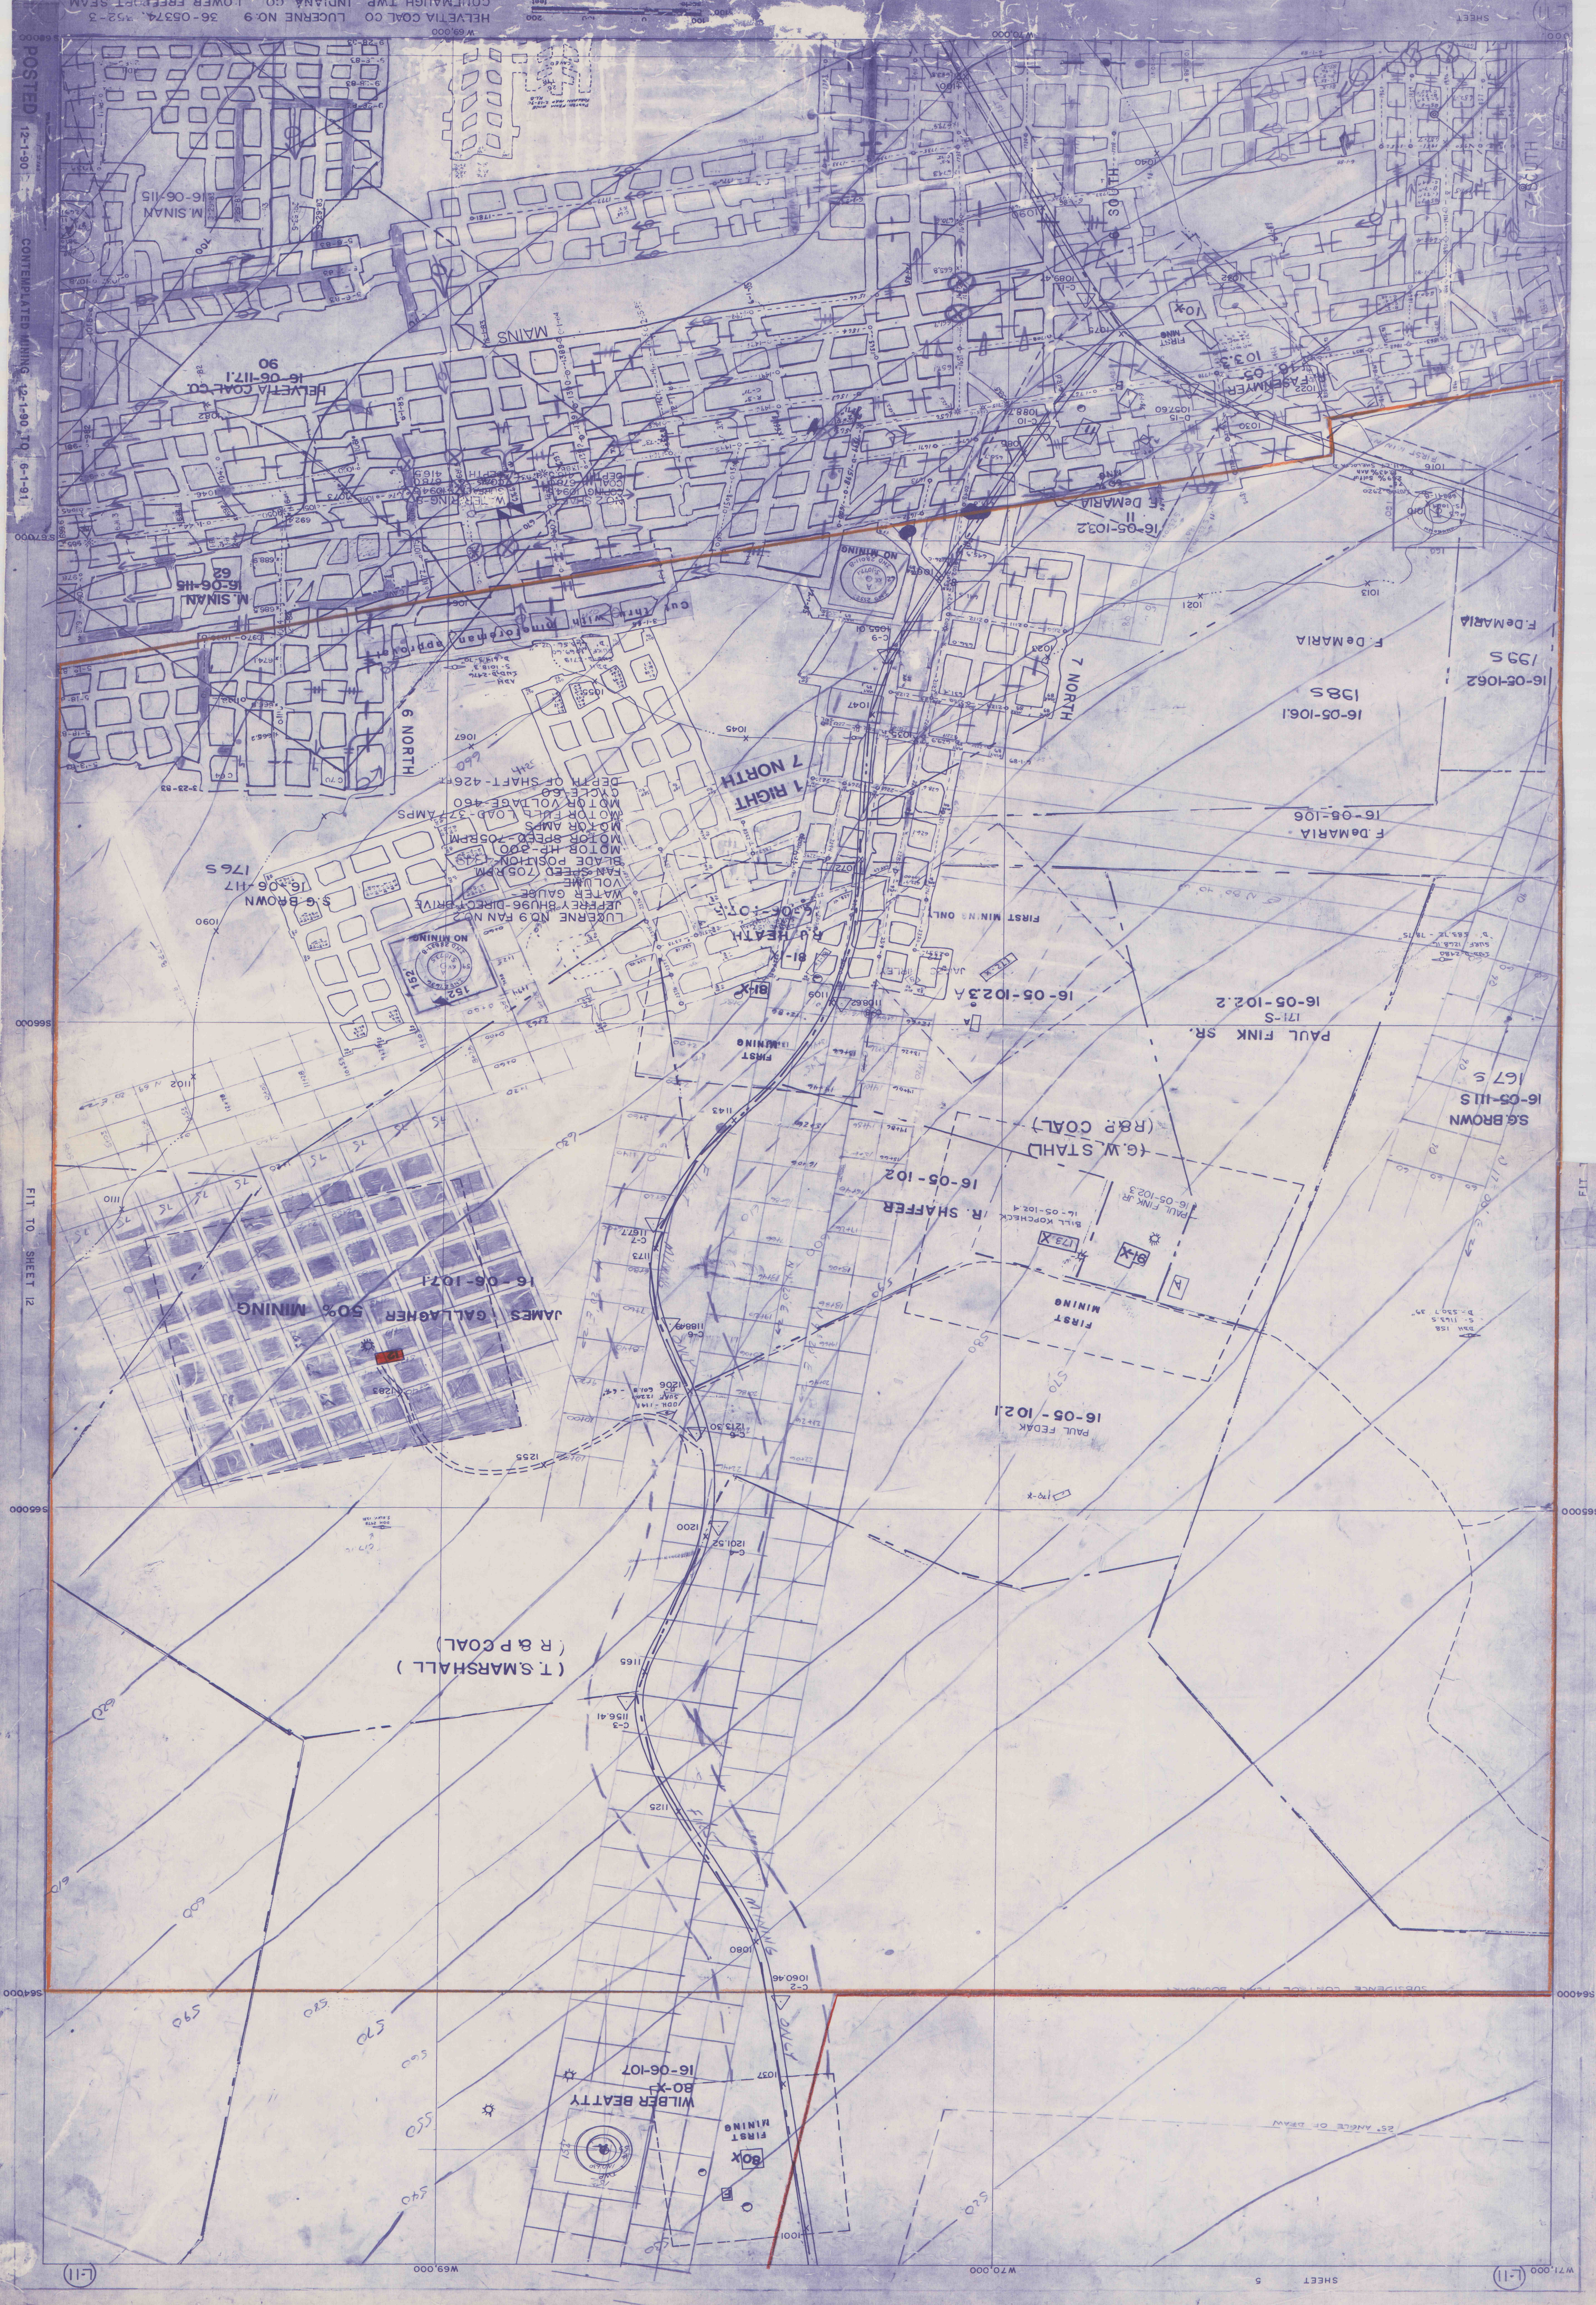

POSTED 12-1-90
FIT TO SHEET 12

SHEET 5
L-11
W71,000
S64,000
S65,000
S66,000
S67,000