


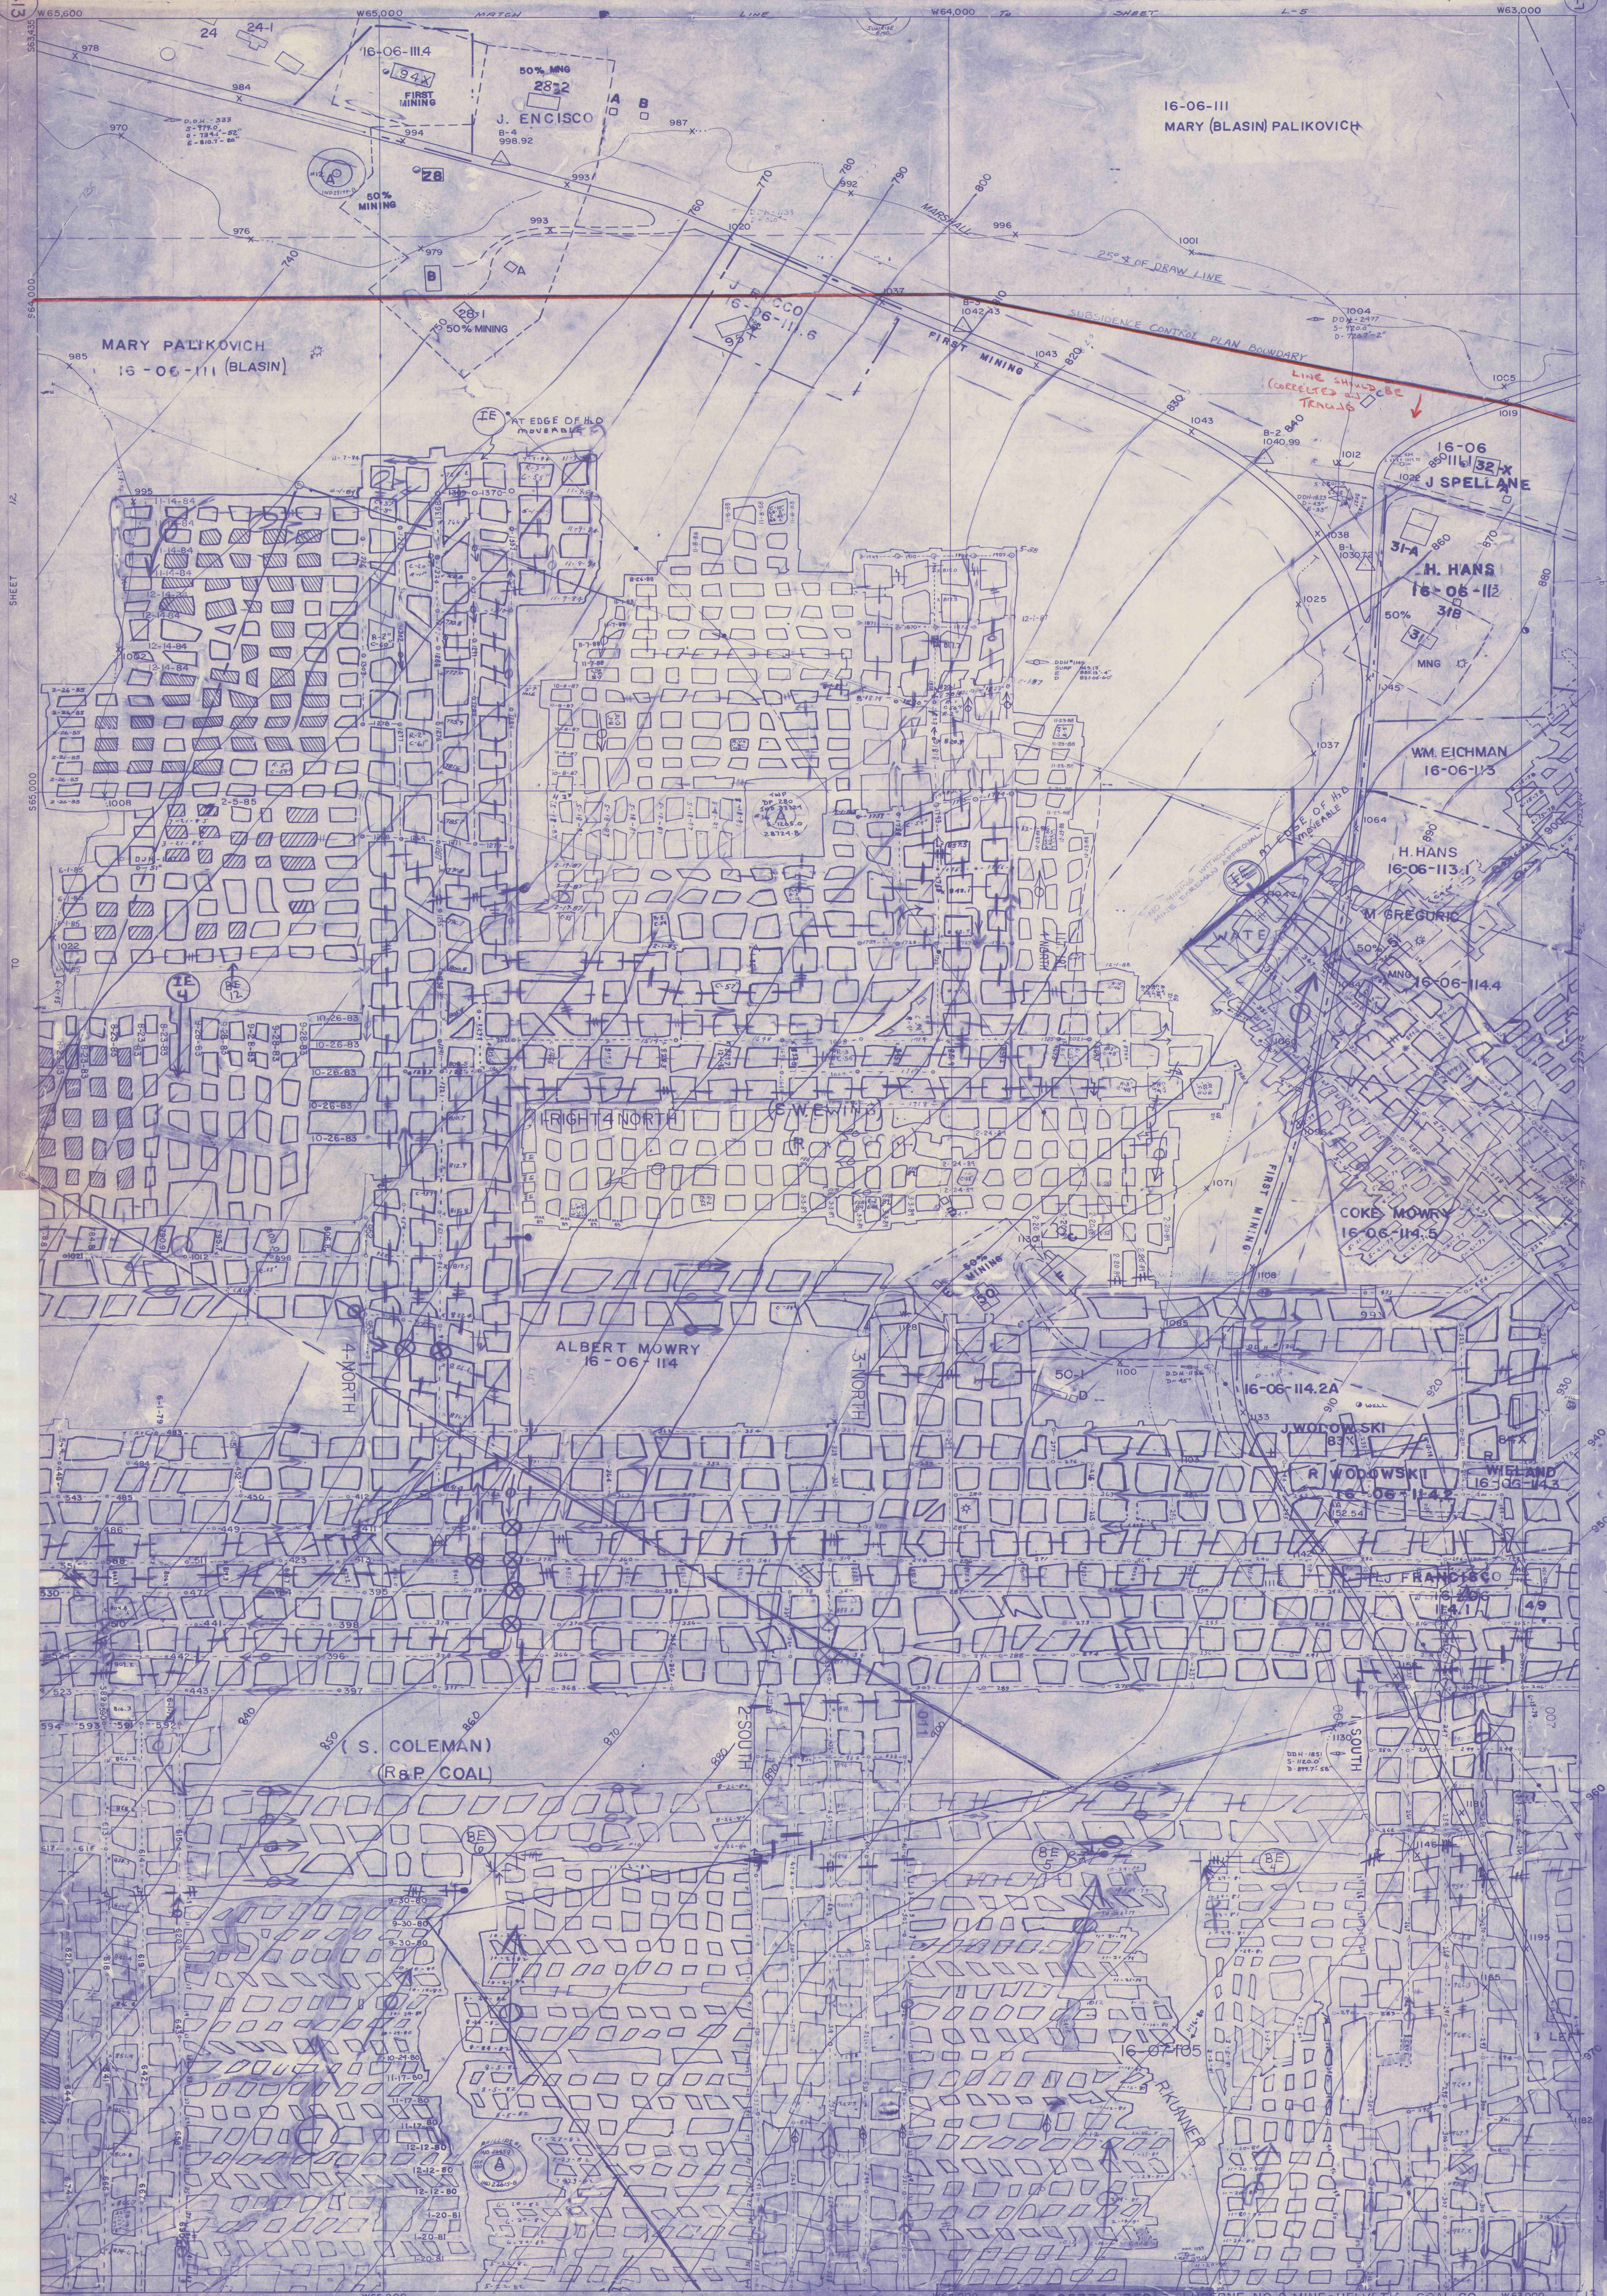

POSTED
68-1-9
CONTEMPLATED MINING 6-1-78 TO 6-1-88