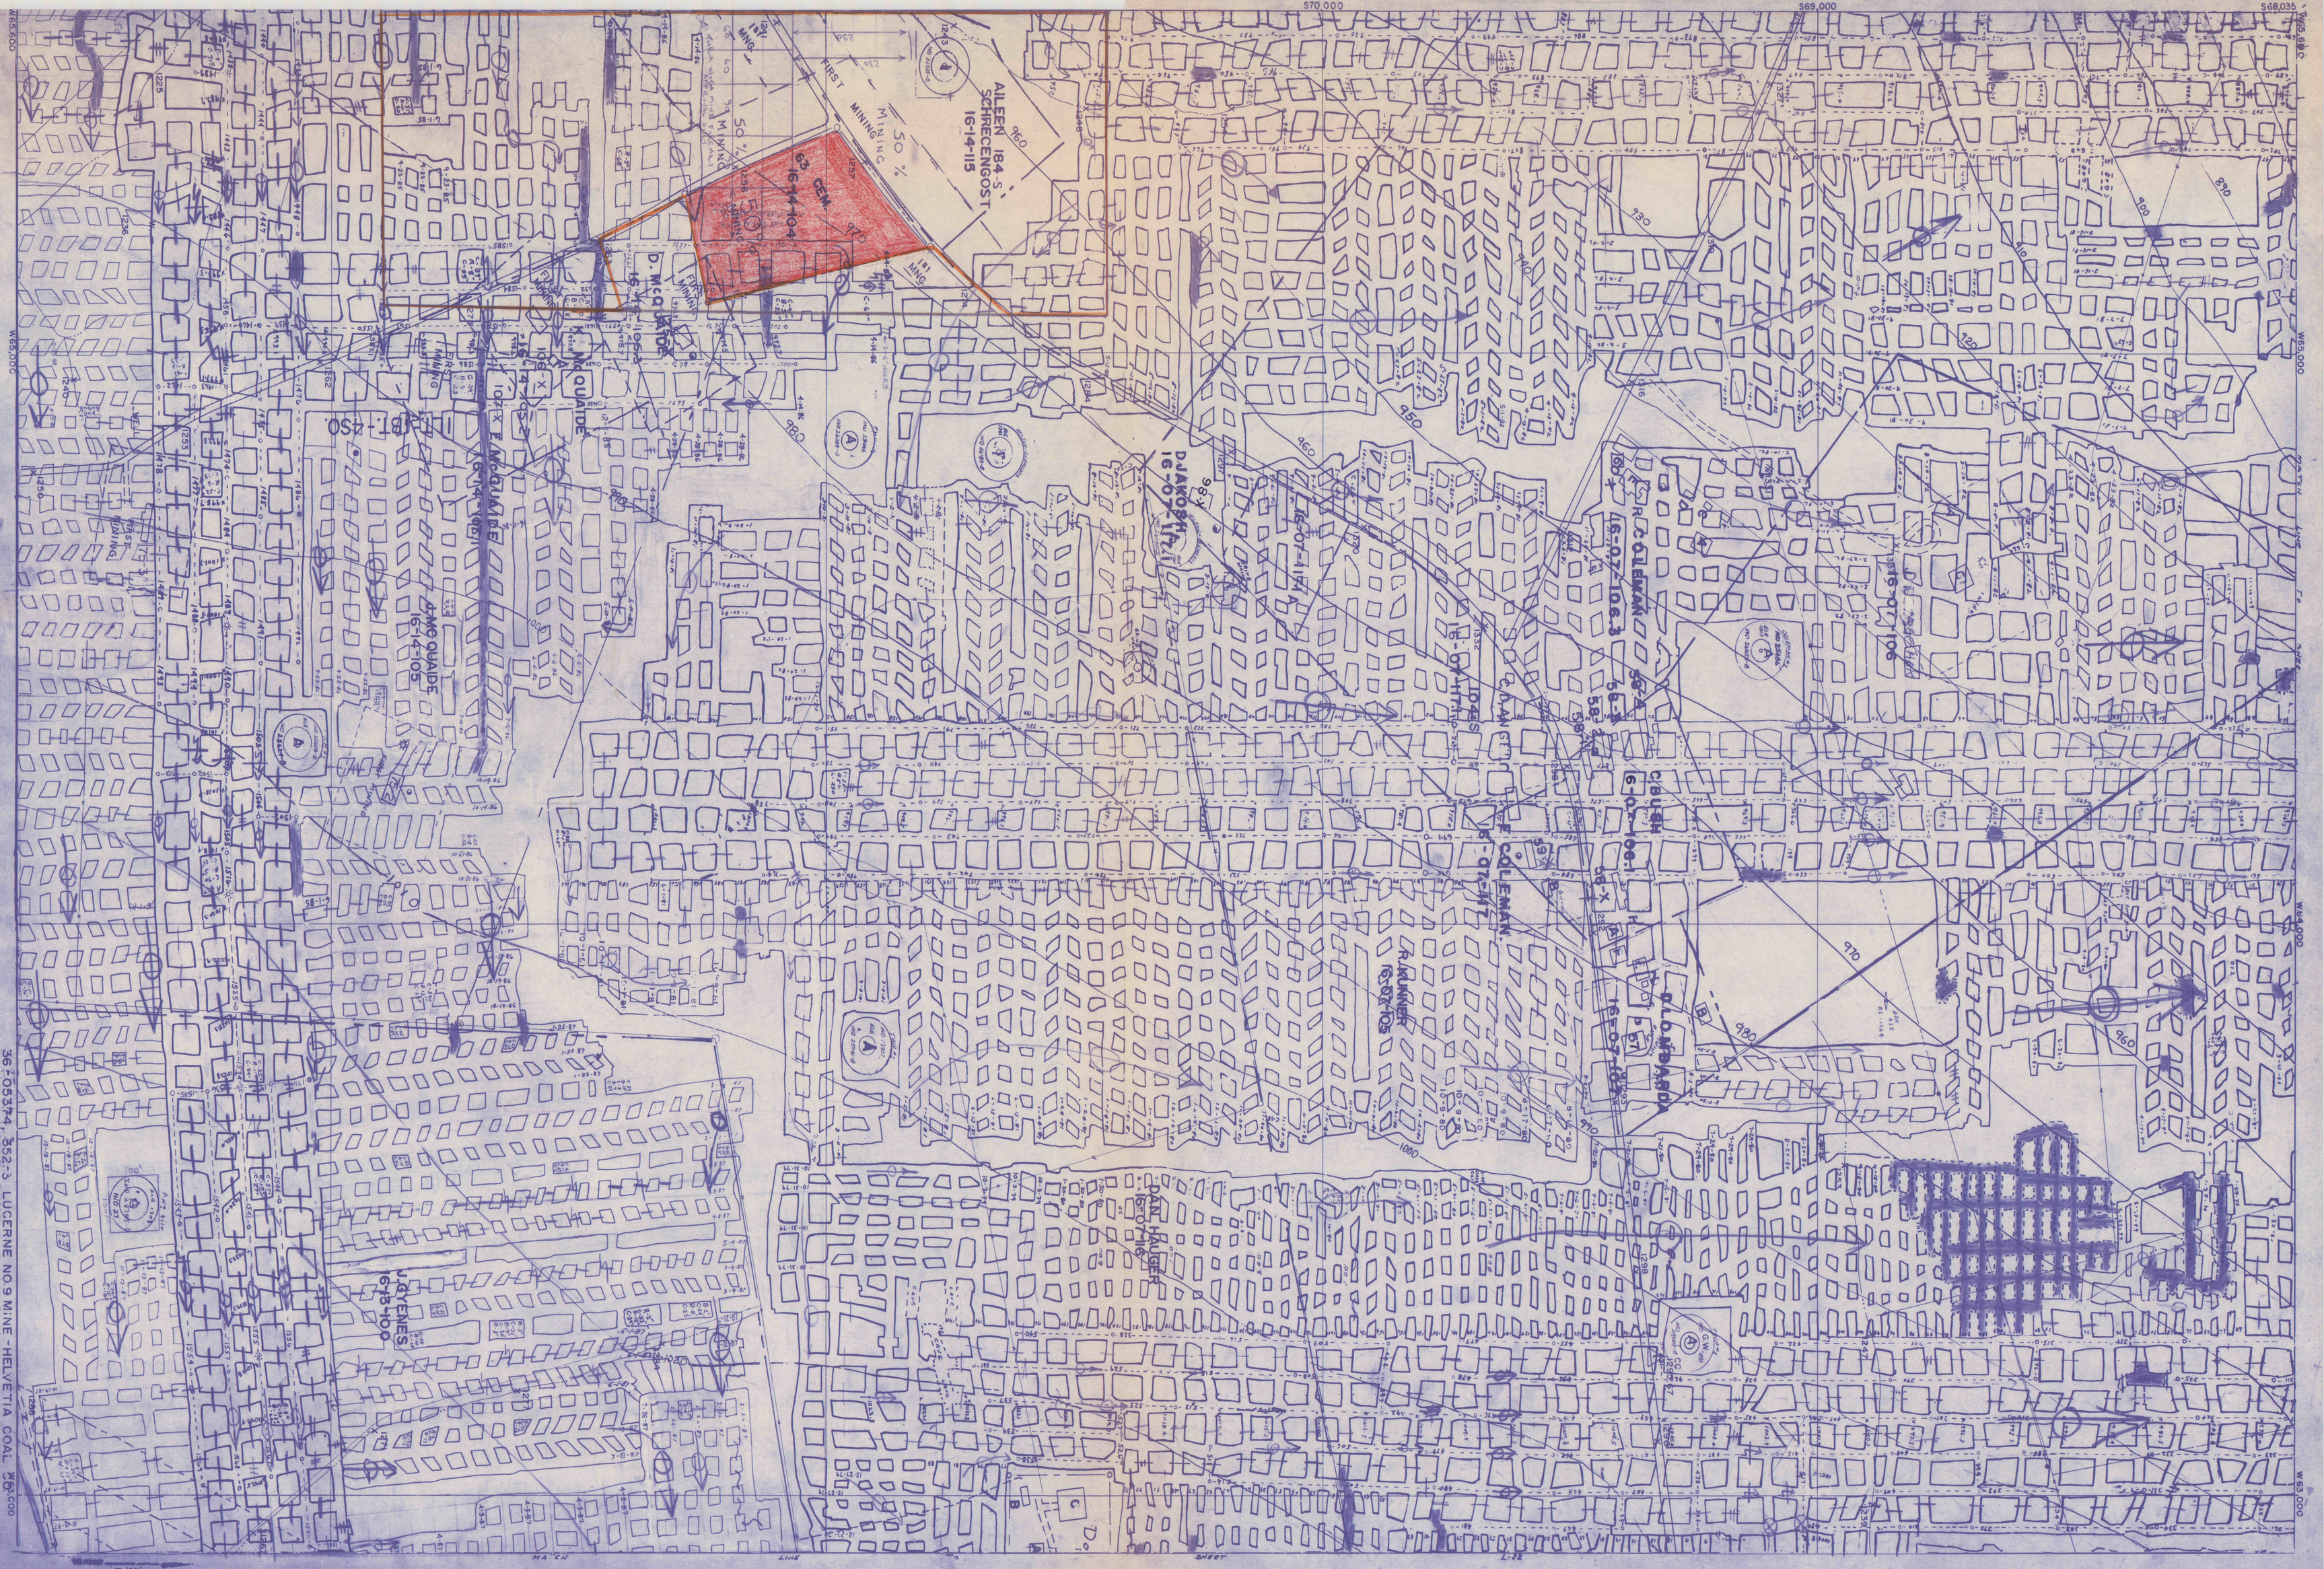
SHEET
L-20
$70,000
$69,000
$68,035
W 65,000
W 64,000
W 63,000
FIRST
MINING
50 %
ALLEEN 184-S SCHRECENGOST 16-14-115
63 GEM 16-14-104
D. McQUAIDE 16-14-102
