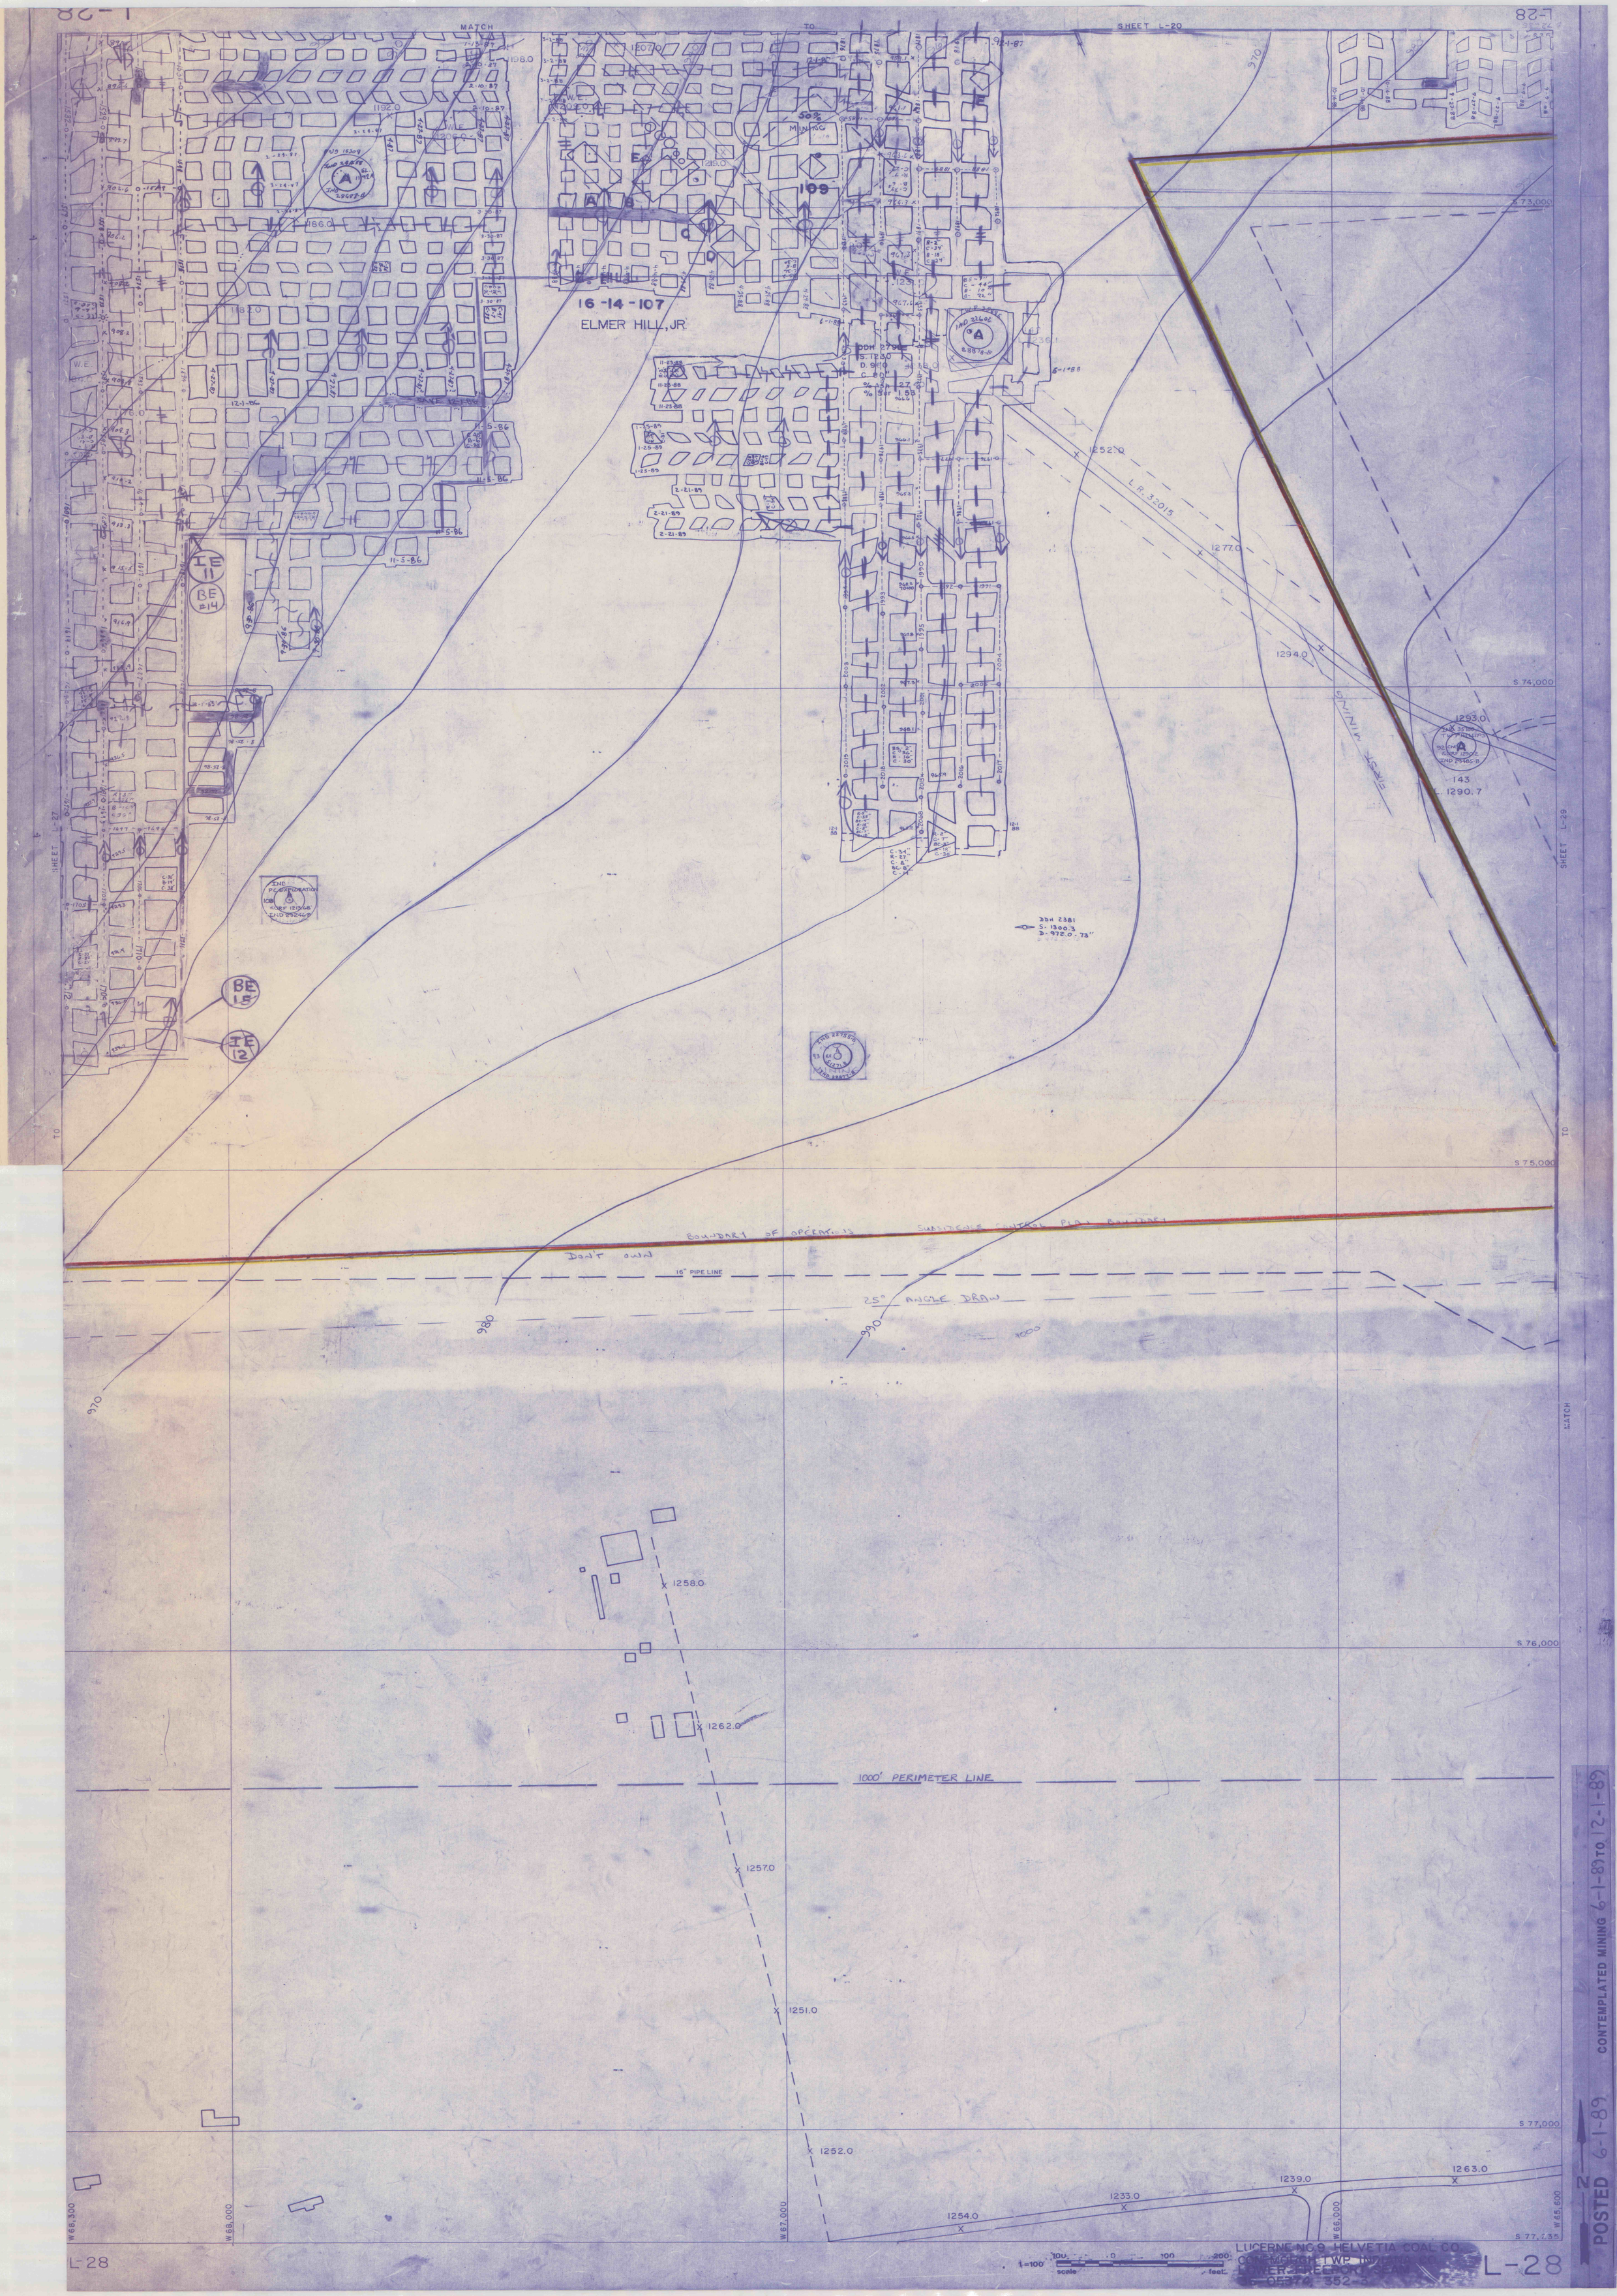
MATCH
TO
SHEET L-20
16-14-107
ELMER HILL, JR.
109
50%
MINING
L.R. 32015
1252.0
1277.0
1294.0
1293.0
143
EAST MINING
S 73,000
S 74,000
S 75,000
S 76,000
S 77,000
S 77,235
W 68,300
W 68,000
W 67,000
W 66,000
W 65,600
SHEET L-27
SHEET L-29
BOUNDARY OF OPERATIONS
SUBSIDENCE CONTROL PLAN BOUNDARY
DON'T OWN
16" PIPE LINE
25° ANGLE DRAW
1000' PERIMETER LINE
1258.0
1262.0
1257.0
1251.0
1252.0
1254.0
1233.0
1239.0
1263.0
970
980
990
1000
BE 15
TE 12
LE 11
BE #14
DDH 2381
S. 13003
D. 972.0-73"
1=100'
scale
feet
LUCERNE NO 9 HELVETIA COAL CO.
L-28
POSTED 6-1-89
CONTEMPLATED MINING 6-1-89 TO 12-1-89