


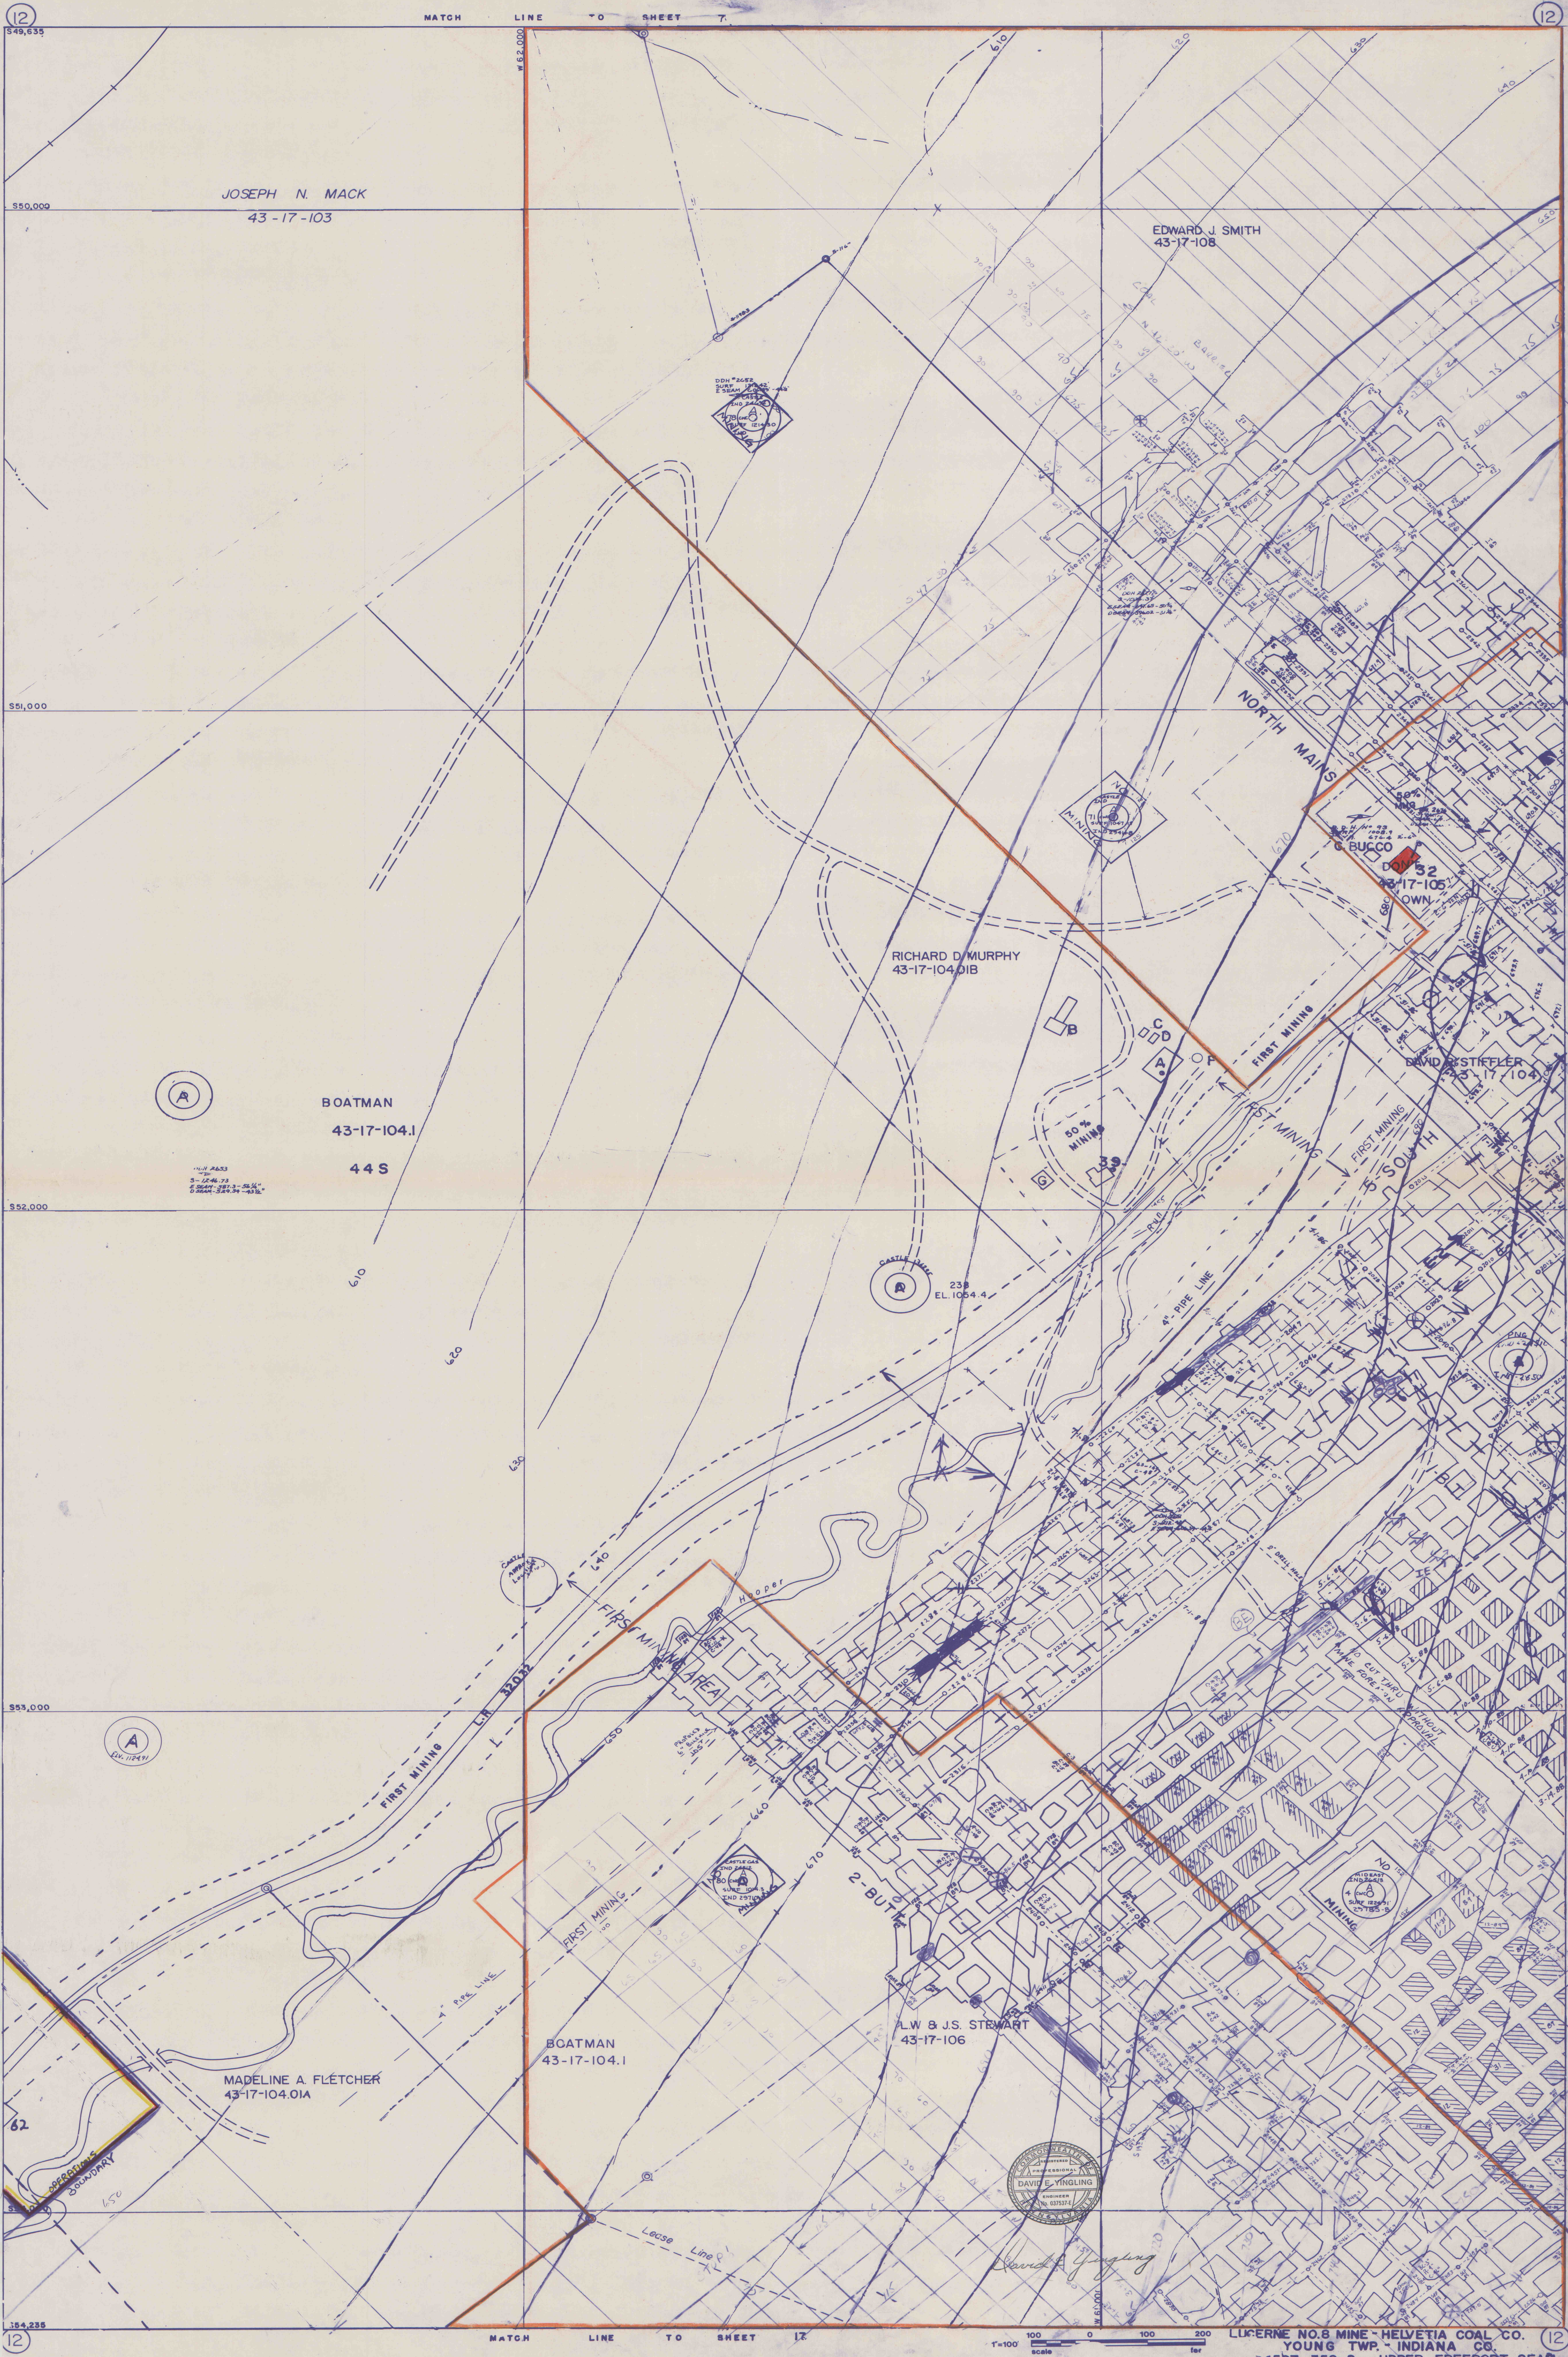

MATCH LINE TO SHEET 13

UPPER FREEPORT SEAM

382-2

POSTED 1-1-91 CONTEMPLATED MINING 1-1-91 TO 7-1-91

LUCERNE NO. 8 MINE - HELVETIA COAL CO.
YOUNG TWP. - INDIANA CO.
04597, 352-2 UPPER FREEPORT SEAM