


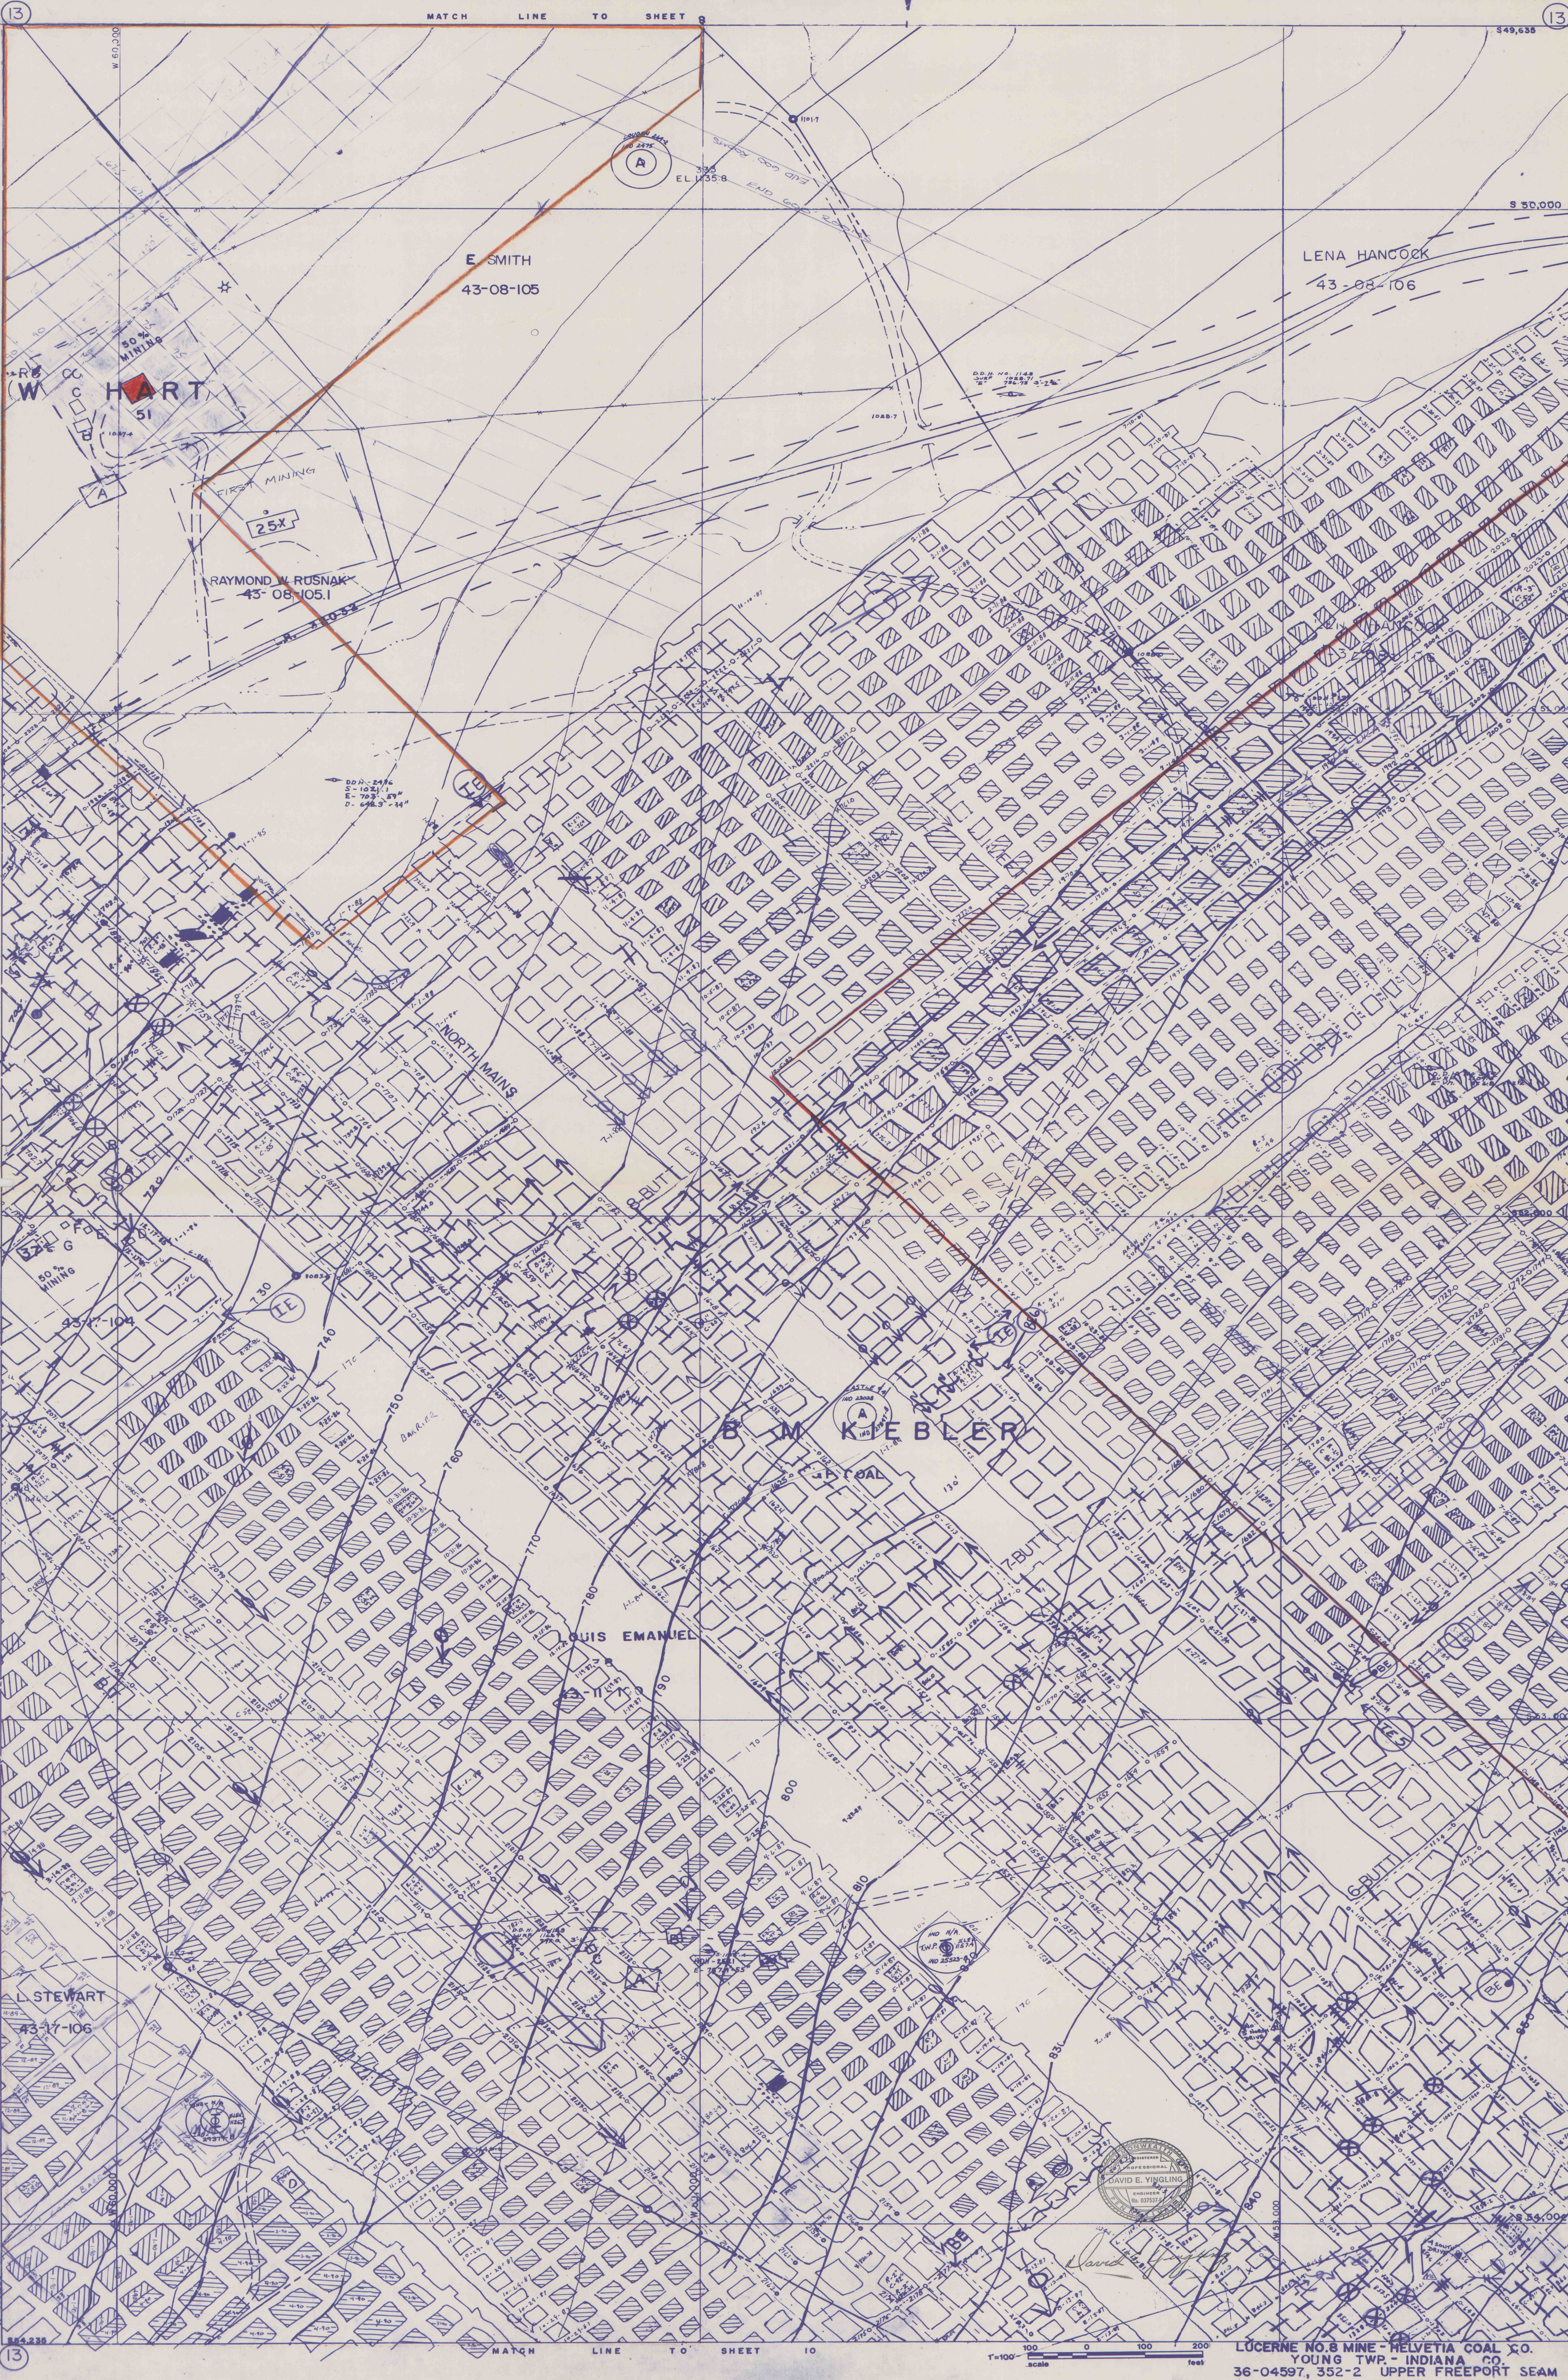

POSTED 1-1-91
CONTEMPLATED MINING 1-1-91 TO 7-1-91
UPPER FREEPORT SEAM