


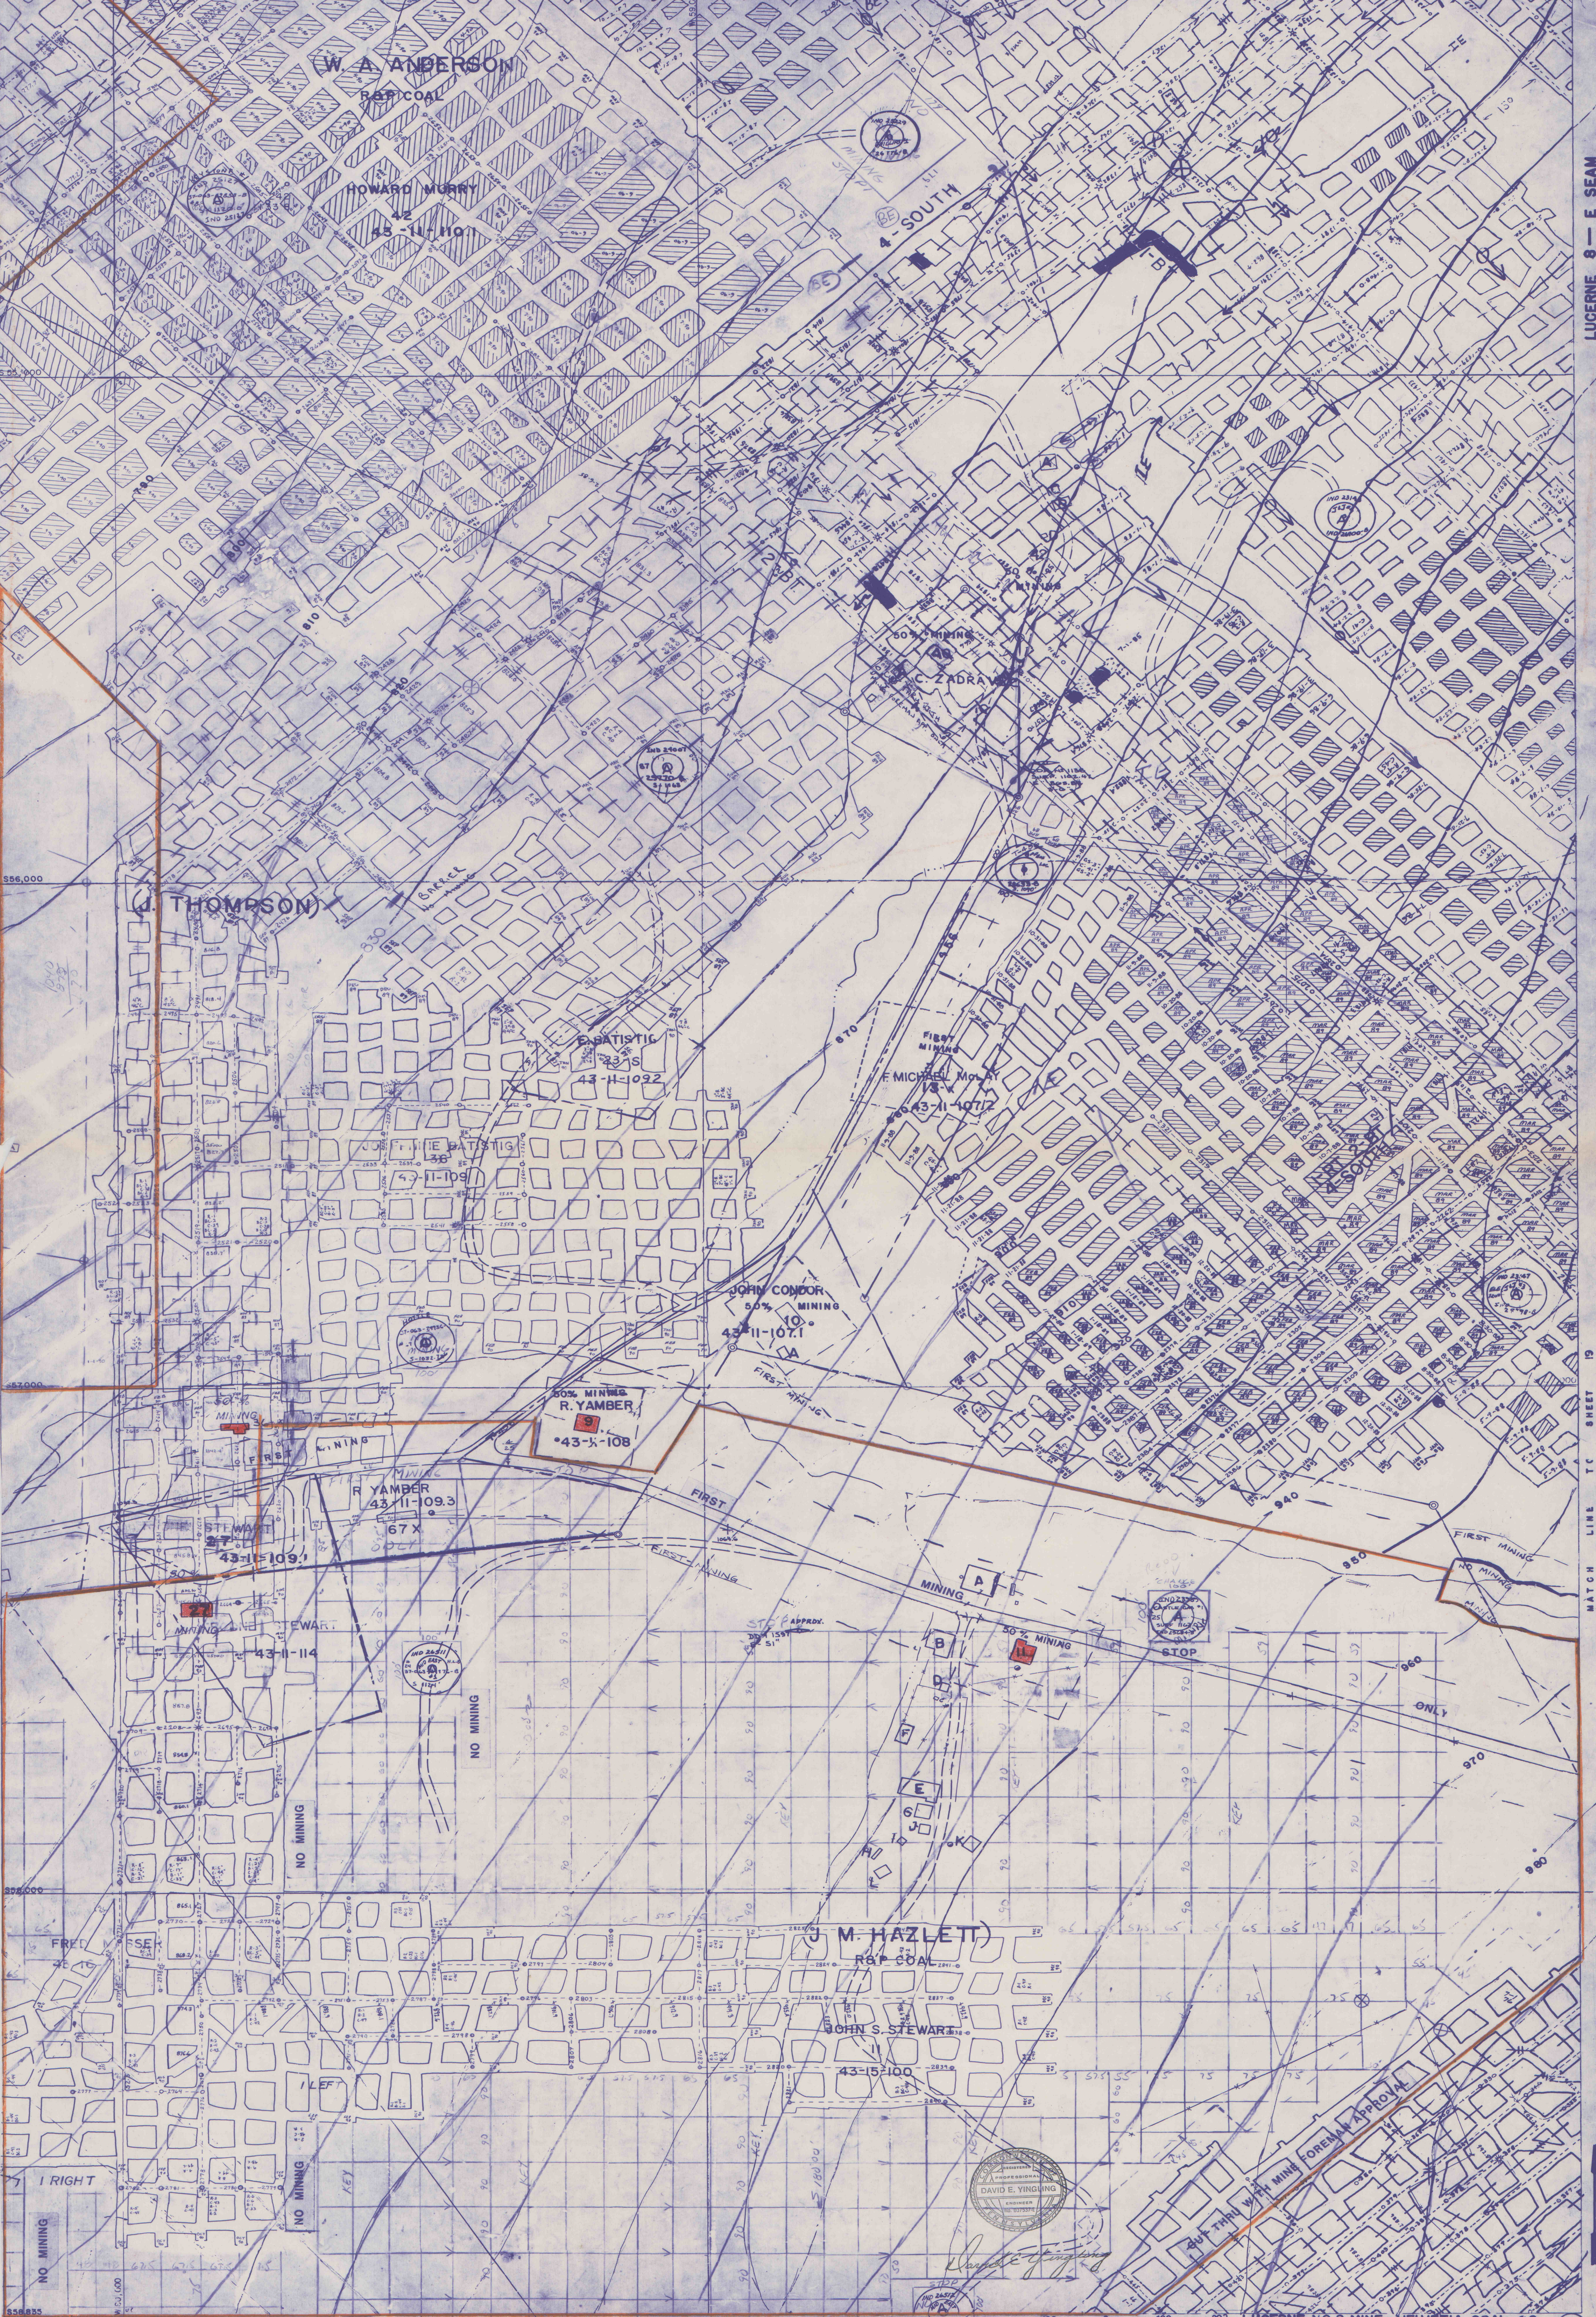

LUCERNE 8 - E SEAM

MATCH LINE TO SHEET 19

UPPER FREEPORT SEAM

POSTED 1-1-91

CONTEMPLATED MINING 1-1-91 TO 7-1-91