


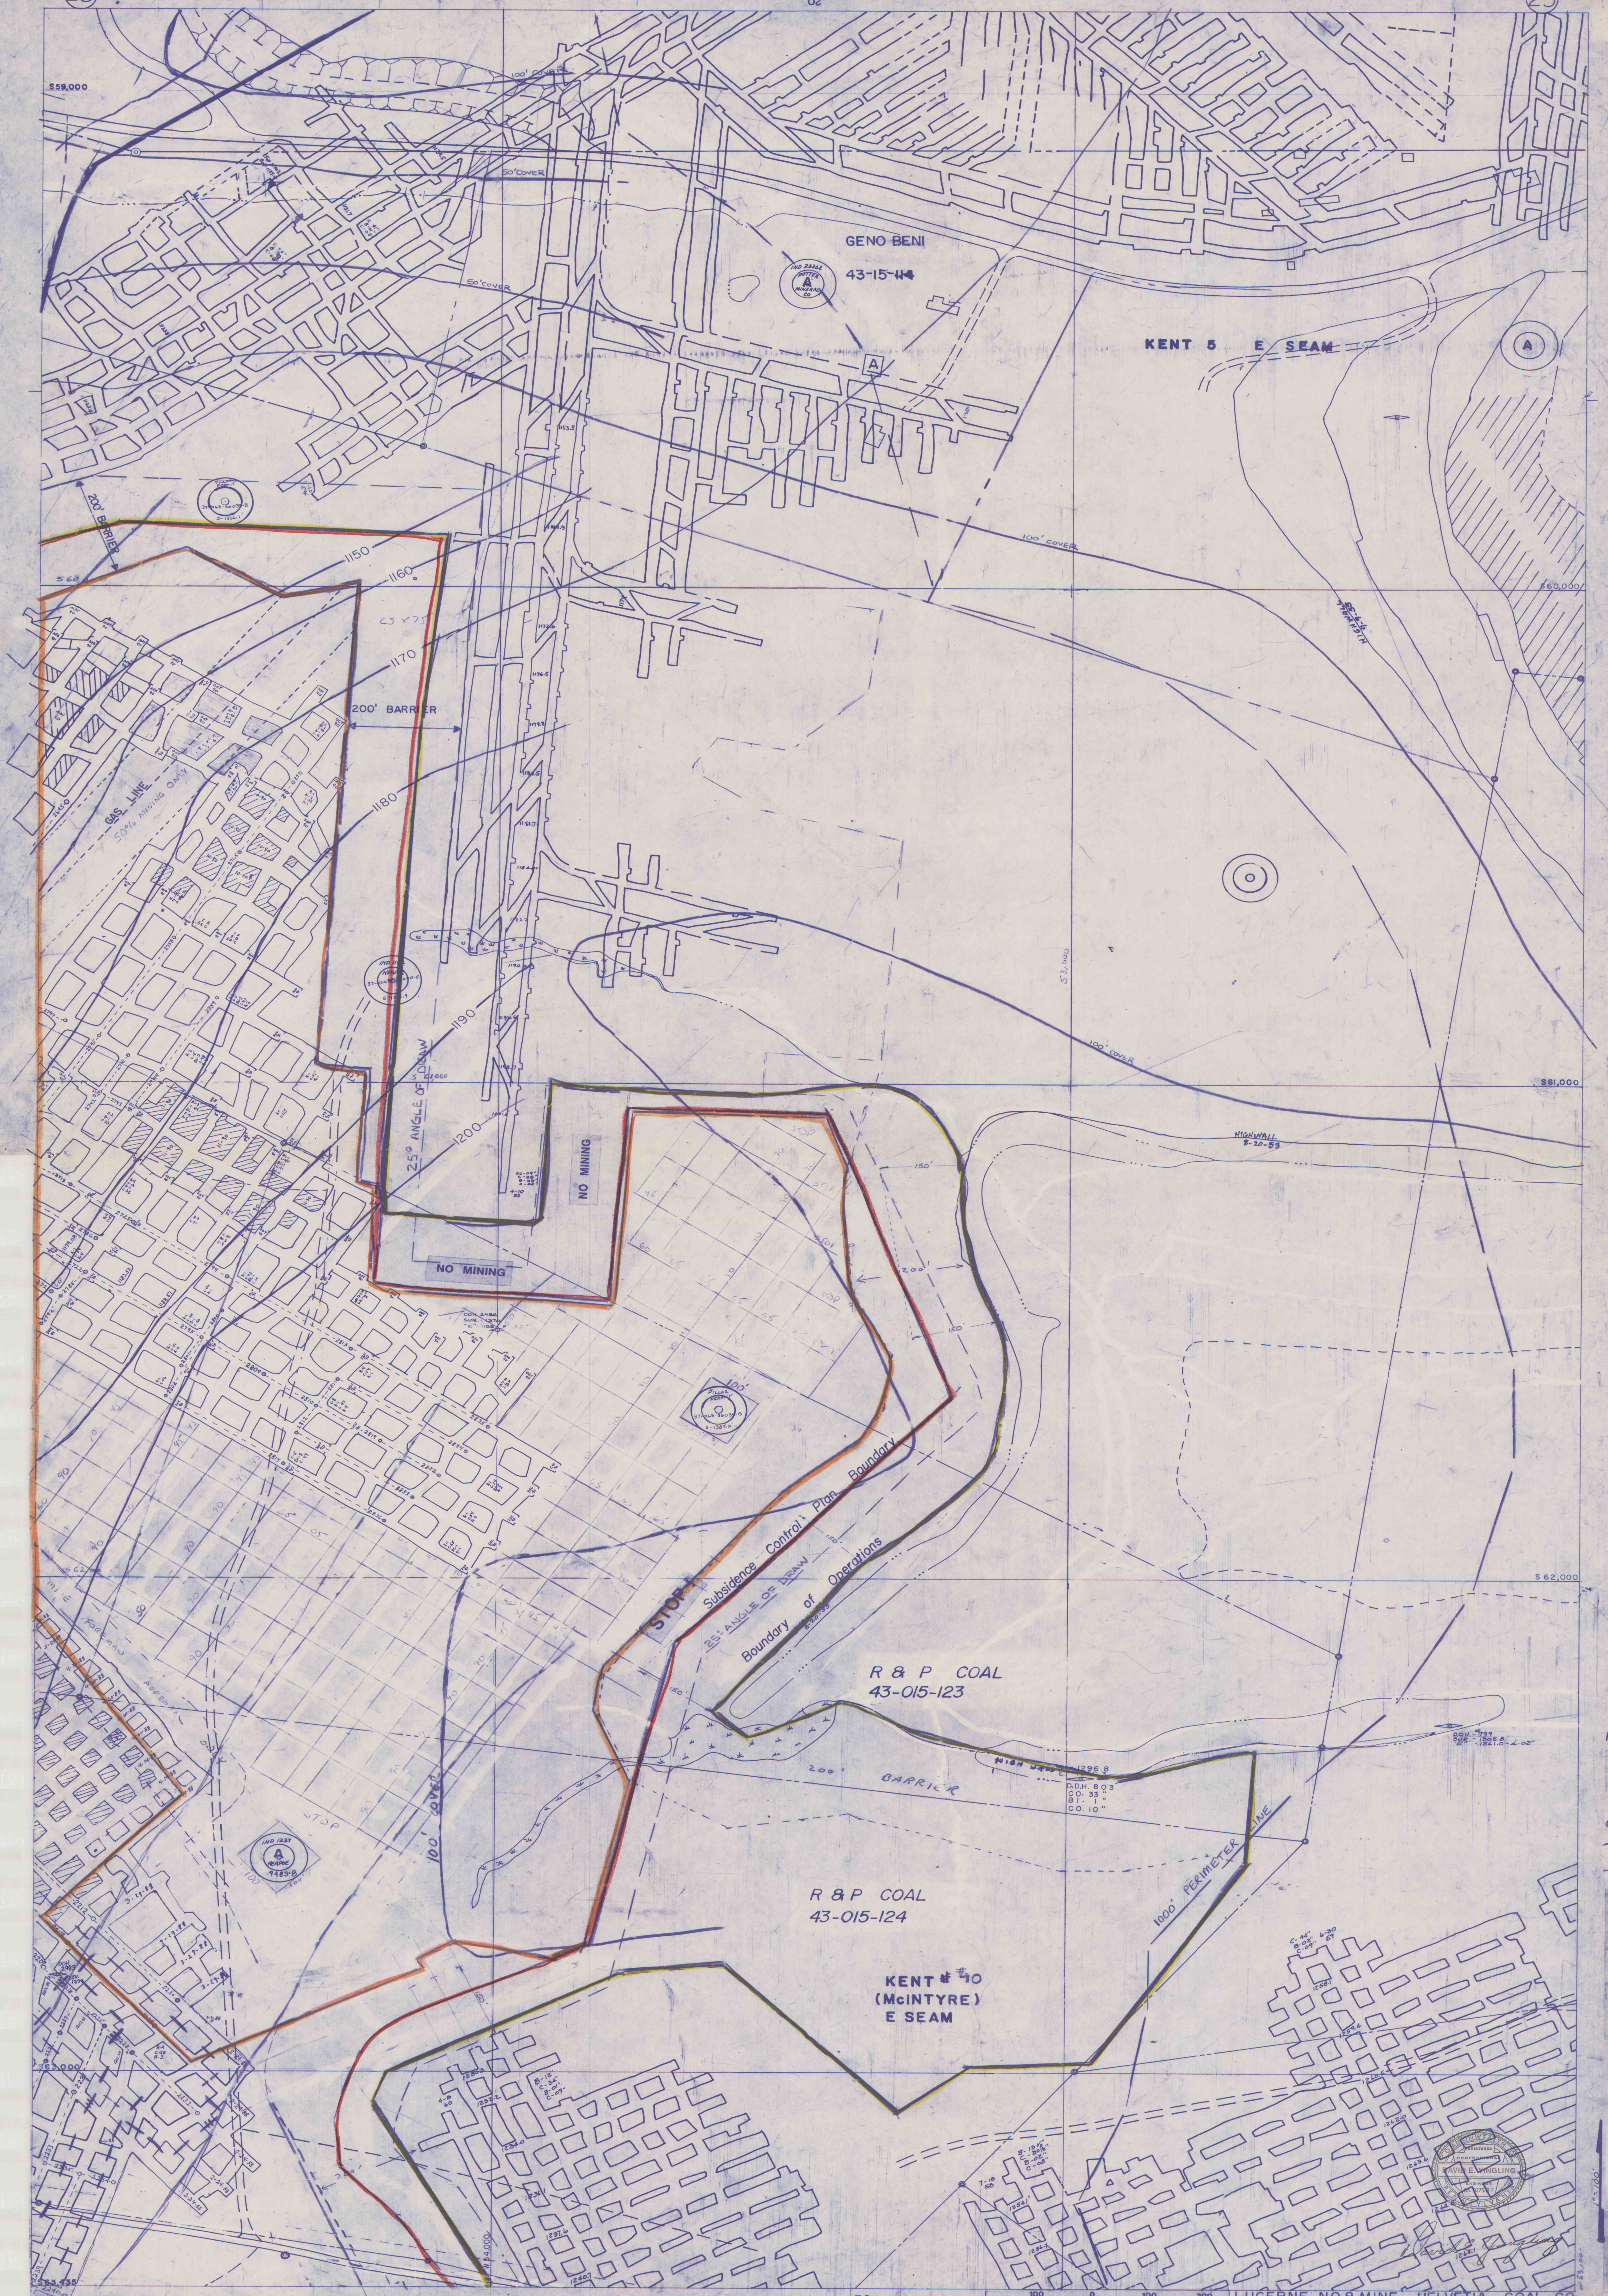

36-04597 352-2 UPPER FREEPORT SEAM

LUCERNE NO. 8 MINE - HELVETIA COAL CO.
YOUNG TWP. - INDIANA CO. - PA.

POSTED 1-1-91
CONTEMPLATED MINING
TO 7-1-91