


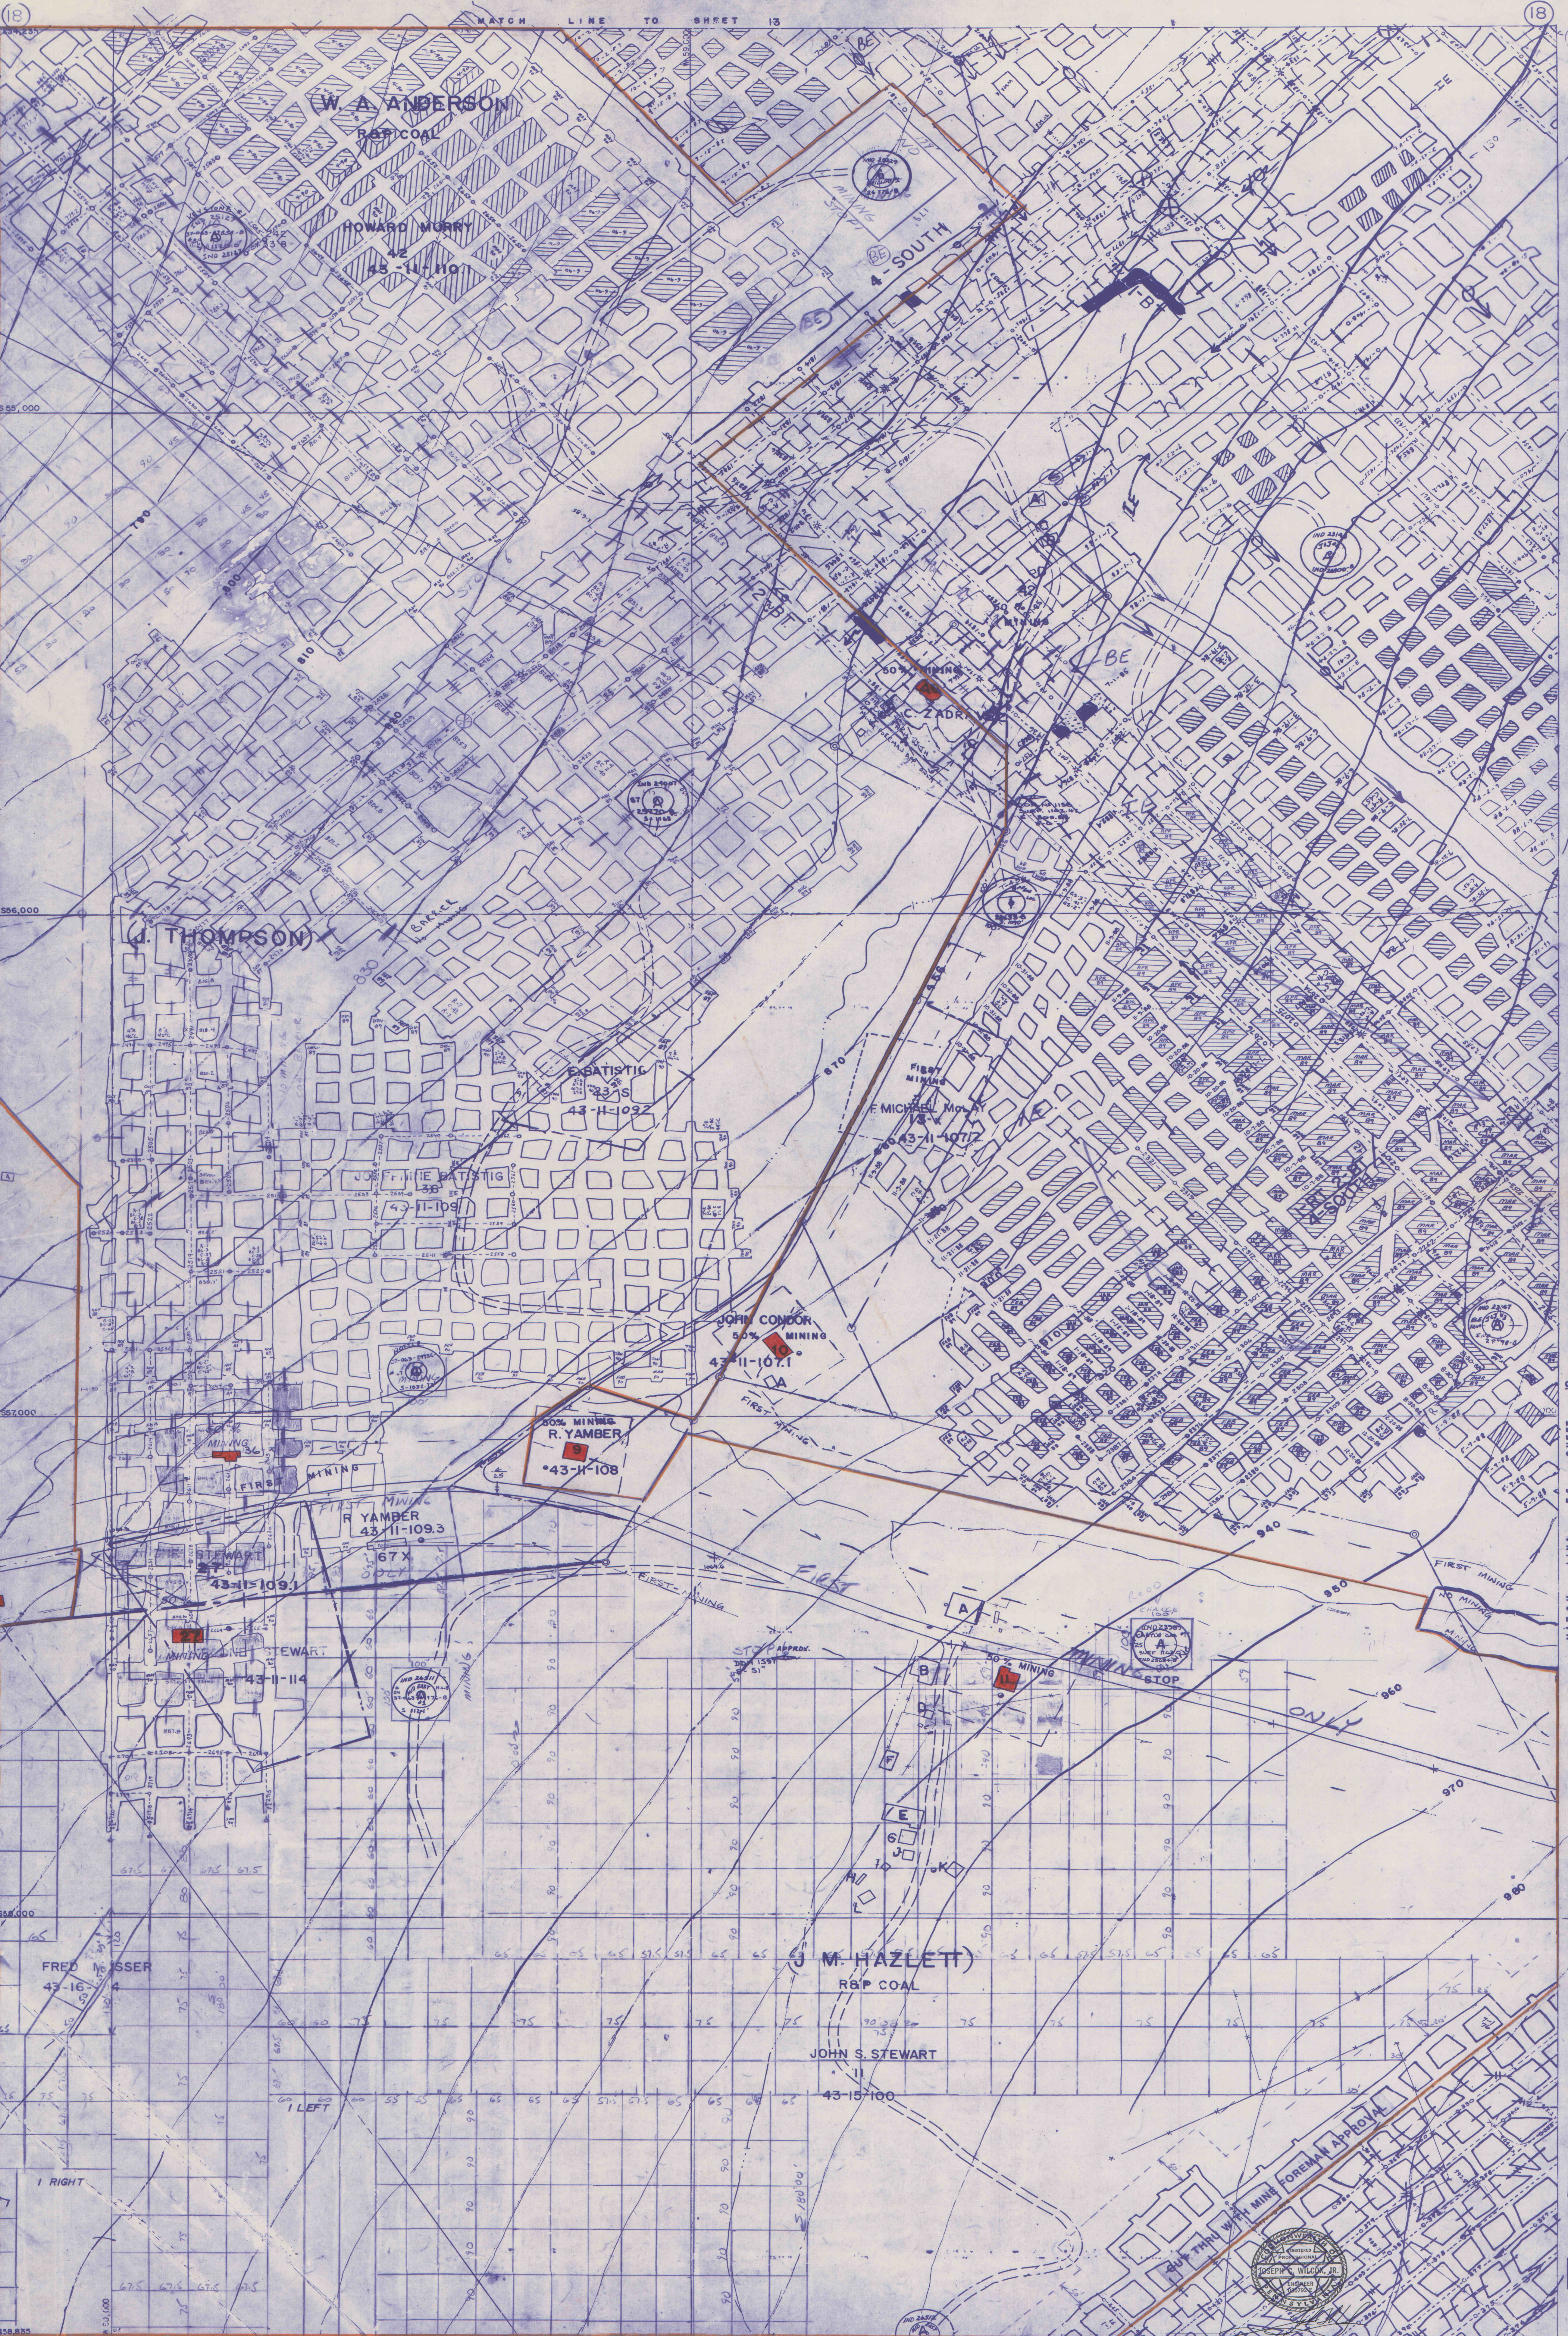

LUCERNE 8 - E SEAM

MATCH LINE TO SHEET 19

UPPER FREEPORT SEAM 360-7

CONTEMPLATED MINING 7-1-90 TO 1-1-91

POSTED