


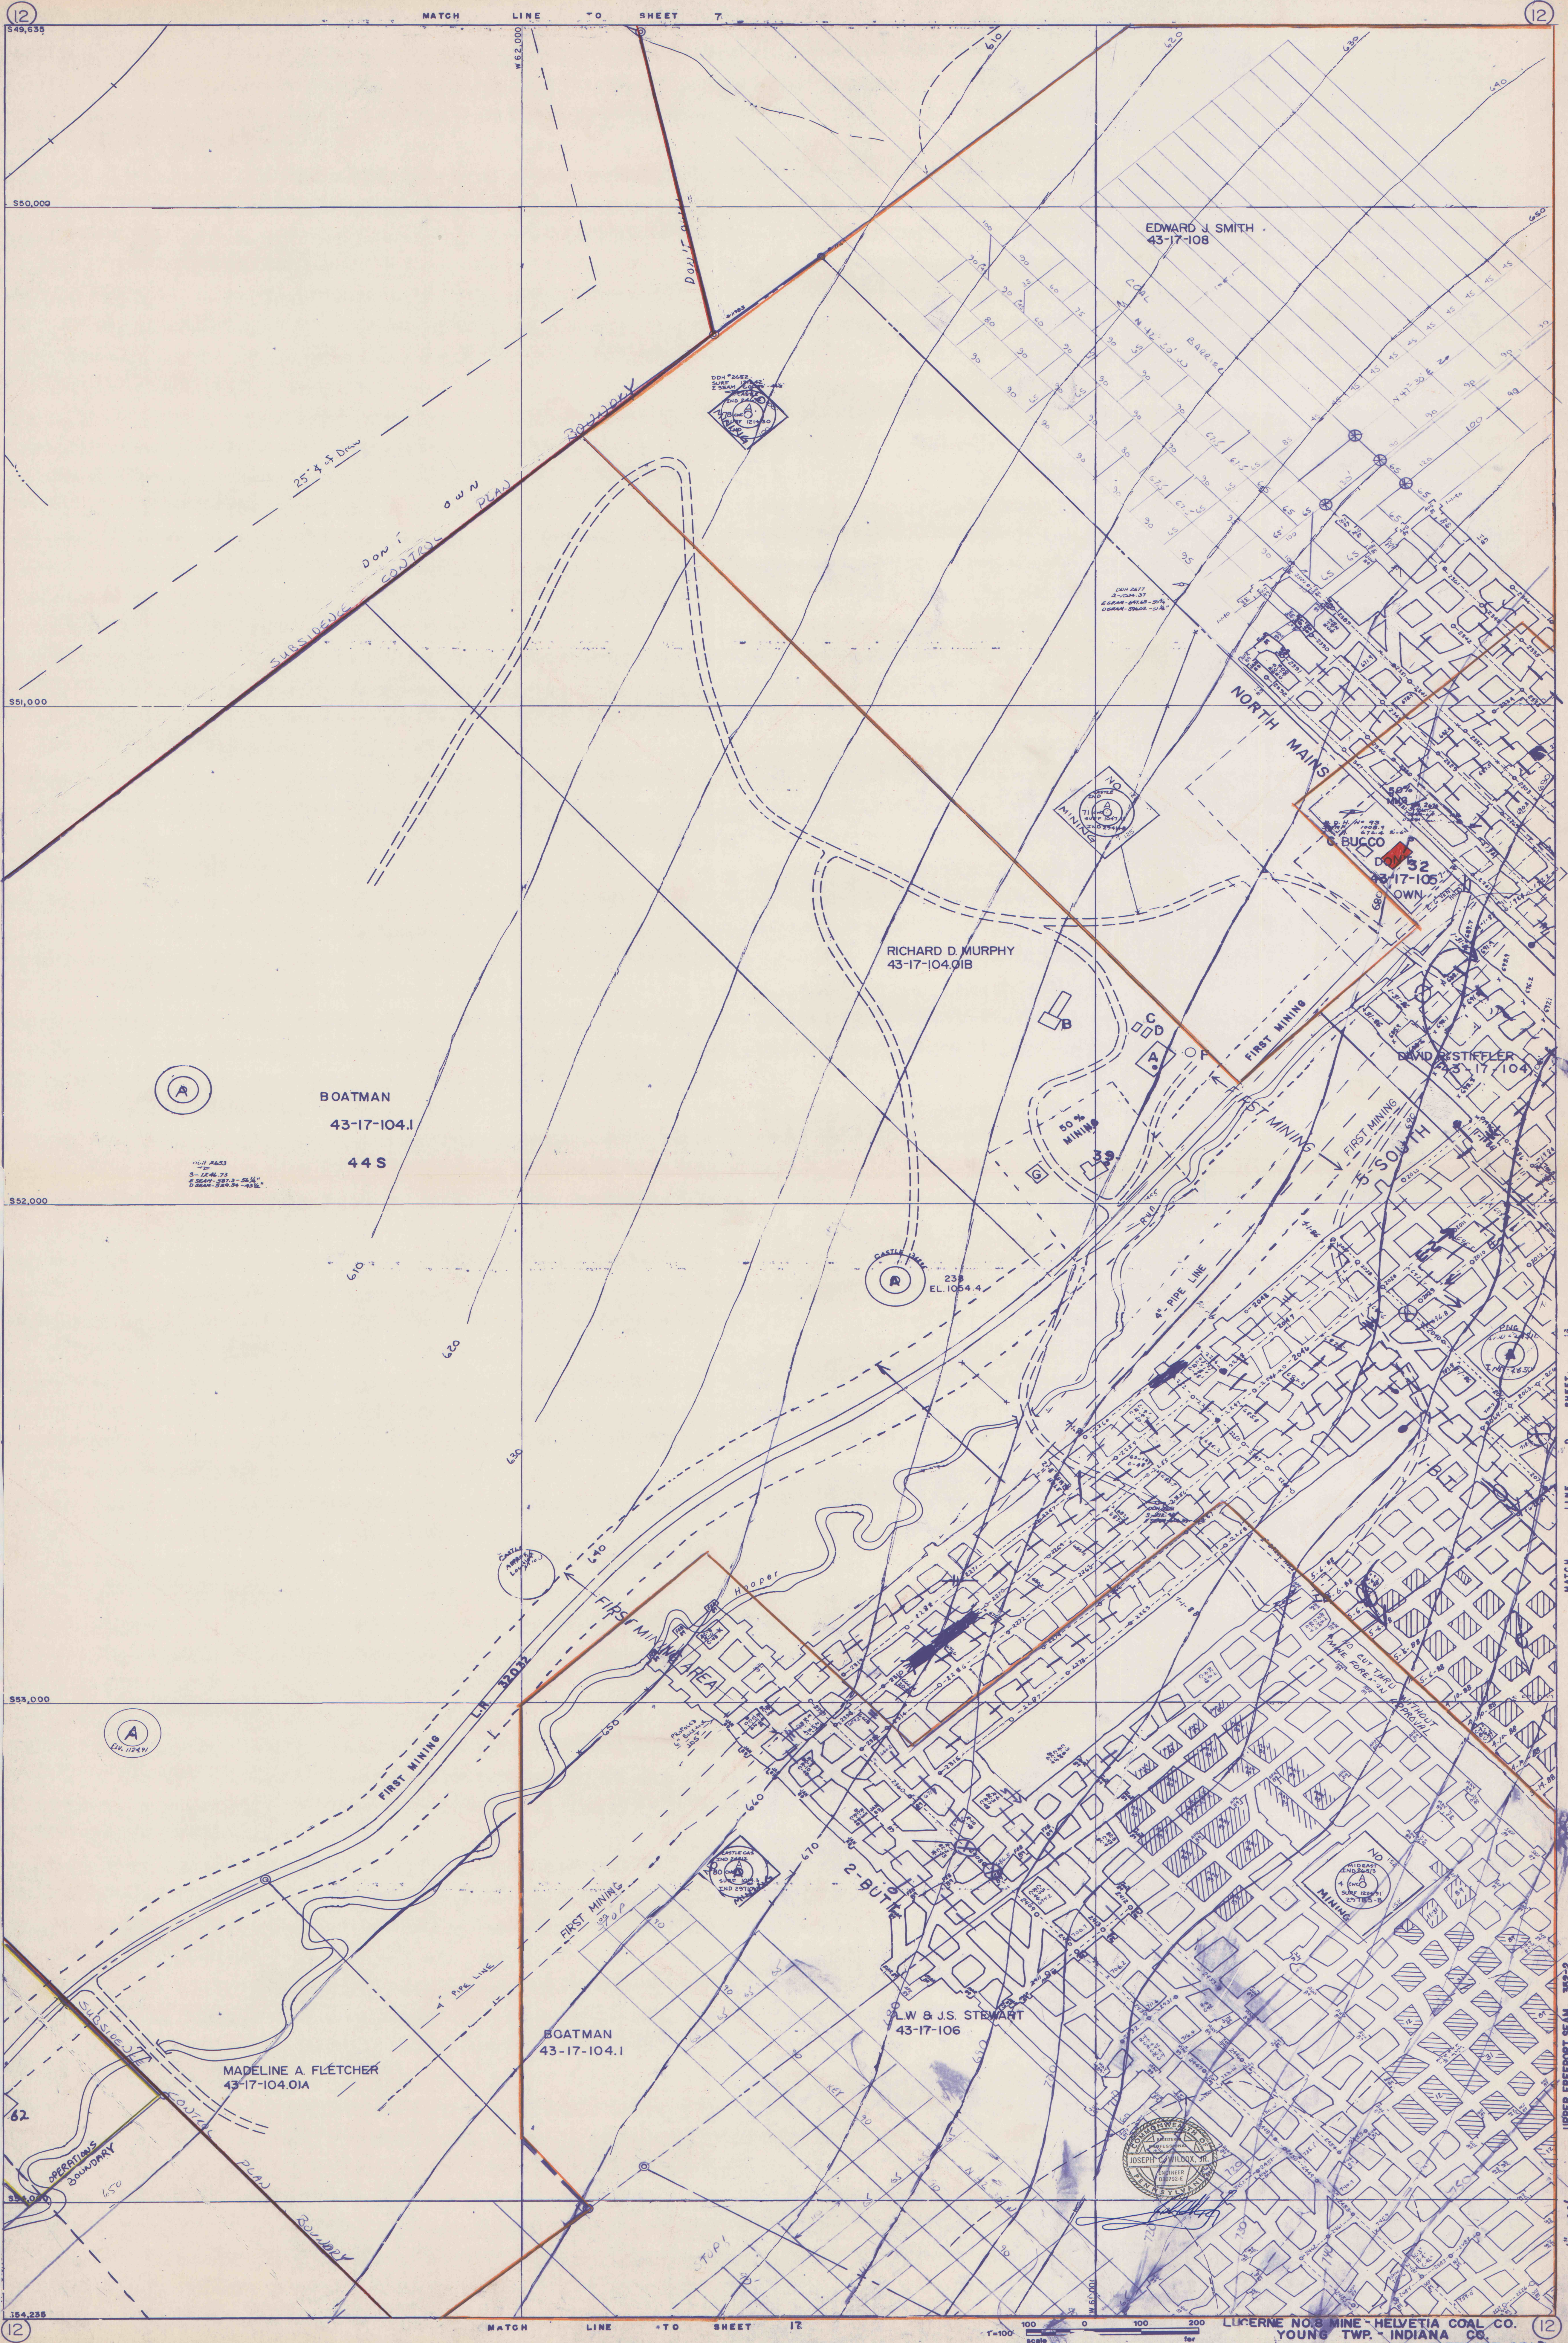

LUCERNE NO. 8 MINE - HELVETIA COAL CO.
YOUNG TWP. INDIANA CO.
04597, 352-2 UPPER FREEPORT SEAM

POSTED 1-1-90
CONTEMPLATED MINING 1-1-90 TO 7-1-90