


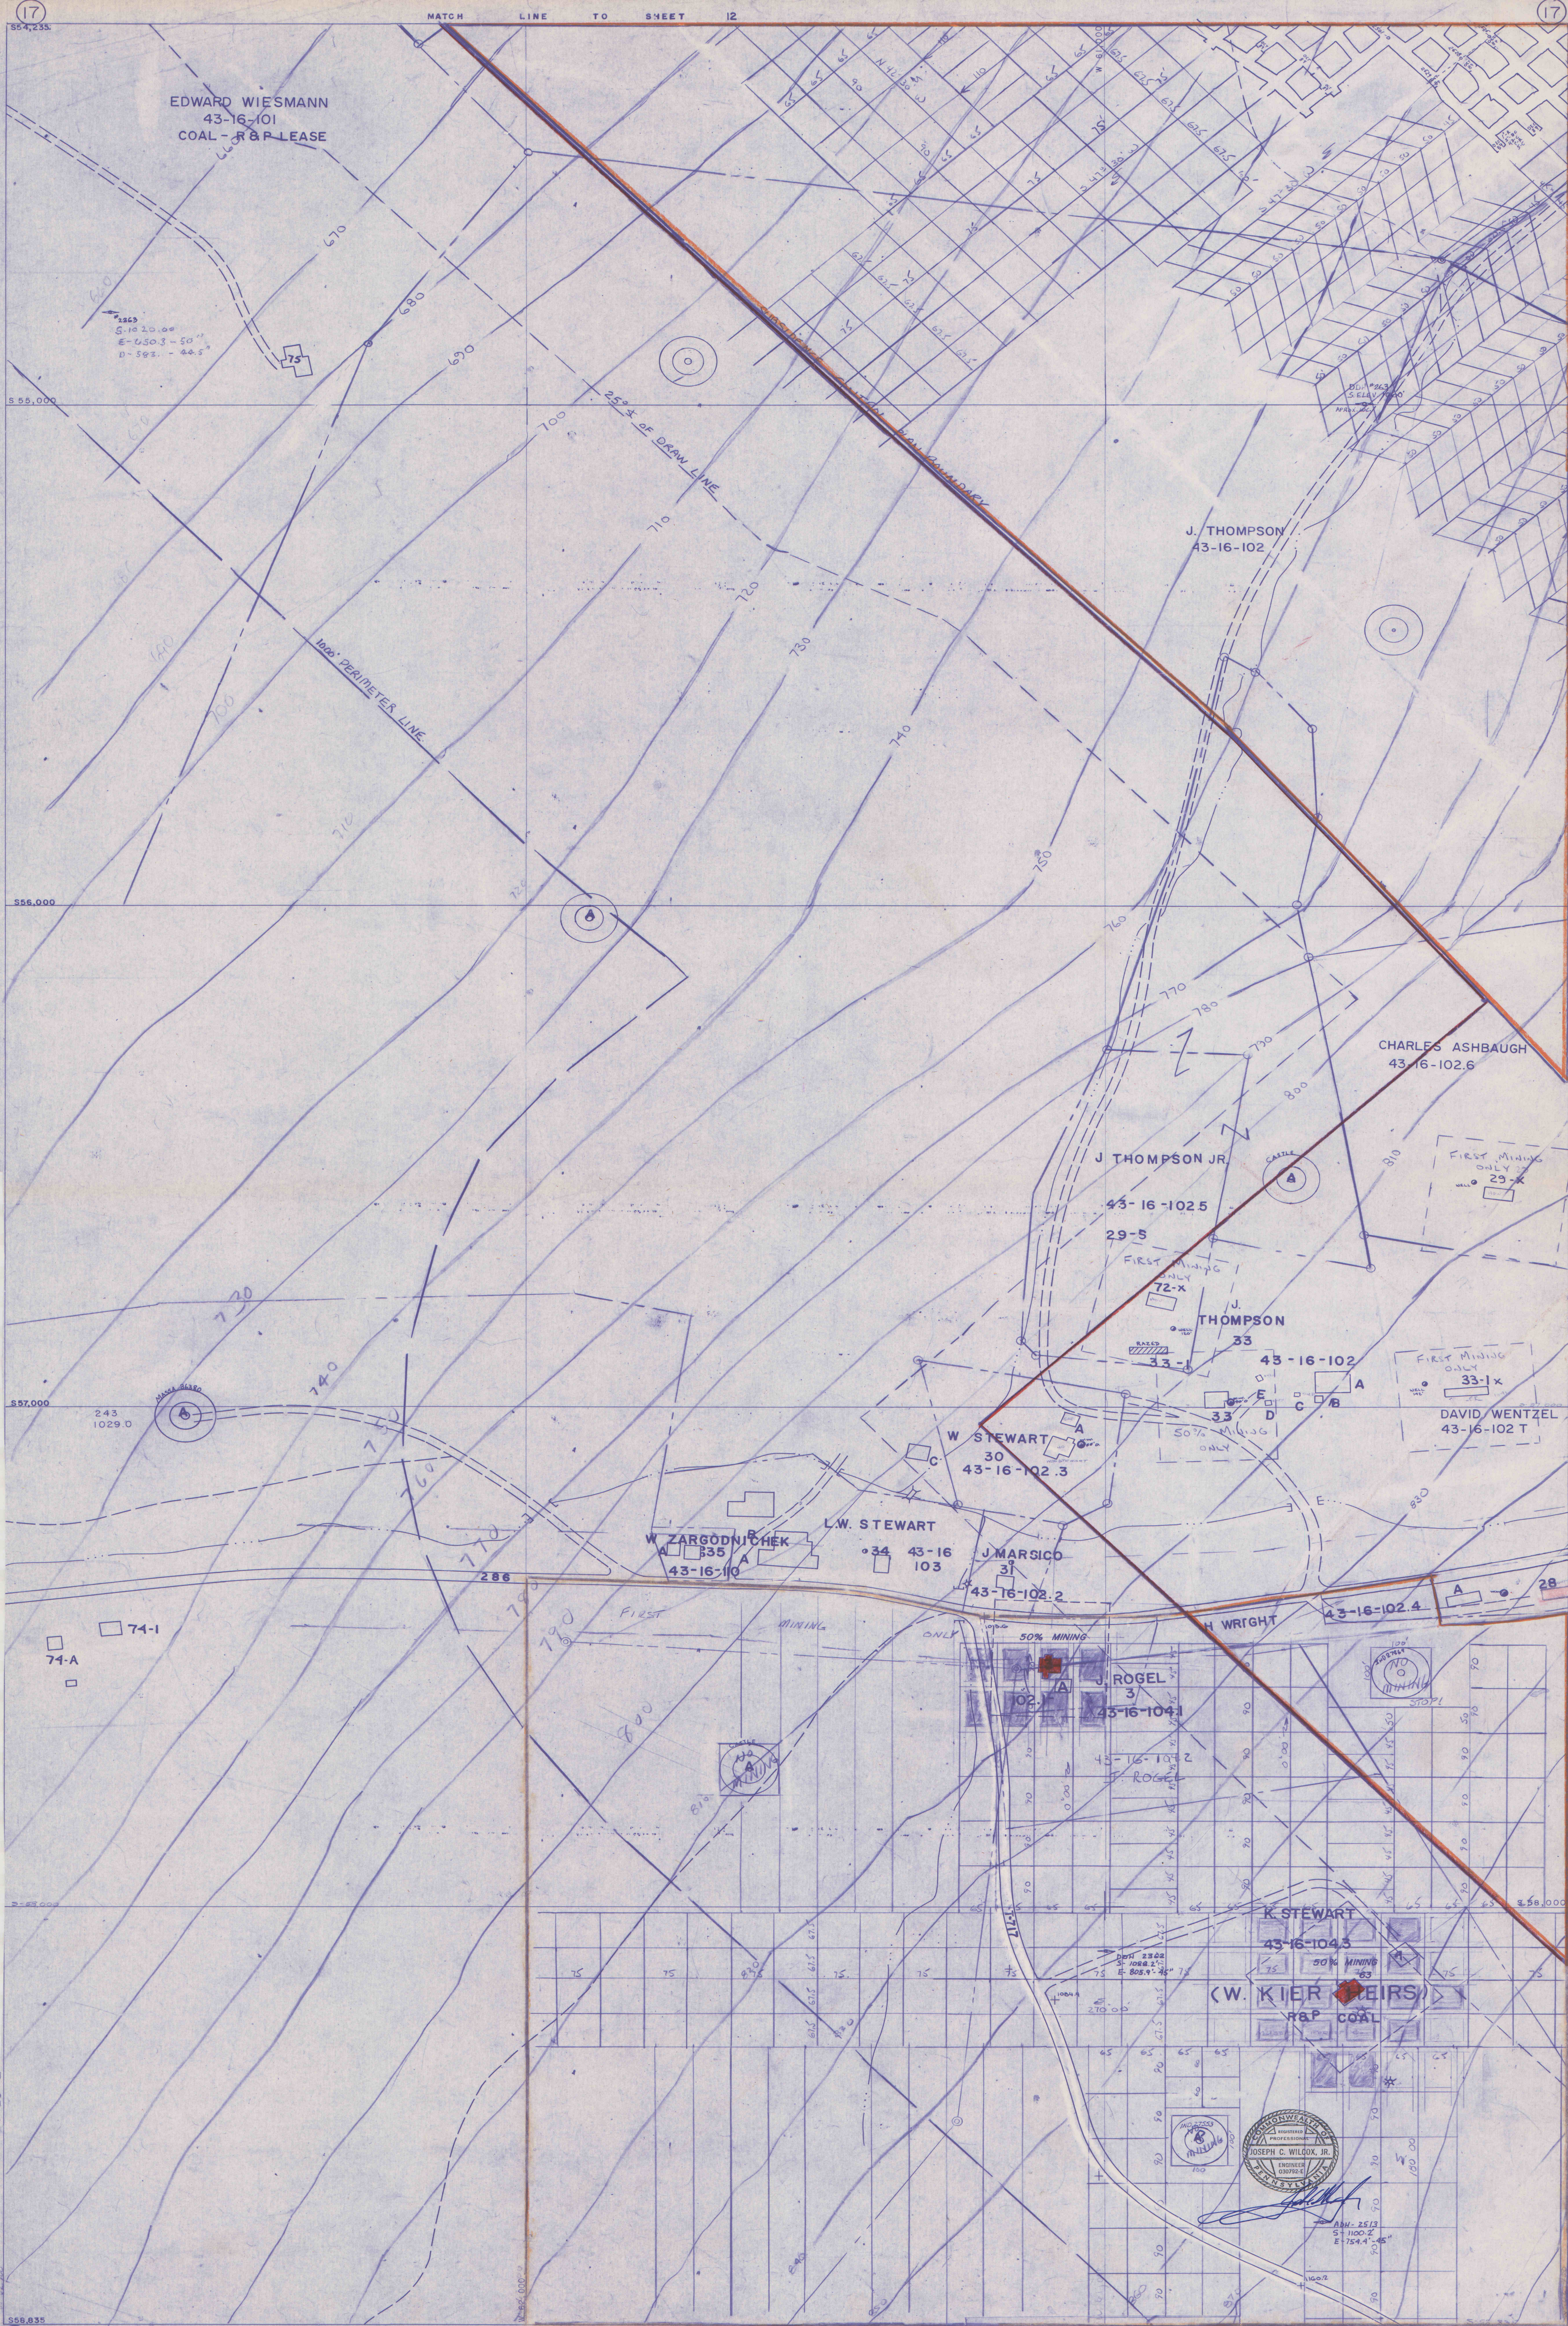

LUCERNE 8 — E SEAM

MATCH LINE TO SHEET 18

UPPER FREEPORT SEAM

POSTED 1-1-90

CONTEMPLATED MINING 1-1-90 TO 7-1-90

LUCERNE NO. 8 MINE - HELVETIA COAL CO.
YOUNG TWP. - INDIANA CO.