


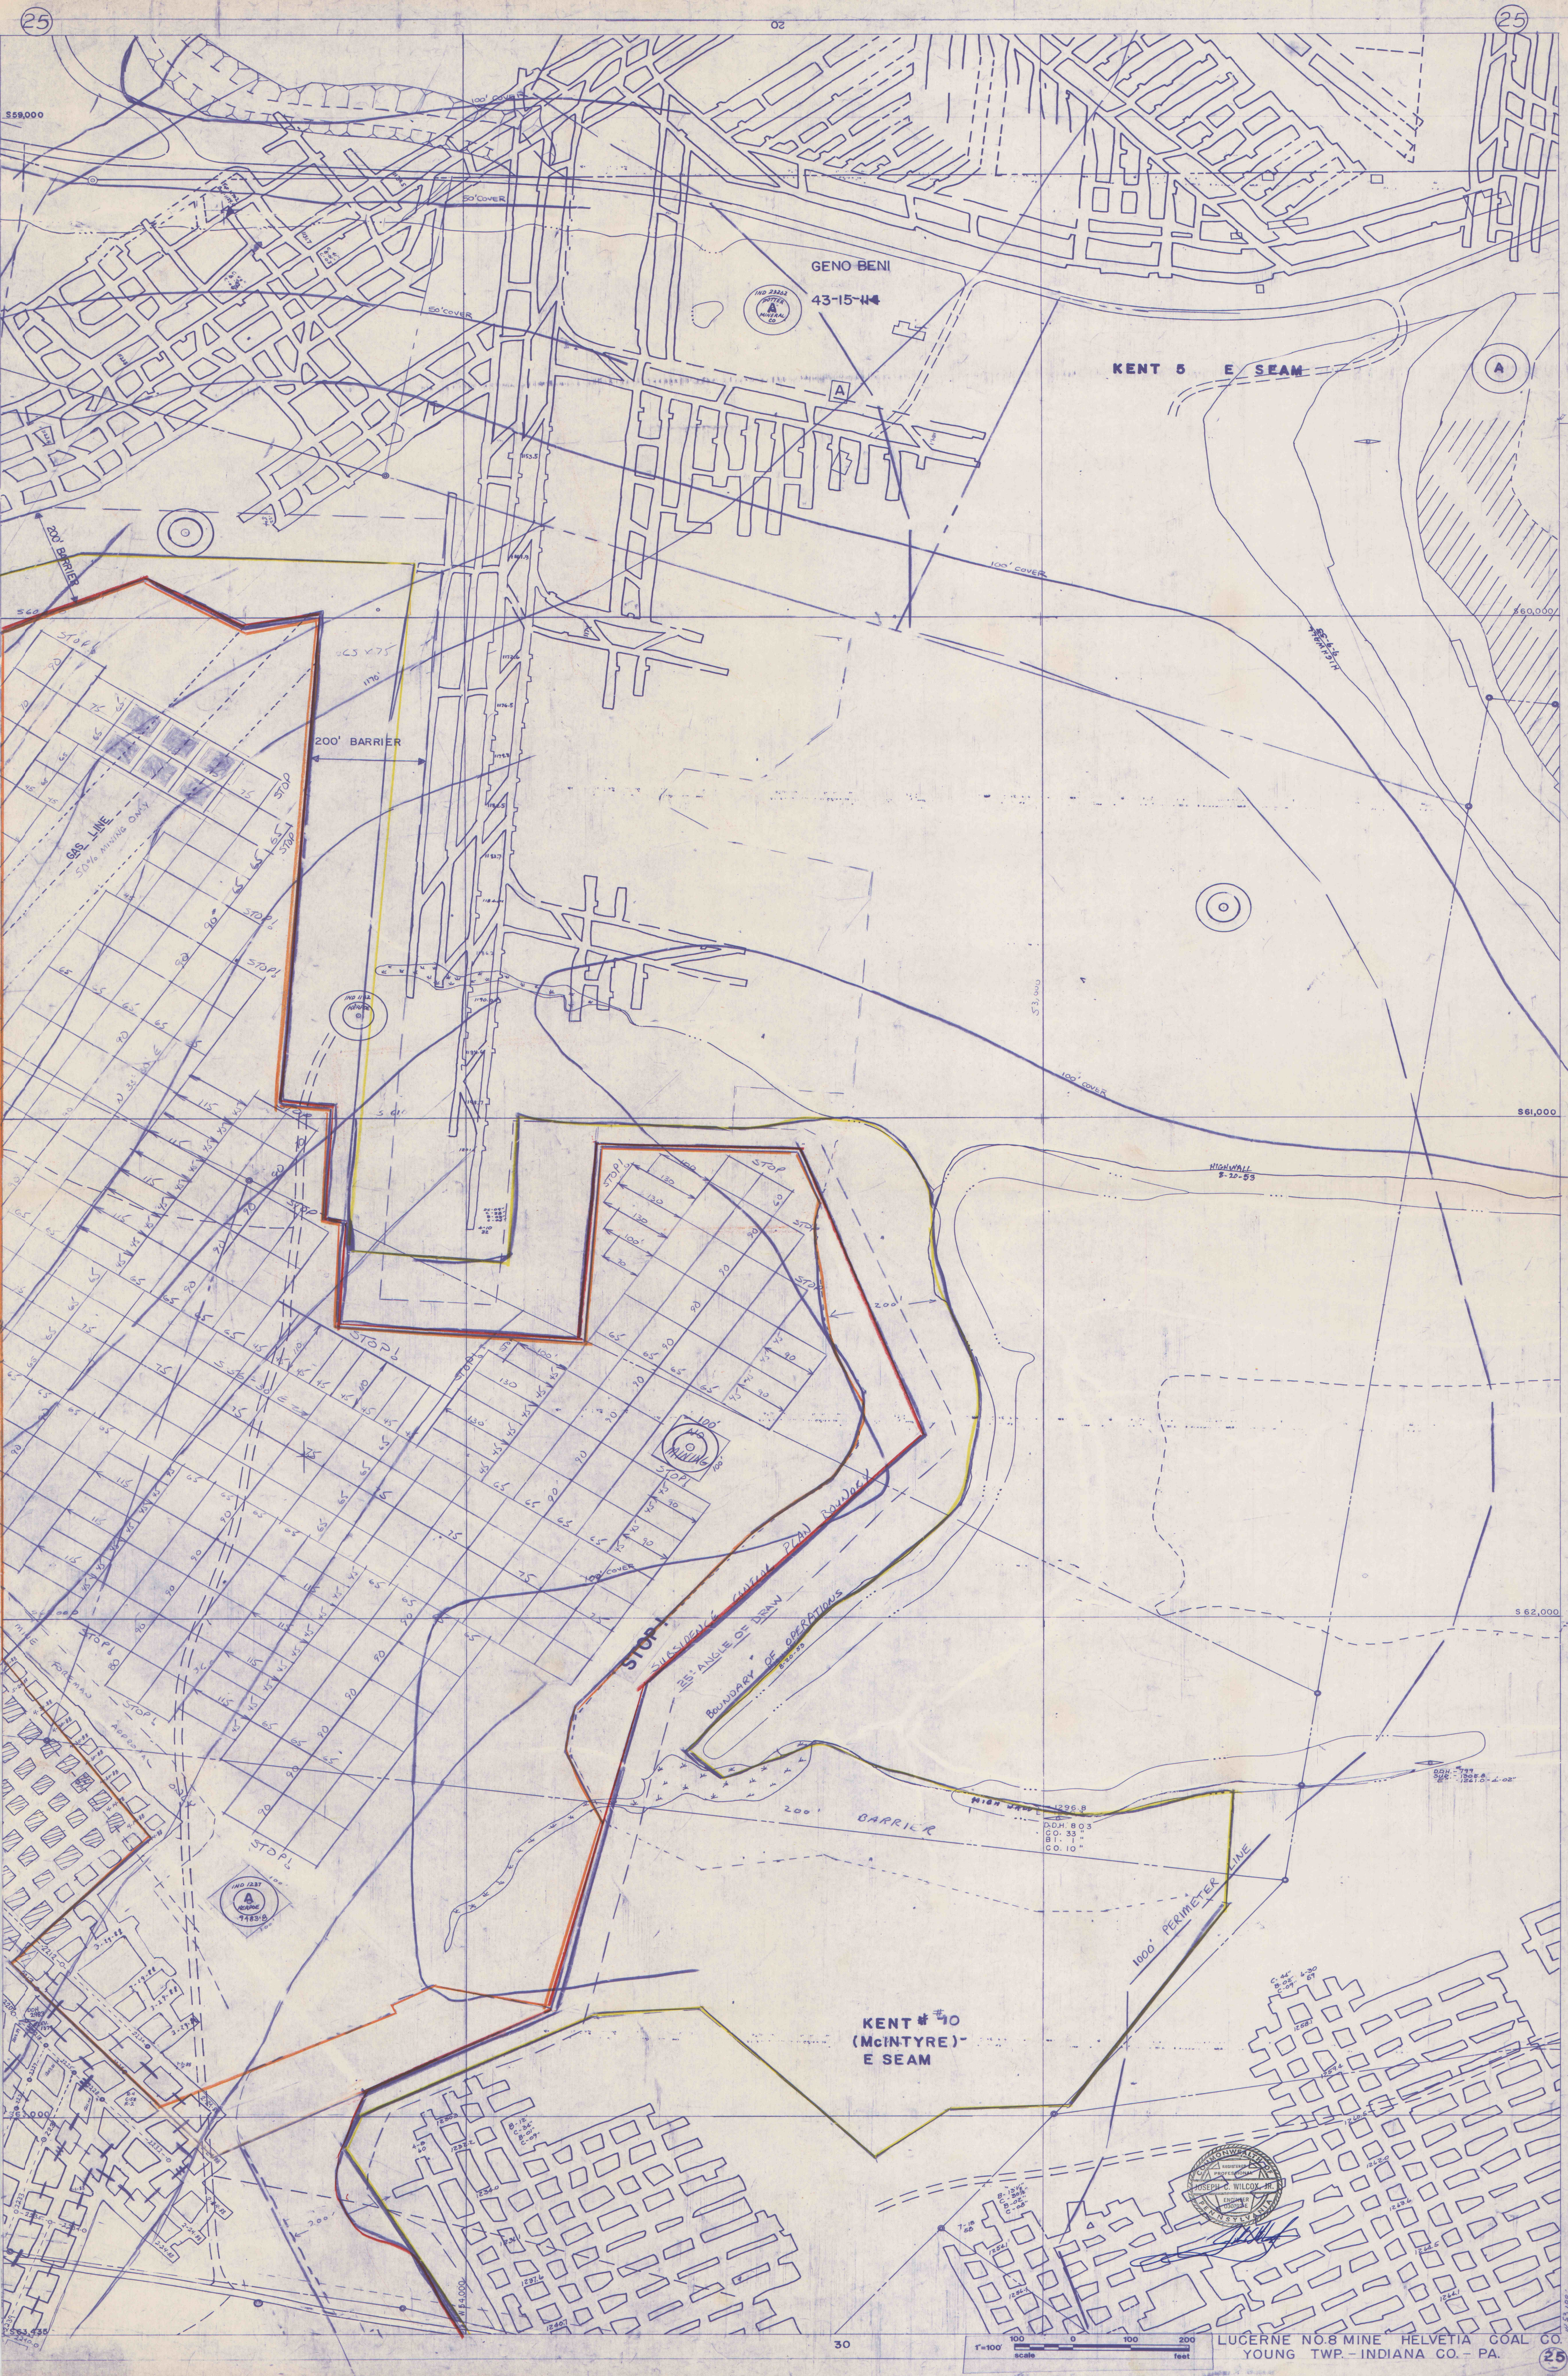

POSTED 1-1-90 TO 7-1-90 CONTEMPLATED MINING

LUCERNE NO. 8 MINE HELVETIA COAL CO. YOUNG TWP. - INDIANA CO. - PA.