


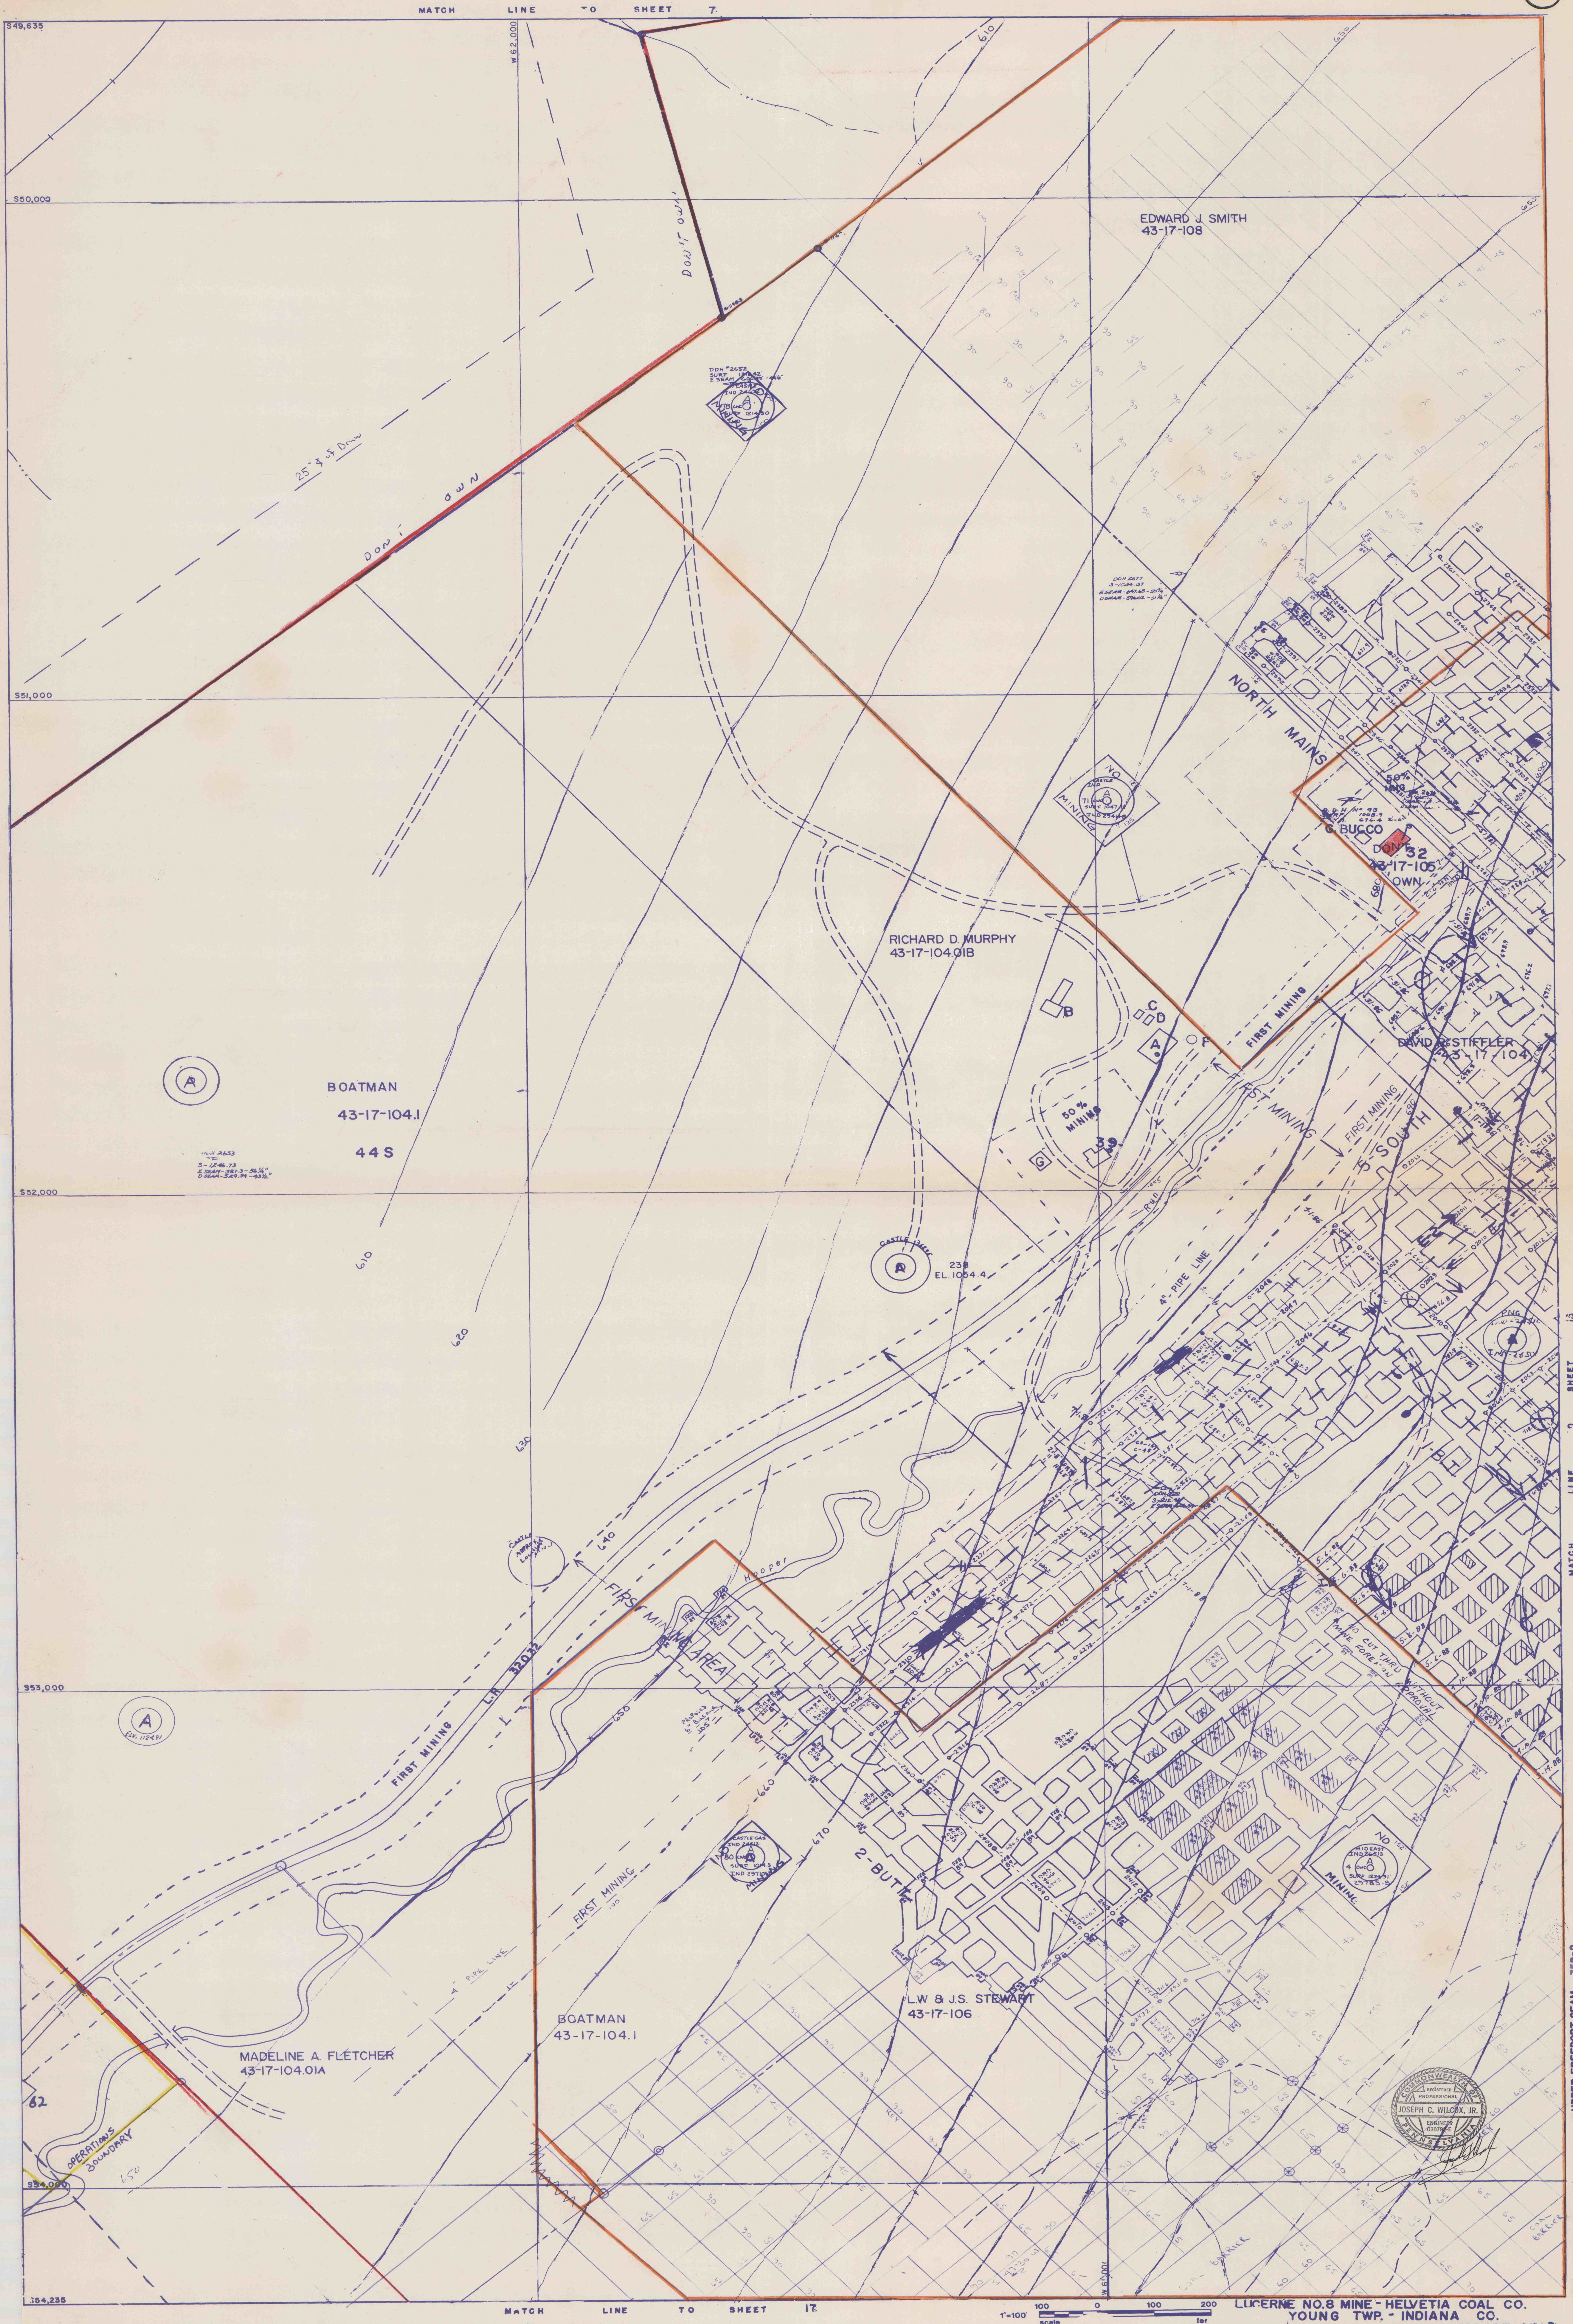

POSTED 7-1-89
CONTEMPLATED MINING 7-1-89 TO 1-1-90
UPPER FREEPORT SEAM 352-2
1" = 100'