


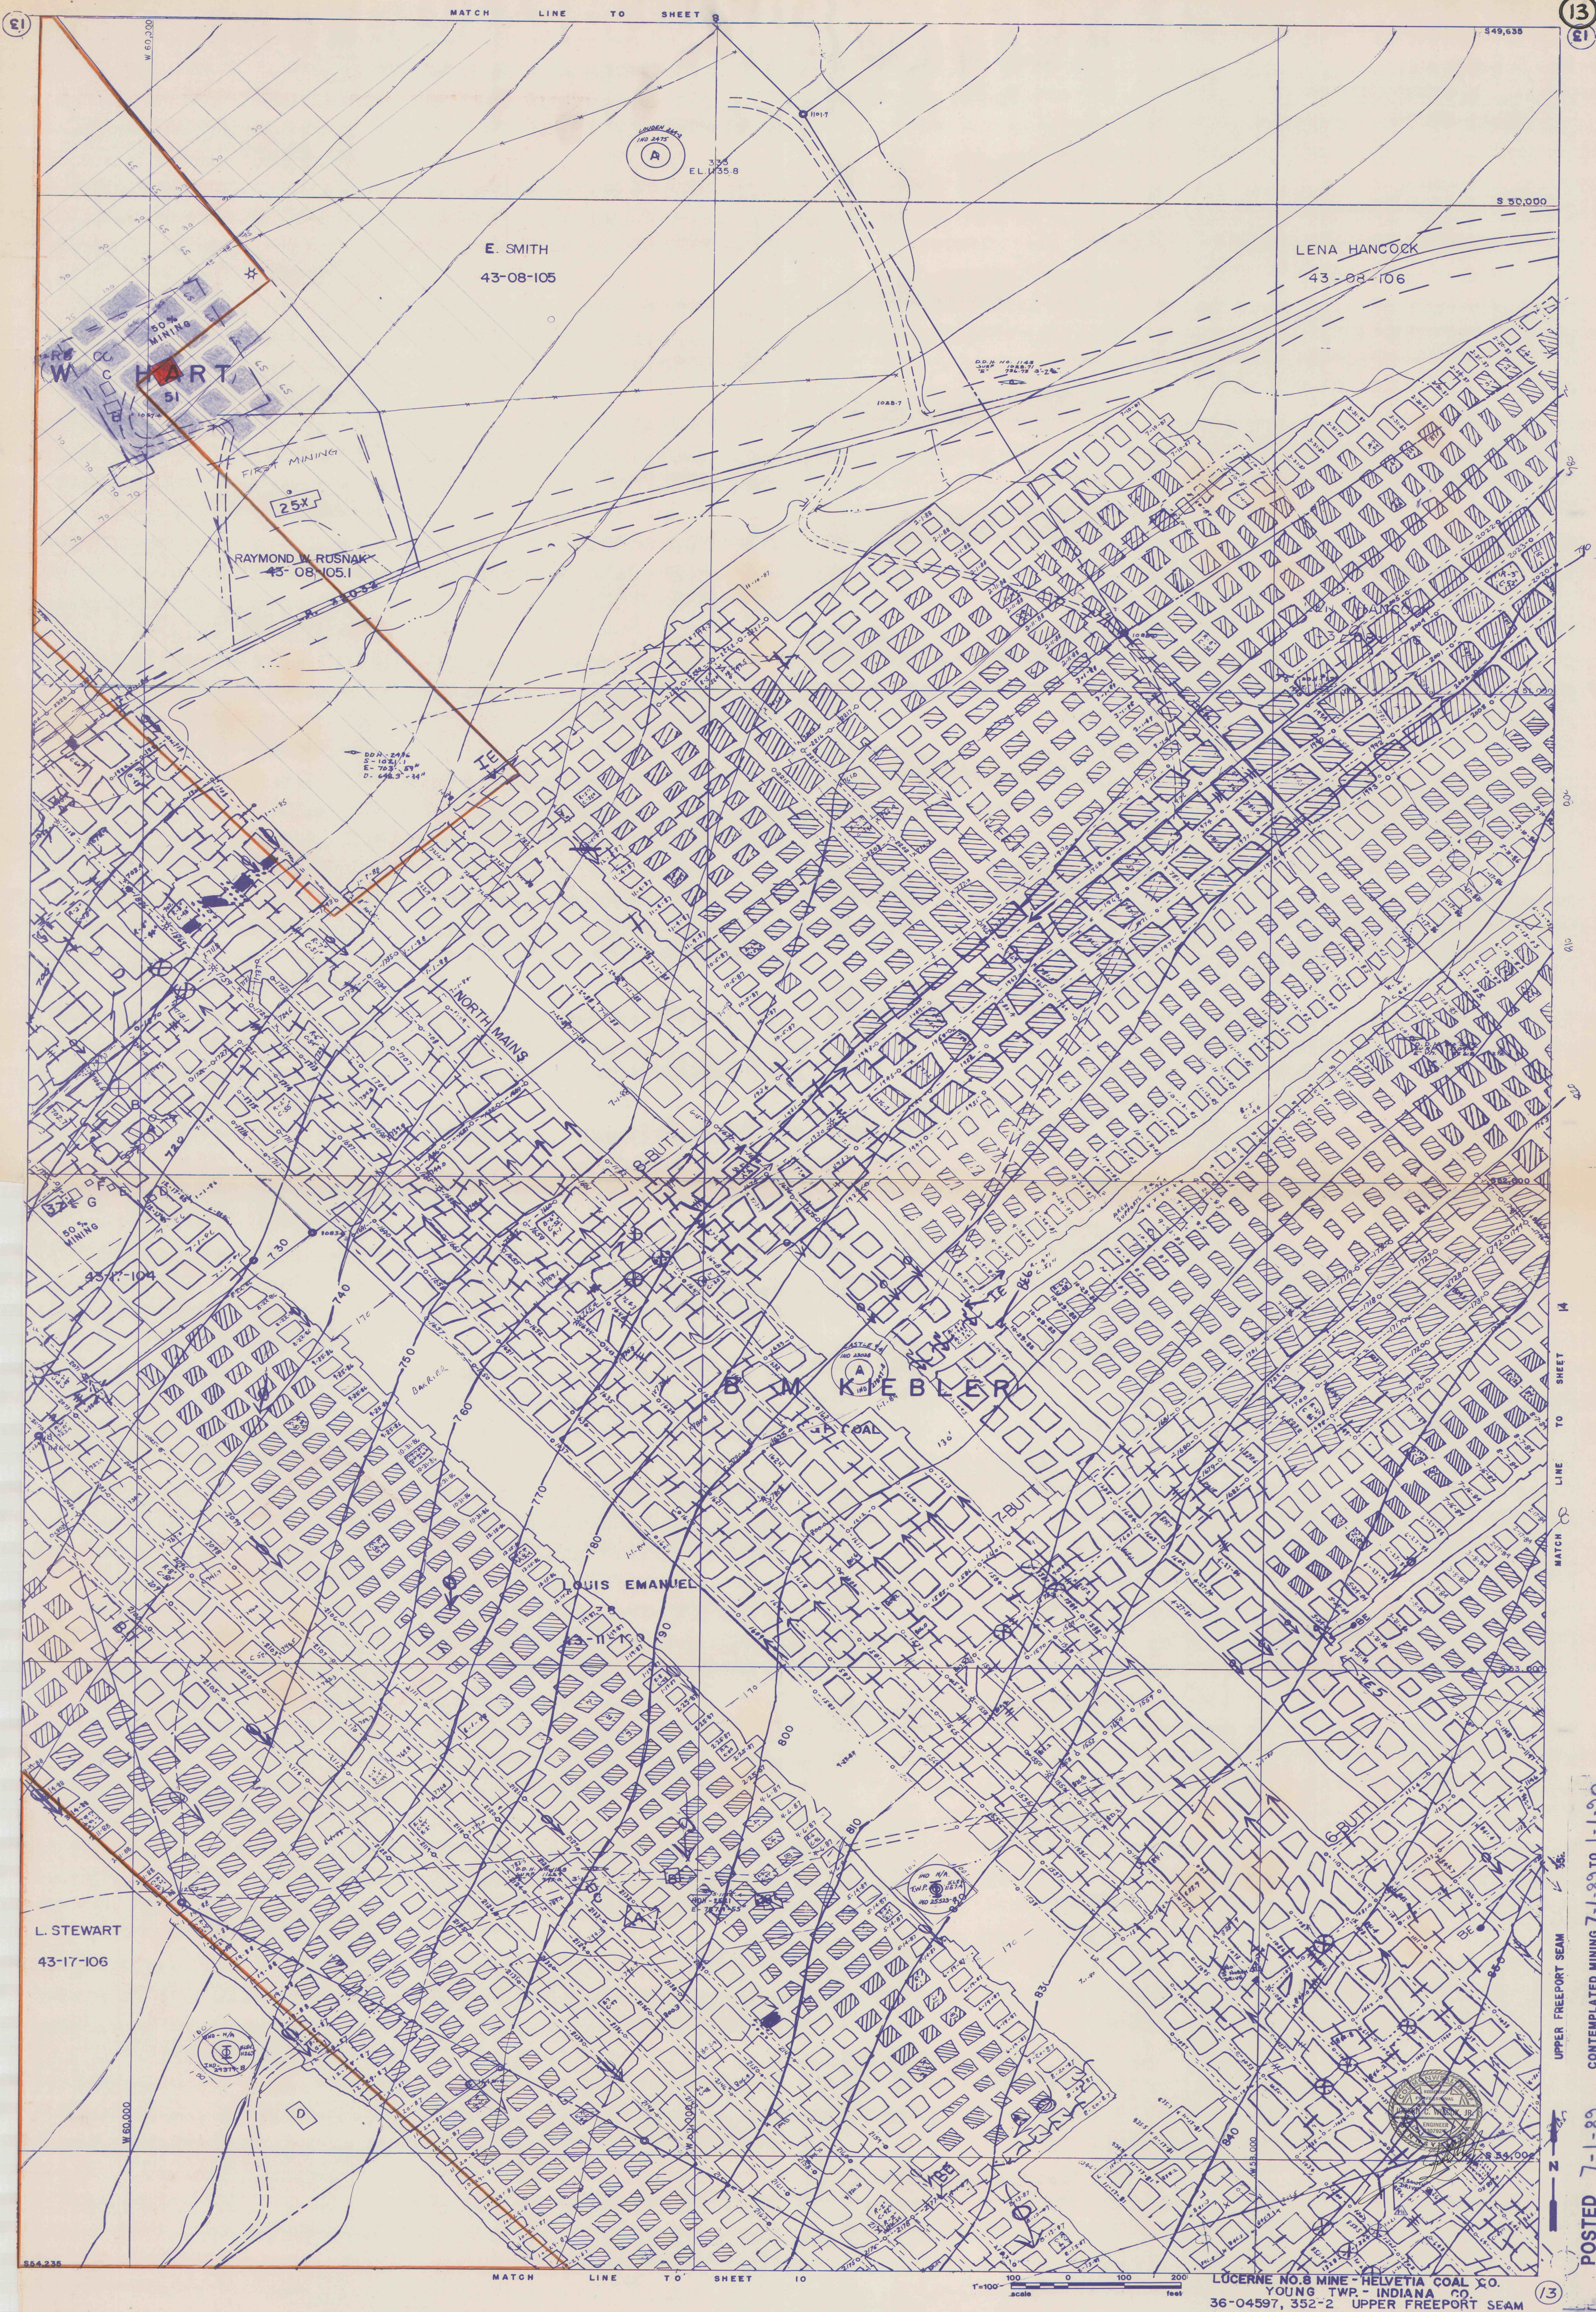

E. SMITH  
43-08-105

LENA HANCOCK  
43-08-106

RAYMOND W. RUSNAK  
43-08-105.1

L. STEWART  
43-17-106

B. M. KEBLER

LOUIS EMANUEL

LUCERNE NO. 8 MINE - HELVETIA COAL CO.  
YOUNG TWP. - INDIANA CO.  
36-04597, 352-2 UPPER FREEPORT SEAM

POSTED 7-1-89  
CONTEMPLATED MINING 7-1-89 TO 1-1-90

UPPER FREEPORT SEAM

MATCH LINE TO SHEET 14

MATCH LINE TO SHEET 10

1"=100' scale

13